5-00-032- B
05-00-032-000-040

PPN 05-00-032-000-040

MAP Pg 05-00-032B
44035

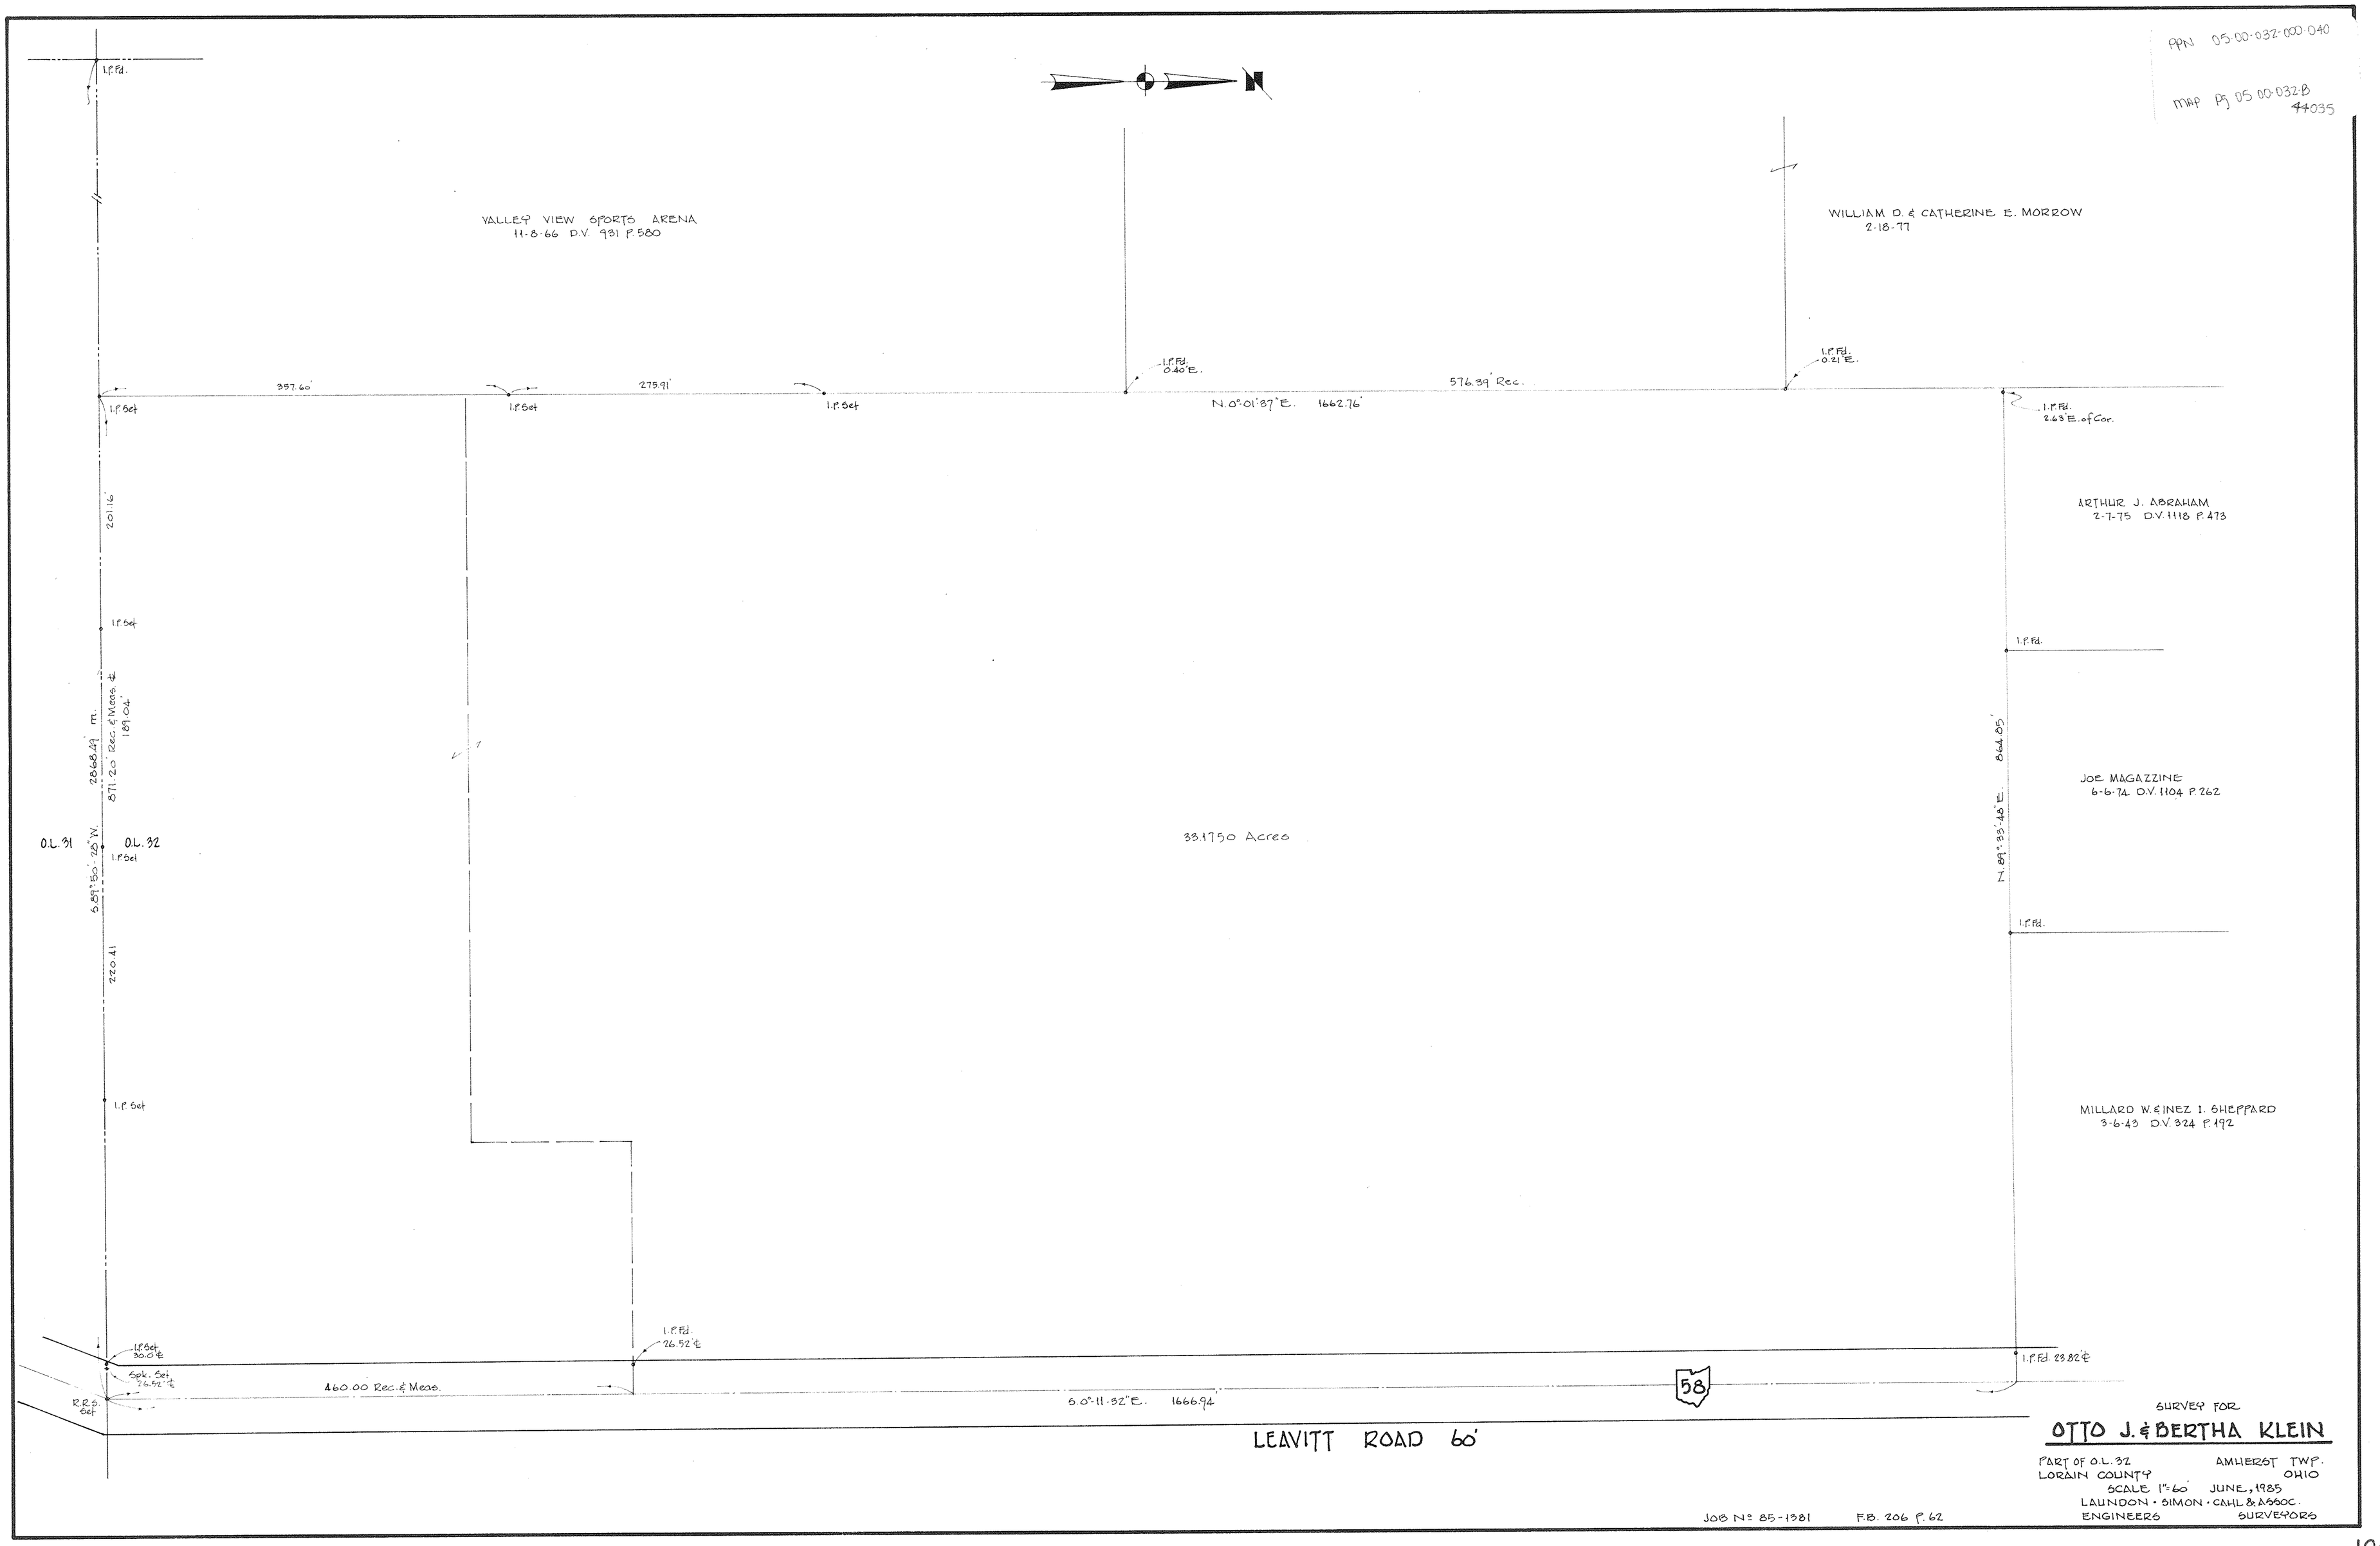

SURVEY FOR

OTTO J. & BERTHA KLEIN

PART OF O.L. 32 — AMHERST TWP.
LORAIN COUNTY — OHIO
SCALE 1" = 60' — JUNE, 1985
LAUNDON · SIMON · CAHL & ASSOC.
ENGINEERS — SURVEYORS

JOB No 85-1381 — F.B. 206 P. 62