07-00-039-000-022
07-00-039-000-023
7-E

PPN 07-00-039-000-022
023

MAP PG 7-E 4403C

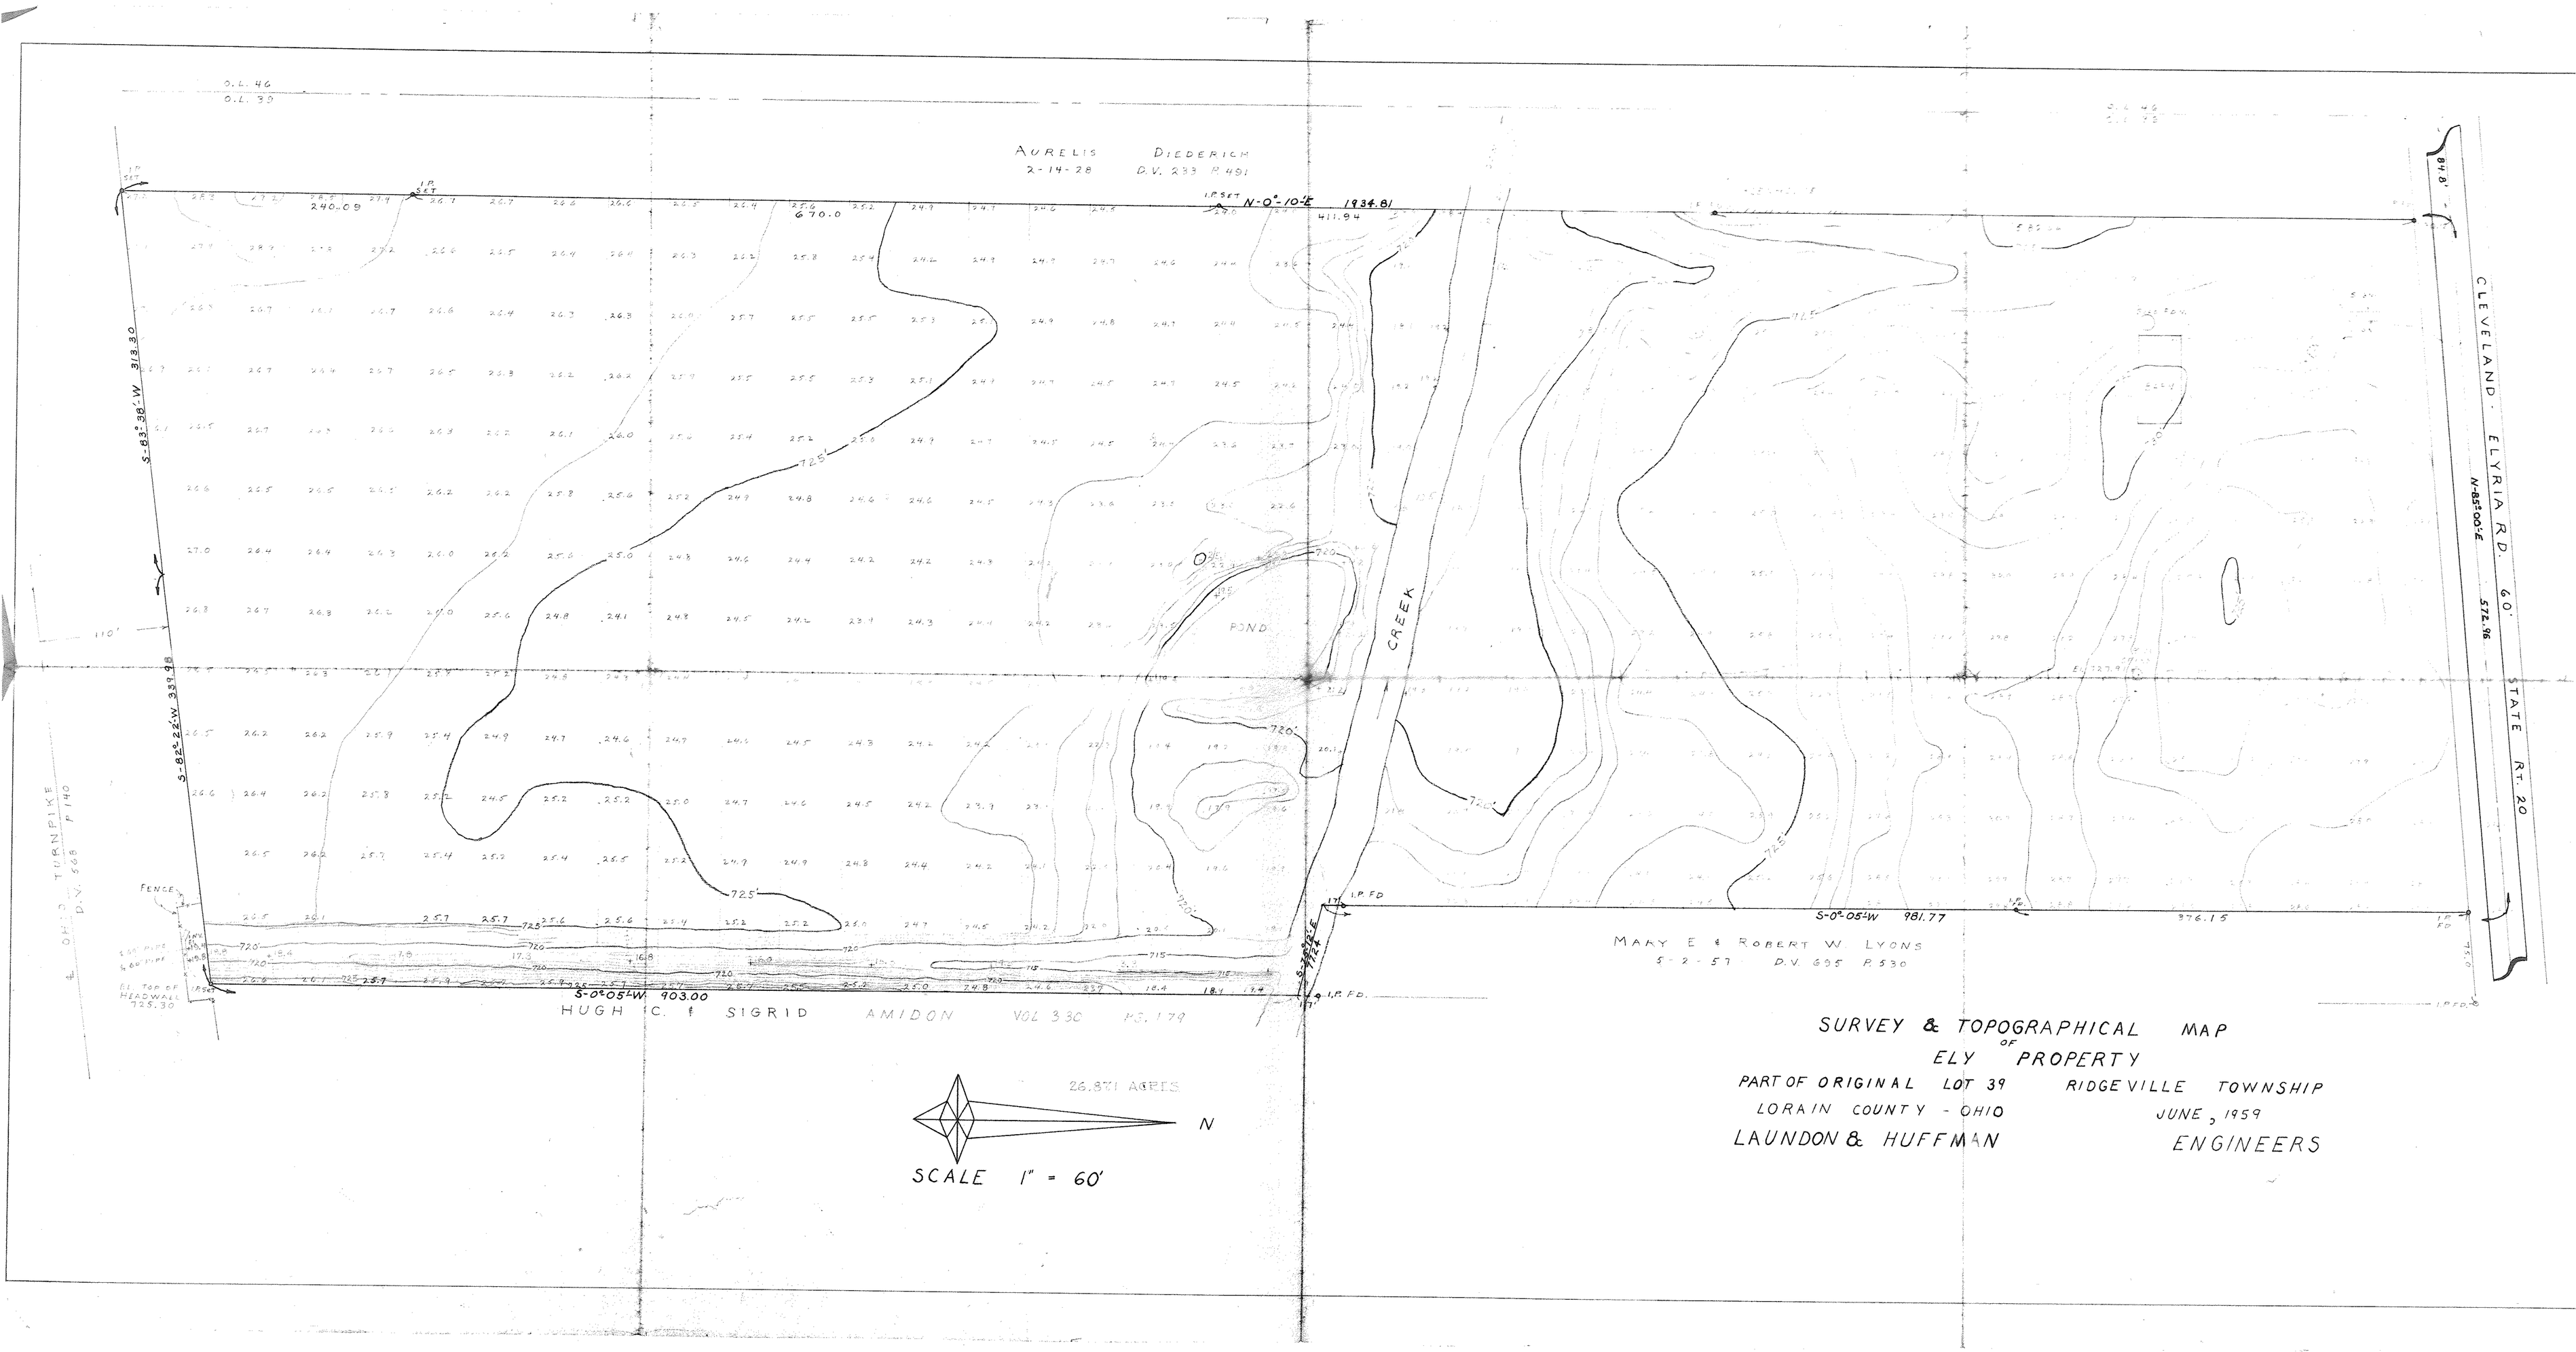

SURVEY & TOPOGRAPHICAL MAP
OF
ELY PROPERTY

PART OF ORIGINAL LOT 39 RIDGEVILLE TOWNSHIP
LORAIN COUNTY - OHIO JUNE, 1959

LAUNDON & HUFFMAN ENGINEERS