PG. 7-00-045-C & D P.P.No's. 07-00-045-101-029

PPN 07-00-045-101-029

MAP PG 7-00-045-C,D
44041

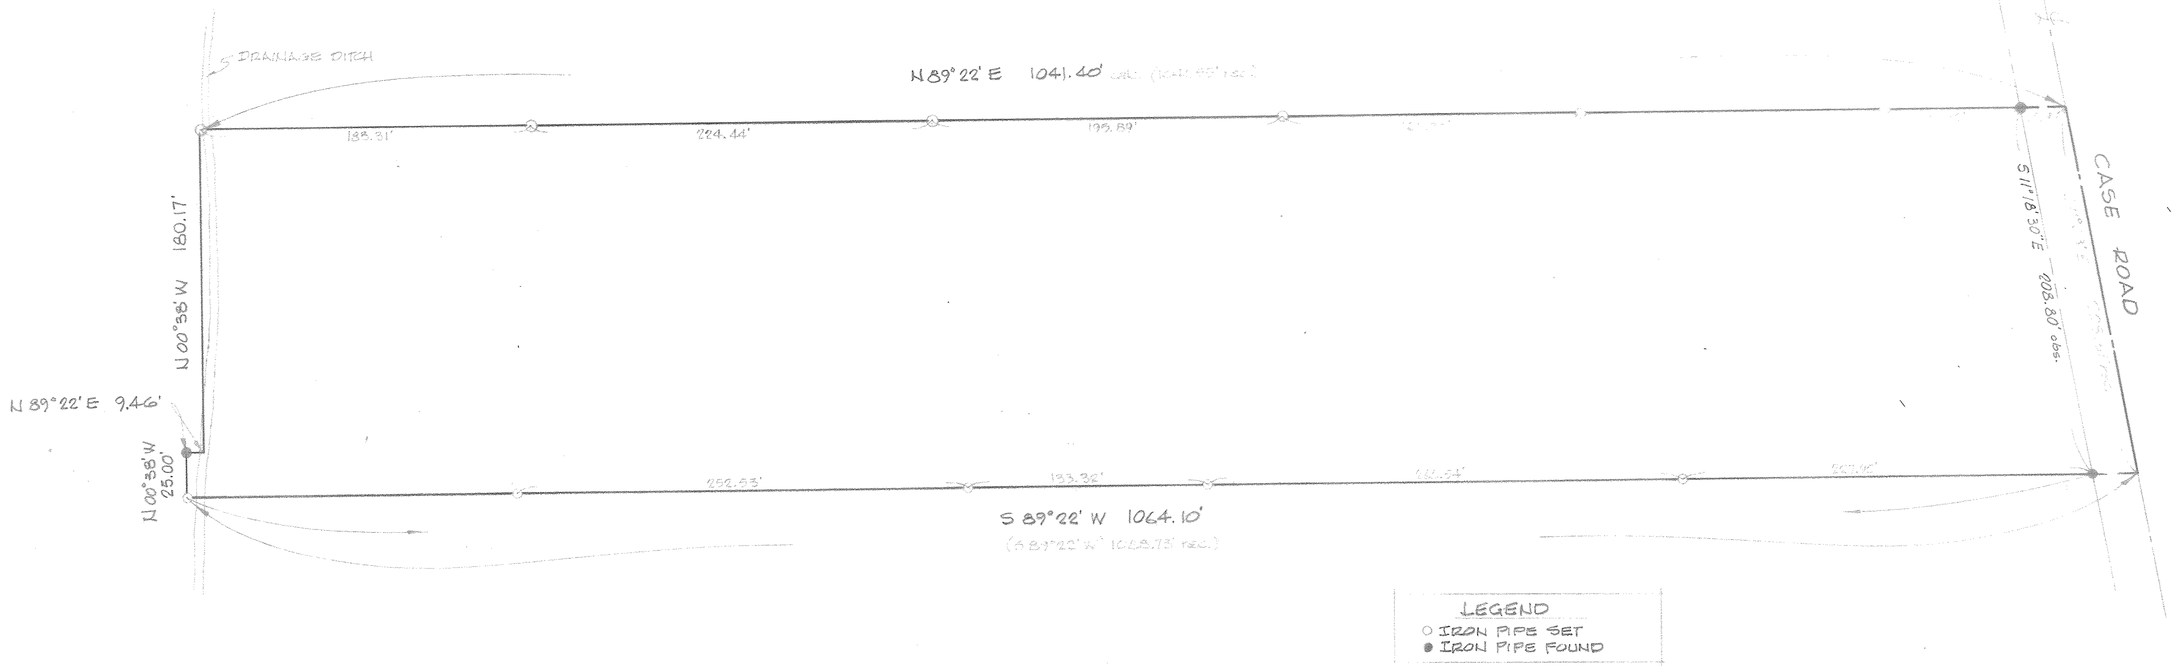

LEGEND
○ IRON PIPE SET
● IRON PIPE FOUND

MAP of PROPERTY SURVEY

PREPARED FOR GRACE CATHERINE HAAS

PART of ORIGINAL RIDGEVILLE TOWNSHIP LOT No. 45
CITY of NORTH RIDGEVILLE, LORAIN COUNTY, OHIO

NORTH

McGLINCHY AND ASSOCIATES
PROFESSIONAL ENGINEERS AND SURVEYORS
ELYRIA, OHIO

SCALE: 1" = 40' DRAWN BY: R. THOMAS
DATE: OCT. 1982 JOB NO: 827381