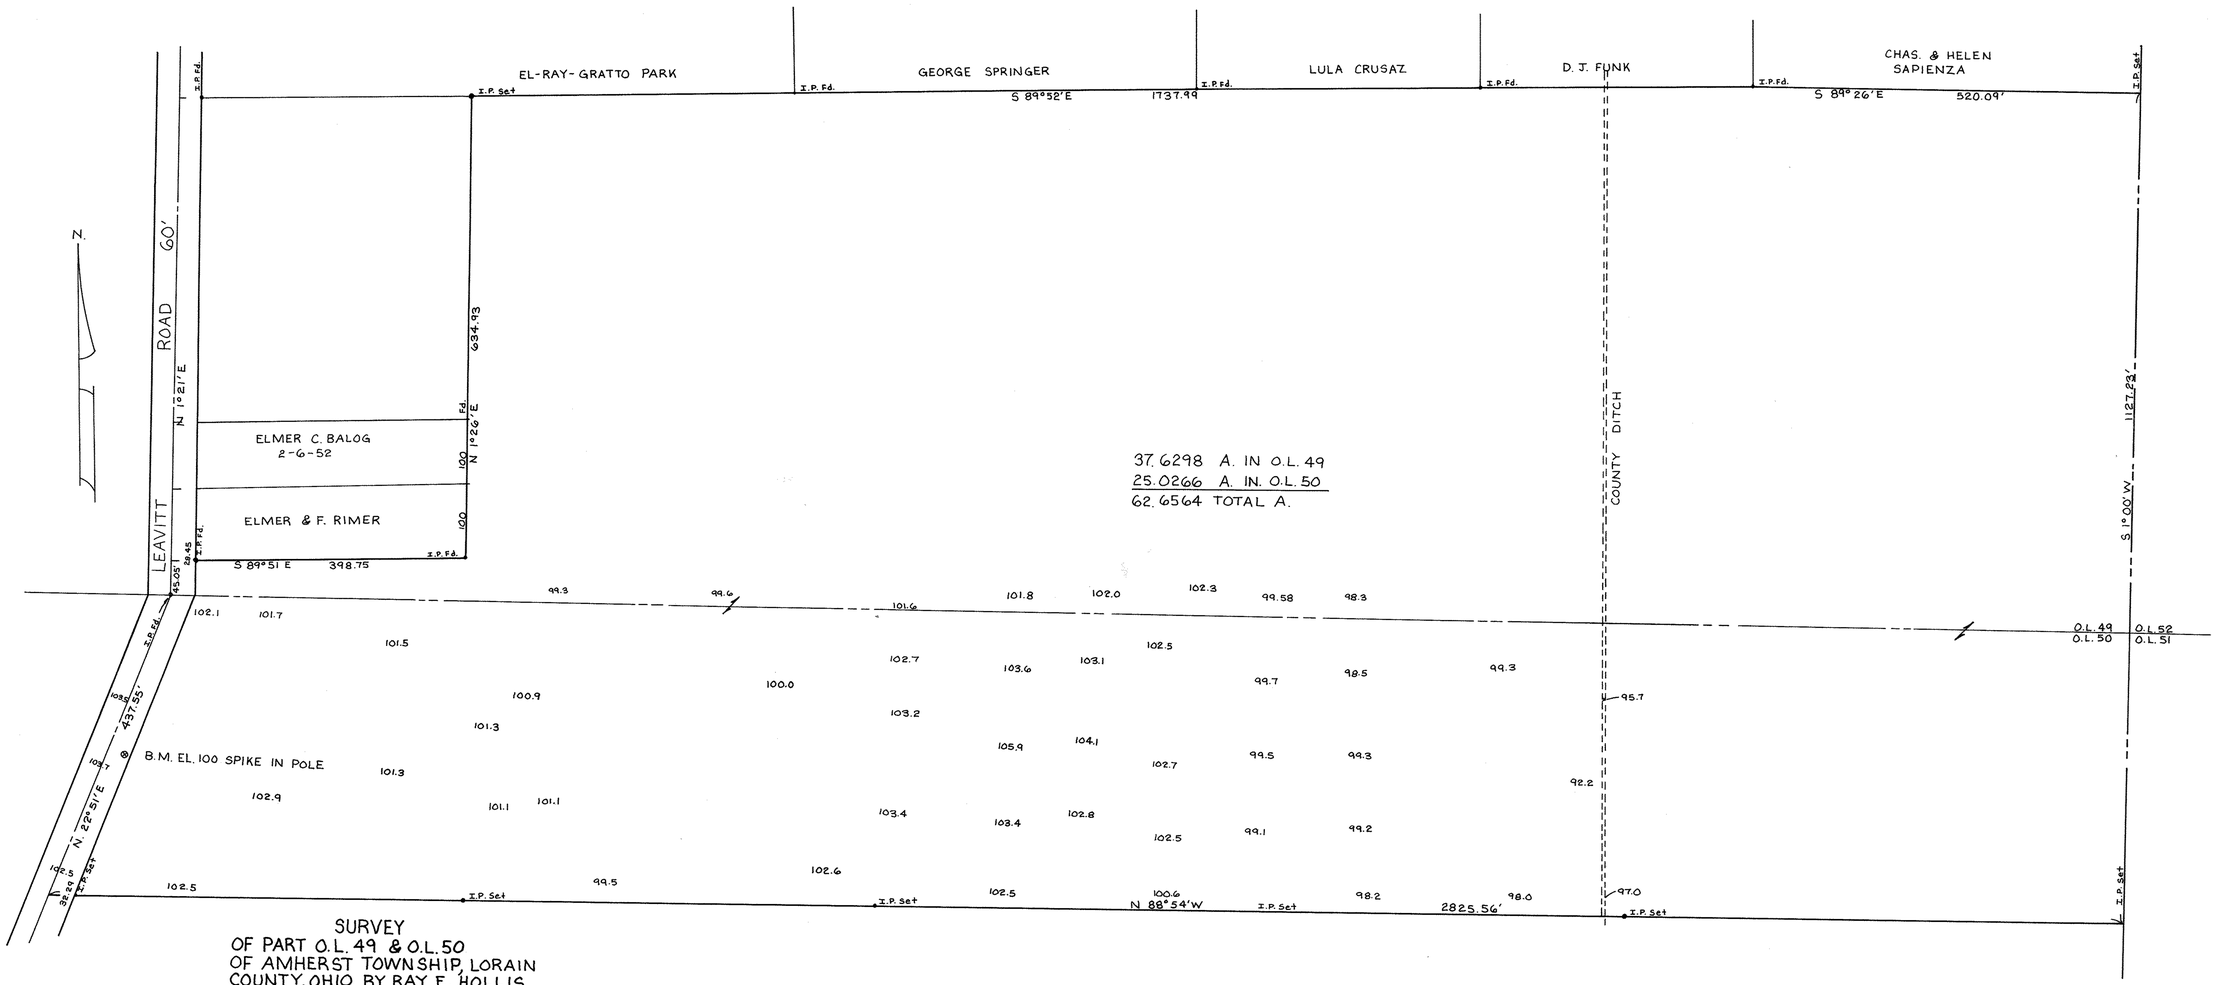

SURVEY
OF PART O.L. 49 & O.L. 50
OF AMHERST TOWNSHIP, LORAIN
COUNTY, OHIO. BY RAY E. HOLLIS
REG. ENG & SURVEYOR NOV. 1953
SCALE 1"-100'

THIS TRACED OFF OF OLD COPY
11/30/84 Stacy Hollis