7-00-028-102-066
7-00-028-0

PPN 07-00-028-102-066
MAP 05 07-00-028-0
44040

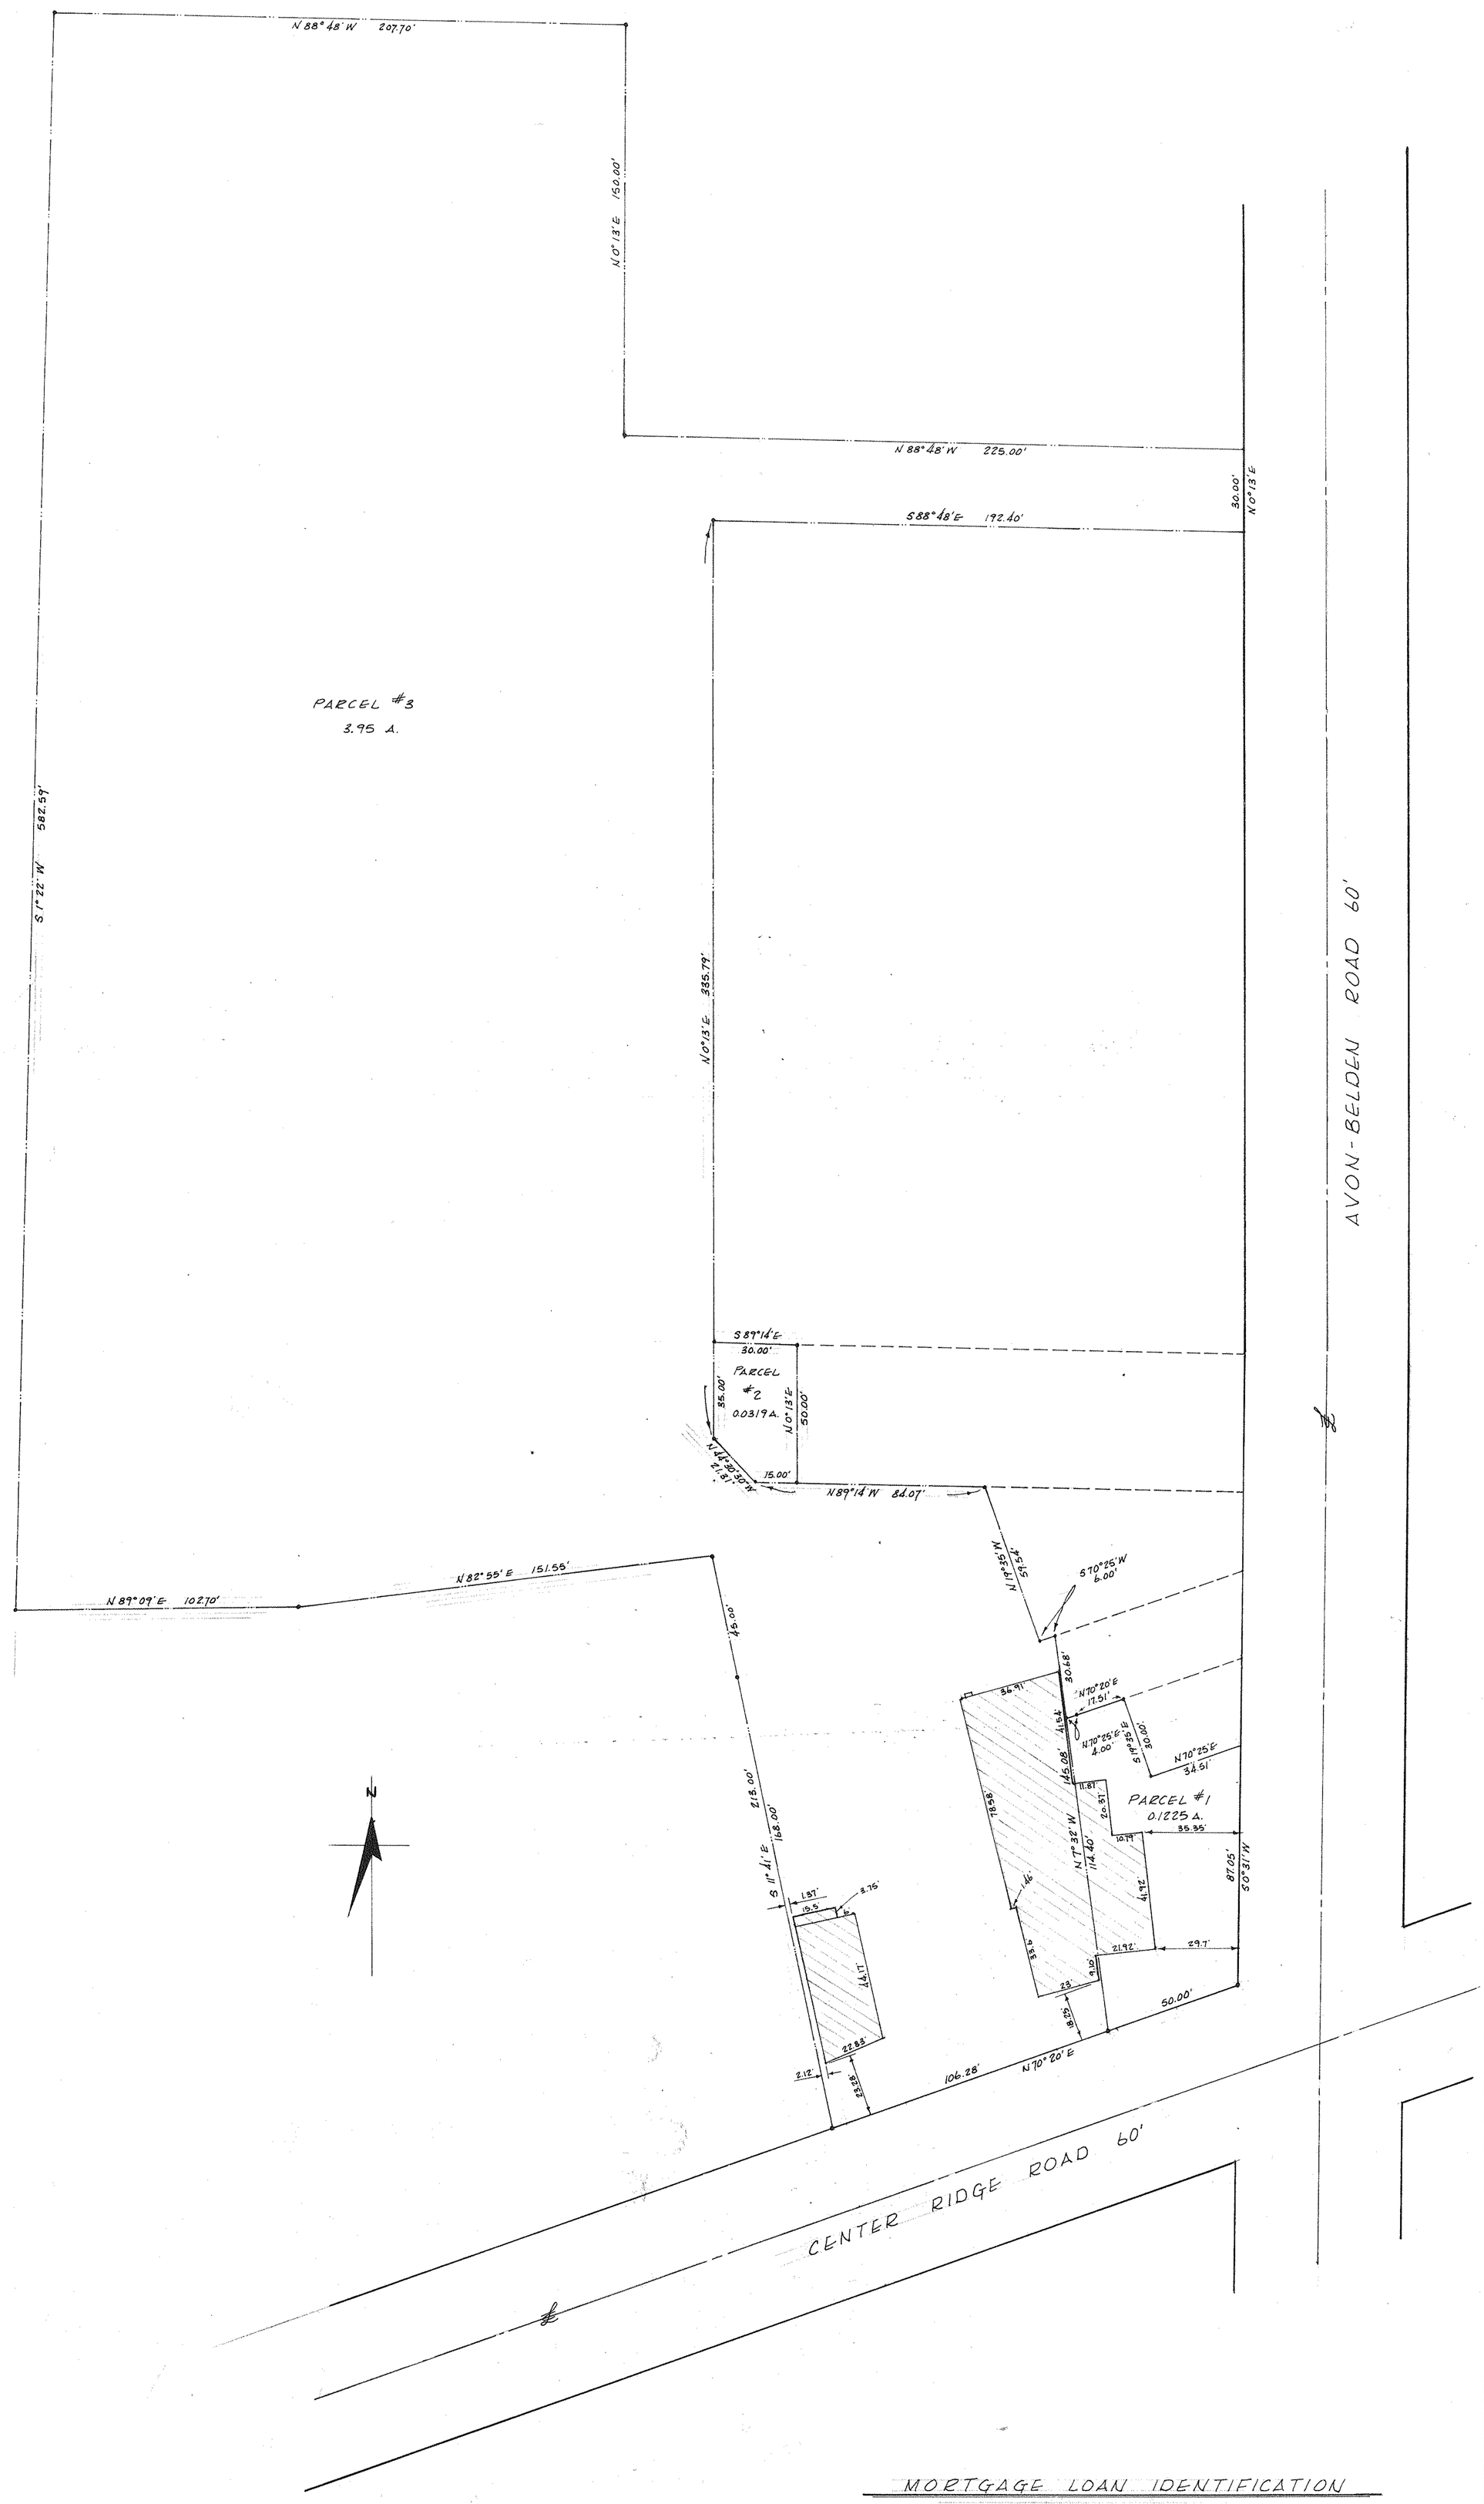

MORTGAGE LOAN IDENTIFICATION

RIDGE CLEANERS
O.L. 28 RIDGEVILLE TWP.
E-171,914
SCALE: 1" = 30'
OCT. 18, 1977
77-681

FOR MORTGAGE PURPOSES ONLY.
NOT A PLAT OF SURVEY.

Rodger Simon