7-00-016-A
07-00-016-104-018
-144

PPN 07-00-016-104-018
-144

Map pg 7-00-016-A
44050

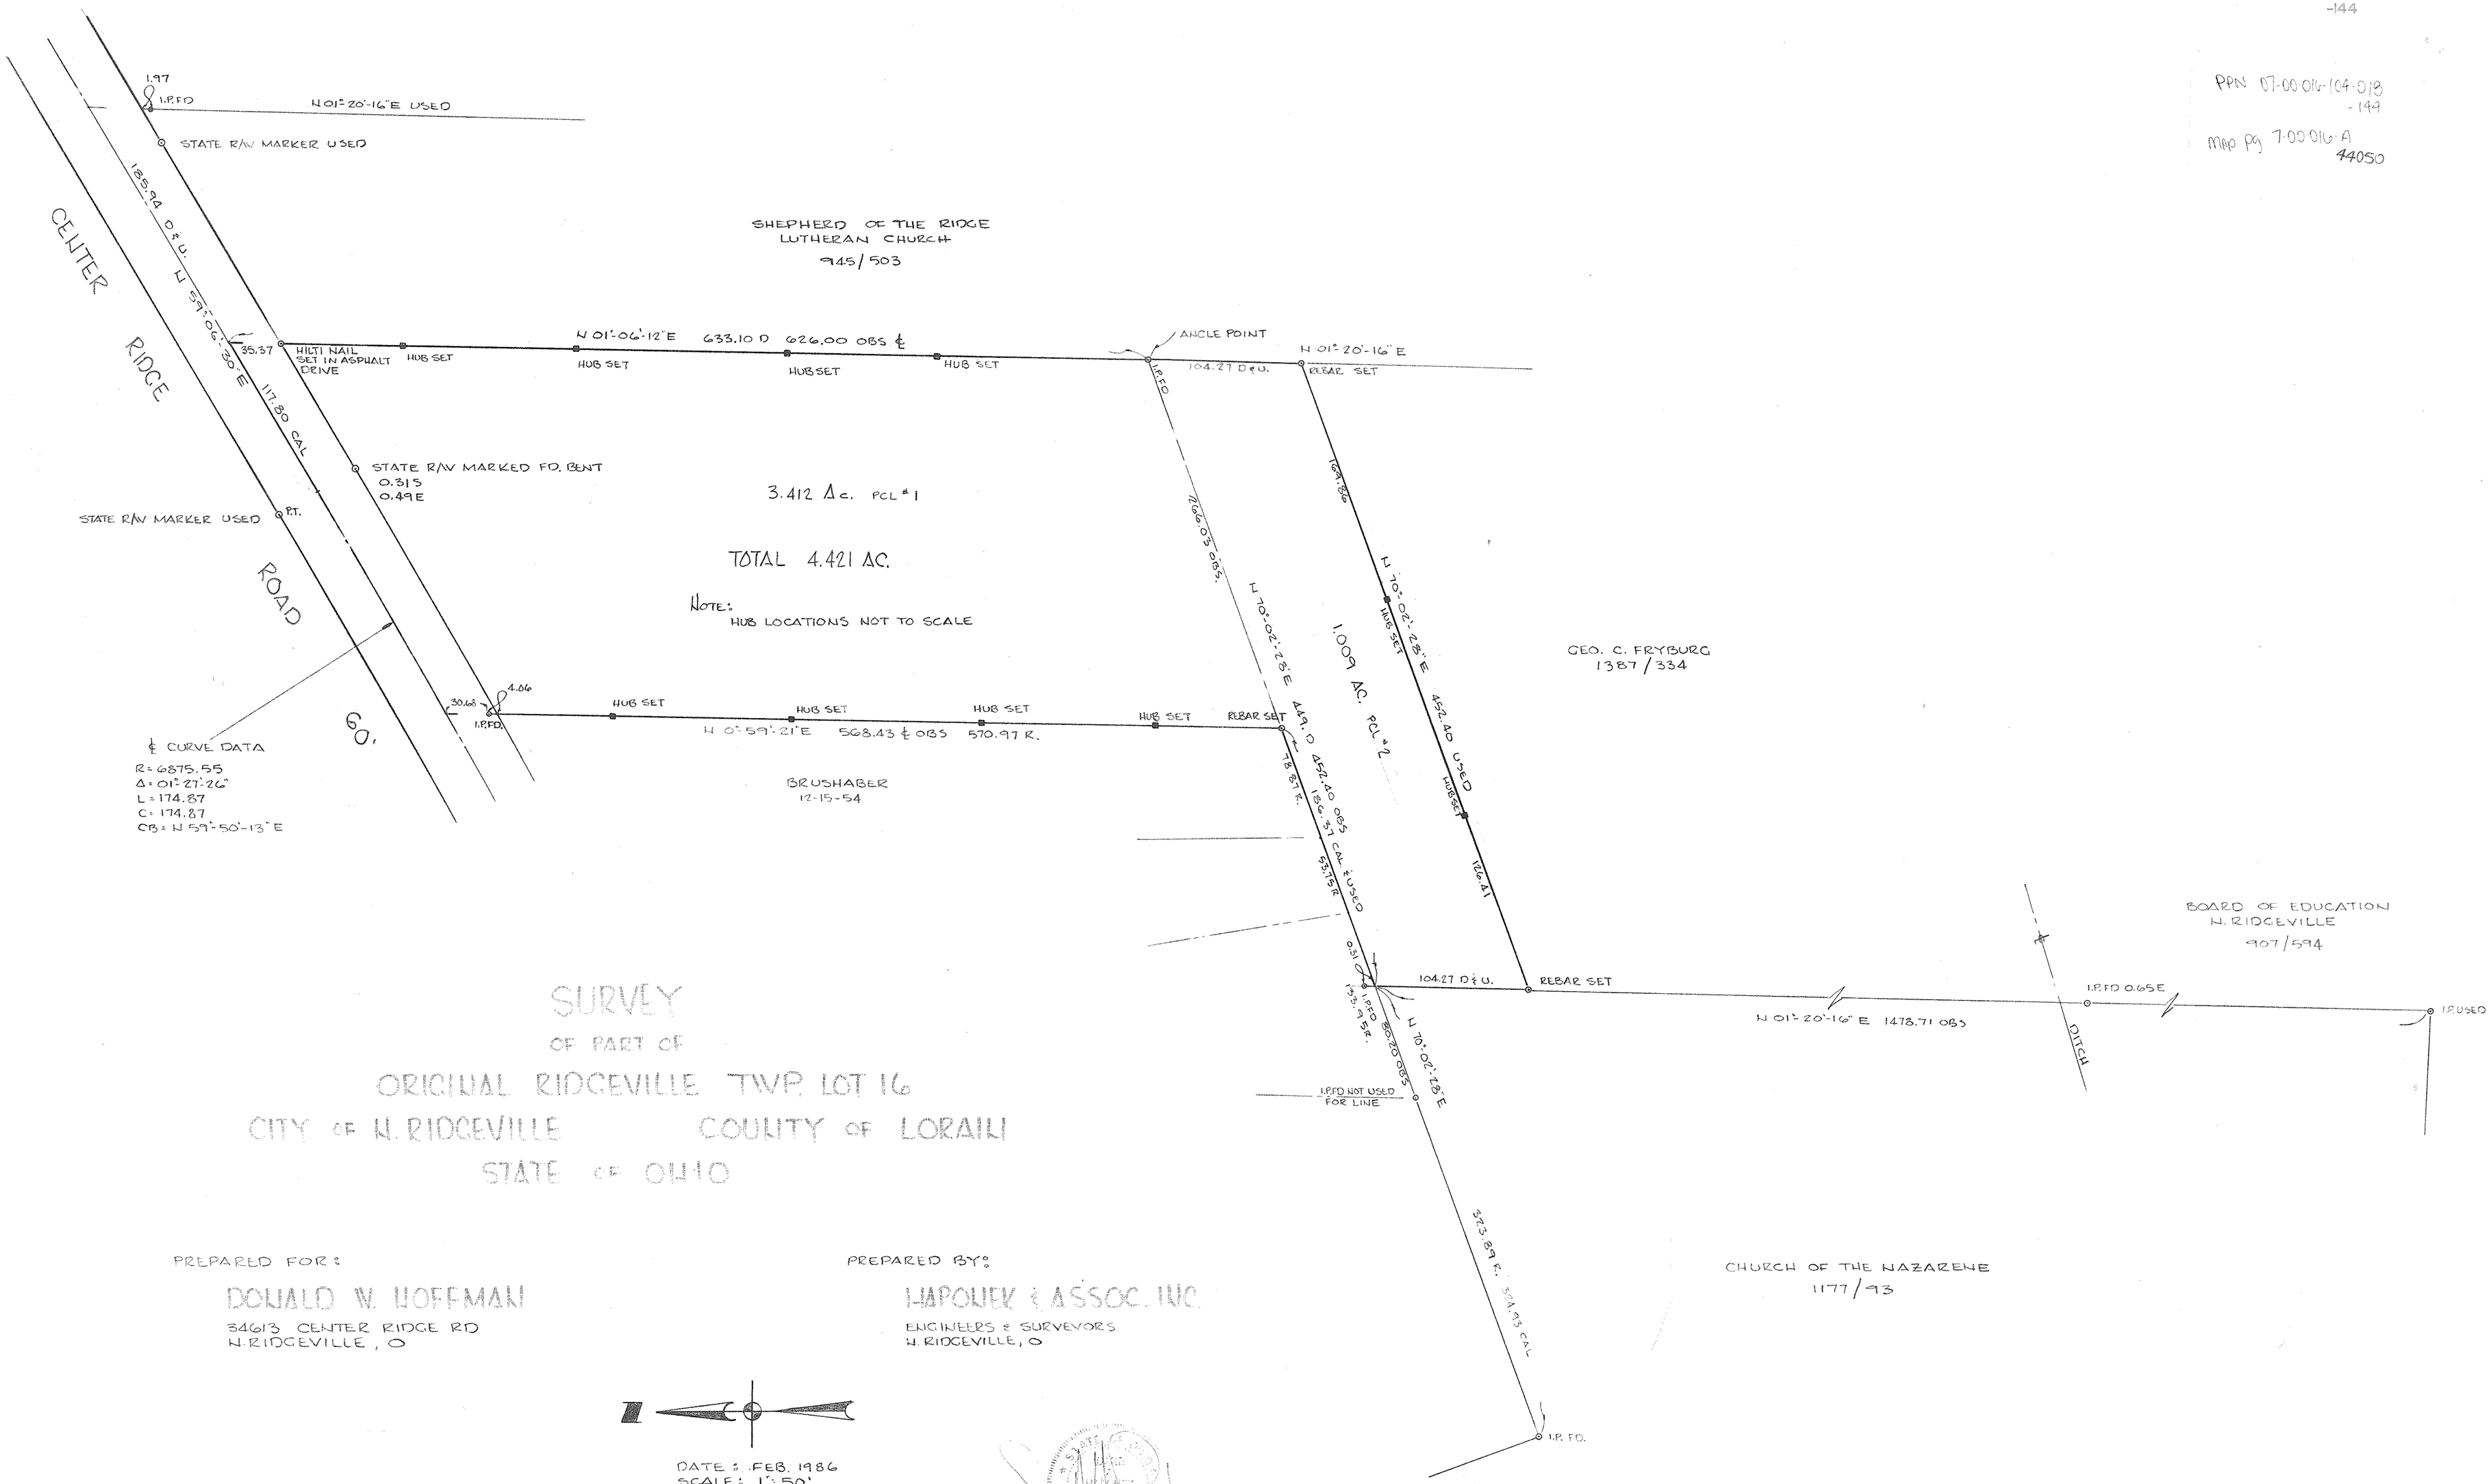

SURVEY
OF PART OF
ORIGINAL RIDGEVILLE TWP. LOT 16
CITY OF W. RIDGEVILLE COUNTY OF LORAIN
STATE OF OHIO

PREPARED FOR:
DONALD W. HOFFMAN
34613 CENTER RIDGE RD
W. RIDGEVILLE, O

PREPARED BY:
HAPOWEK & ASSOC. INC.
ENGINEERS & SURVEYORS
W. RIDGEVILLE, O

DATE: FEB. 1986
SCALE: 1" = 50'

86-02