7-00-016-A
07-00-016-101-002, -009, -010, -015, -016

PPN 07-00-016-101-002
009
010
015
016
44052
MAP PG 7-00-06A

SCALE 1" = 50
DATE : MARCH 1986

SURVEY
OF PART OF
ORIGINAL RIDGEVILLE TWP. 16
CITY OF N. RIDGEVILLE COUNTY OF LORAIN
STATE OF OHIO

PREPARED BY:
HAPONEK & ASSOC. INC.
SURVEYORS
N. RIDGEVILLE, O

STATE OF OHIO
DANE A. HAPONEK
S-7211
REGISTERED SURVEYOR
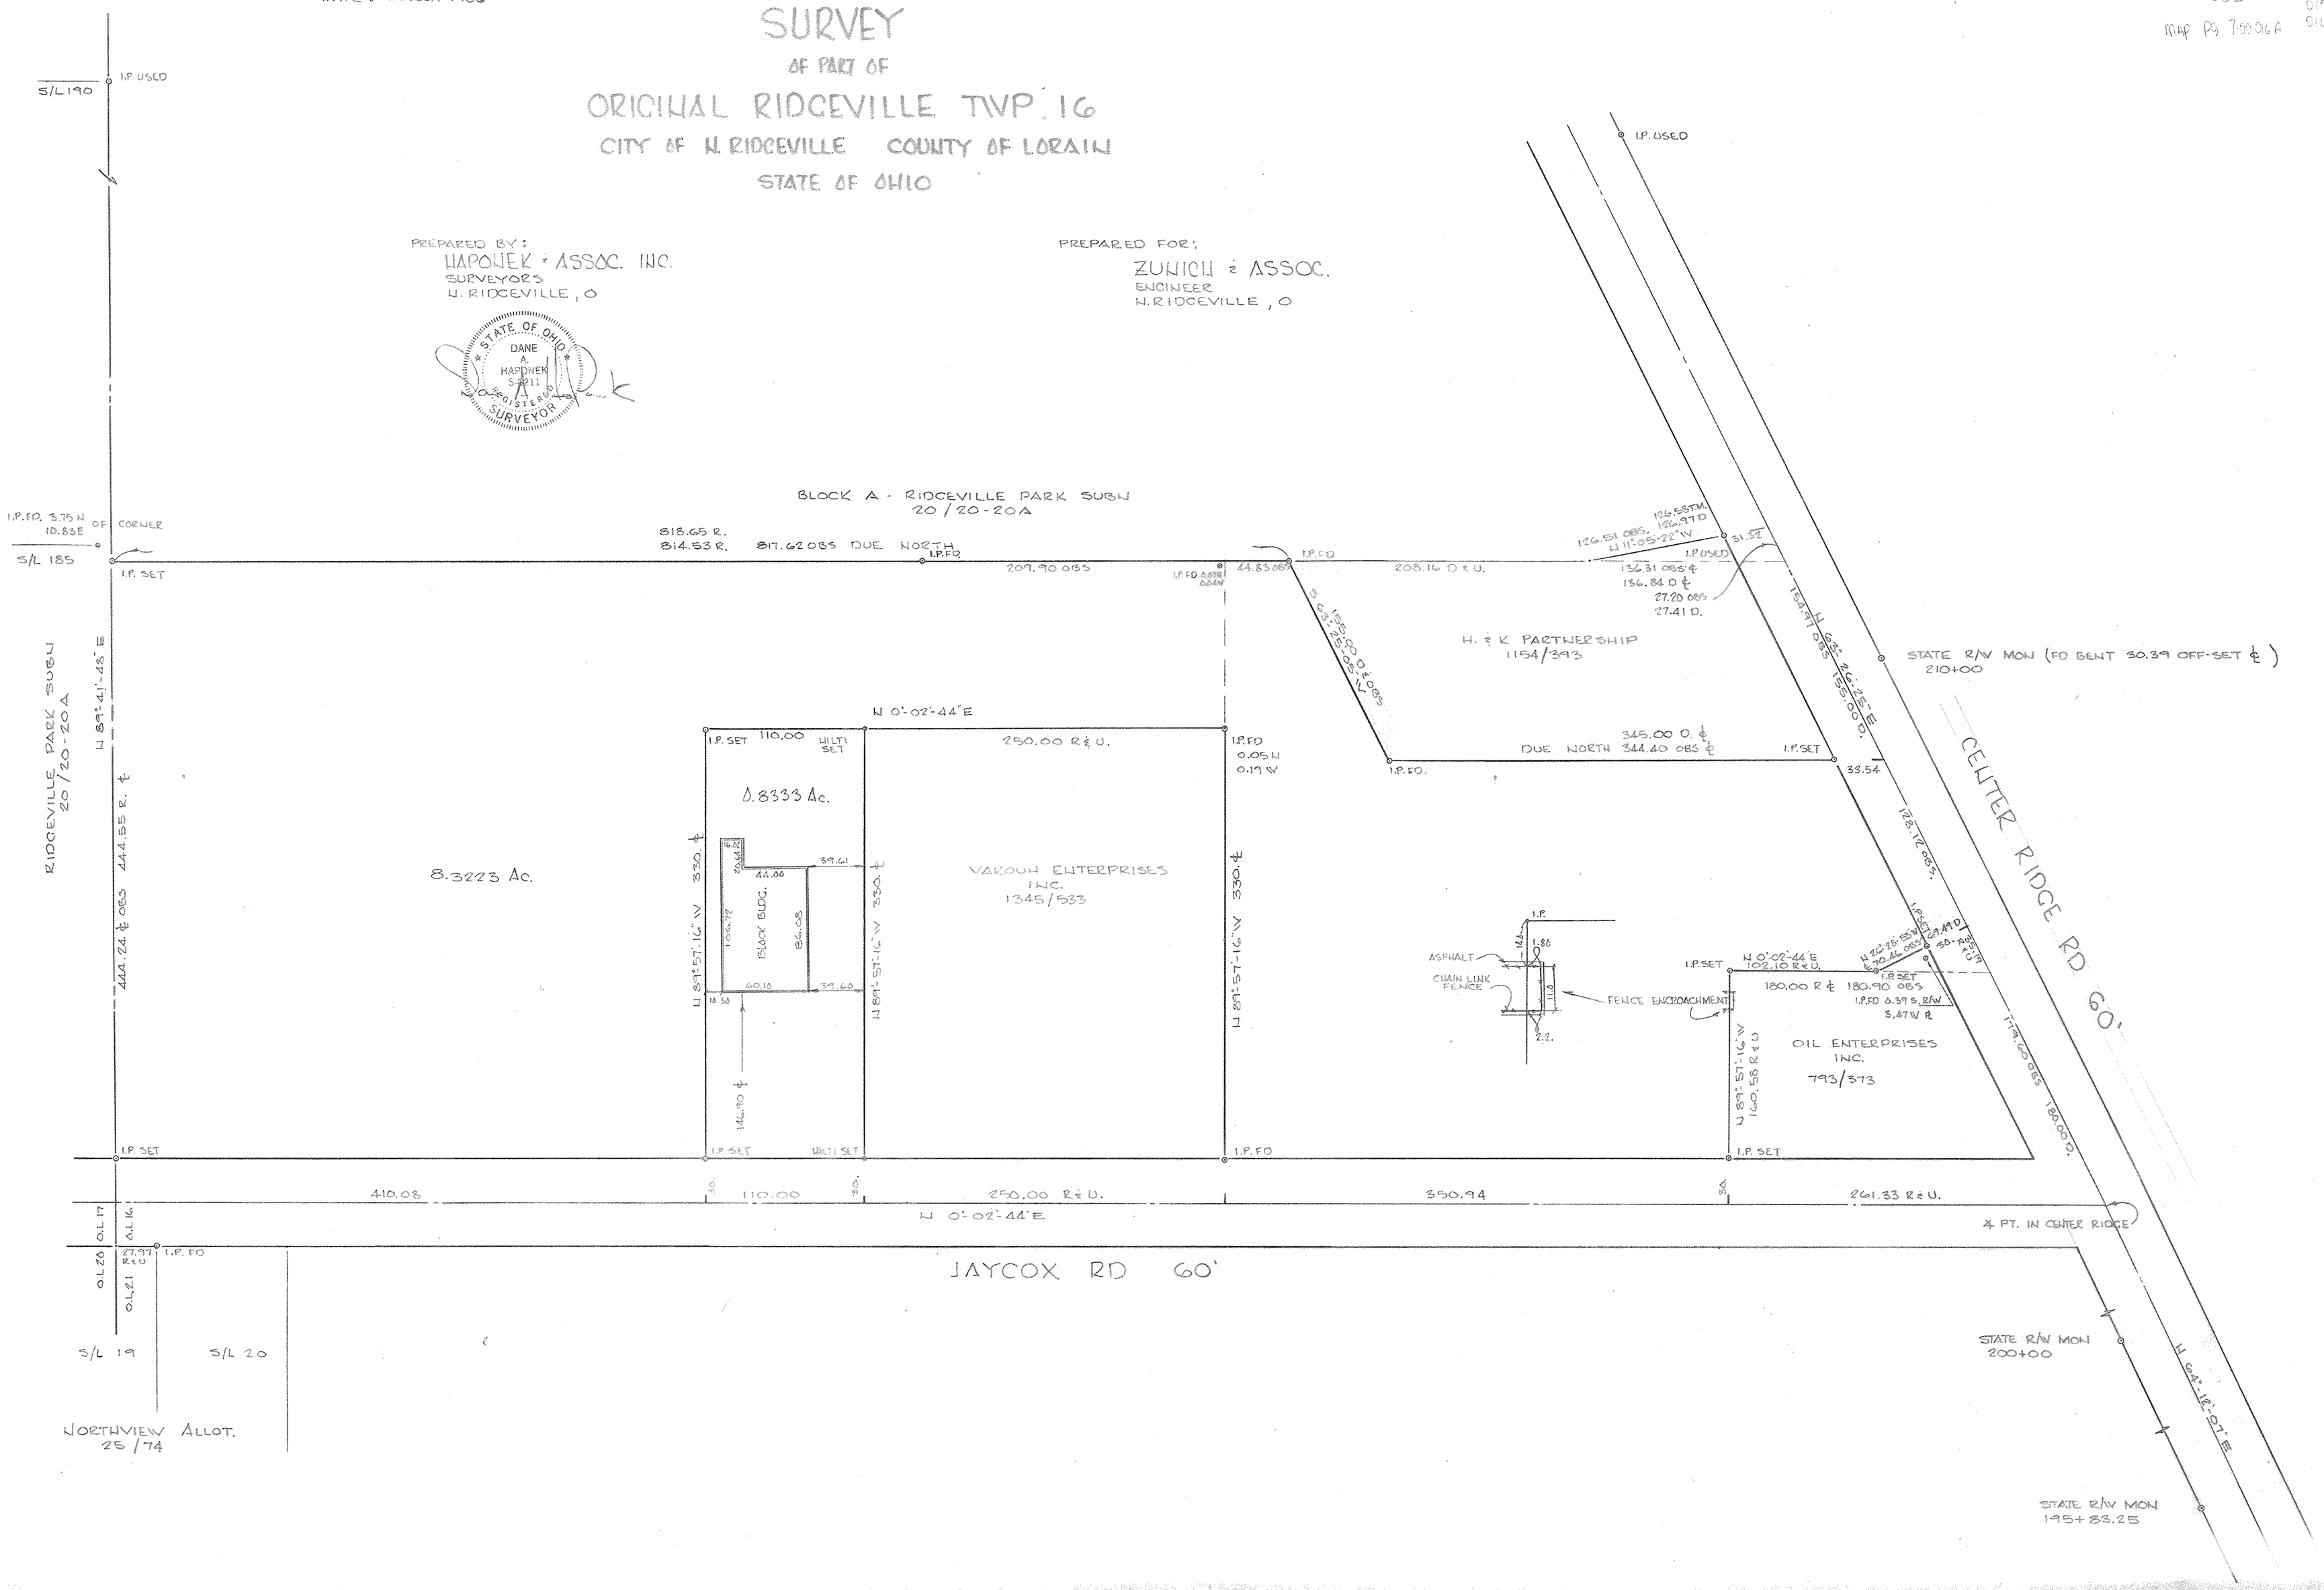
PREPARED FOR:
ZUNICH & ASSOC.
ENGINEER
N. RIDGEVILLE, O