07-00-039-000-
07-00-039-D

MAP OF SURVEY

FOR

R.W. BECKETT CORPORATION

SITUATED IN THE CITY OF NORTH RIDGEVILLE, COUNTY OF LORAIN AND STATE OF OHIO AND KNOWN AS BEING PART OF ORIGINAL RIDGEVILLE TOWNSHIP LOT 39.

N

SCALE : 1" = 40'

NOV. 30, 1990

REVISED 12/14/90

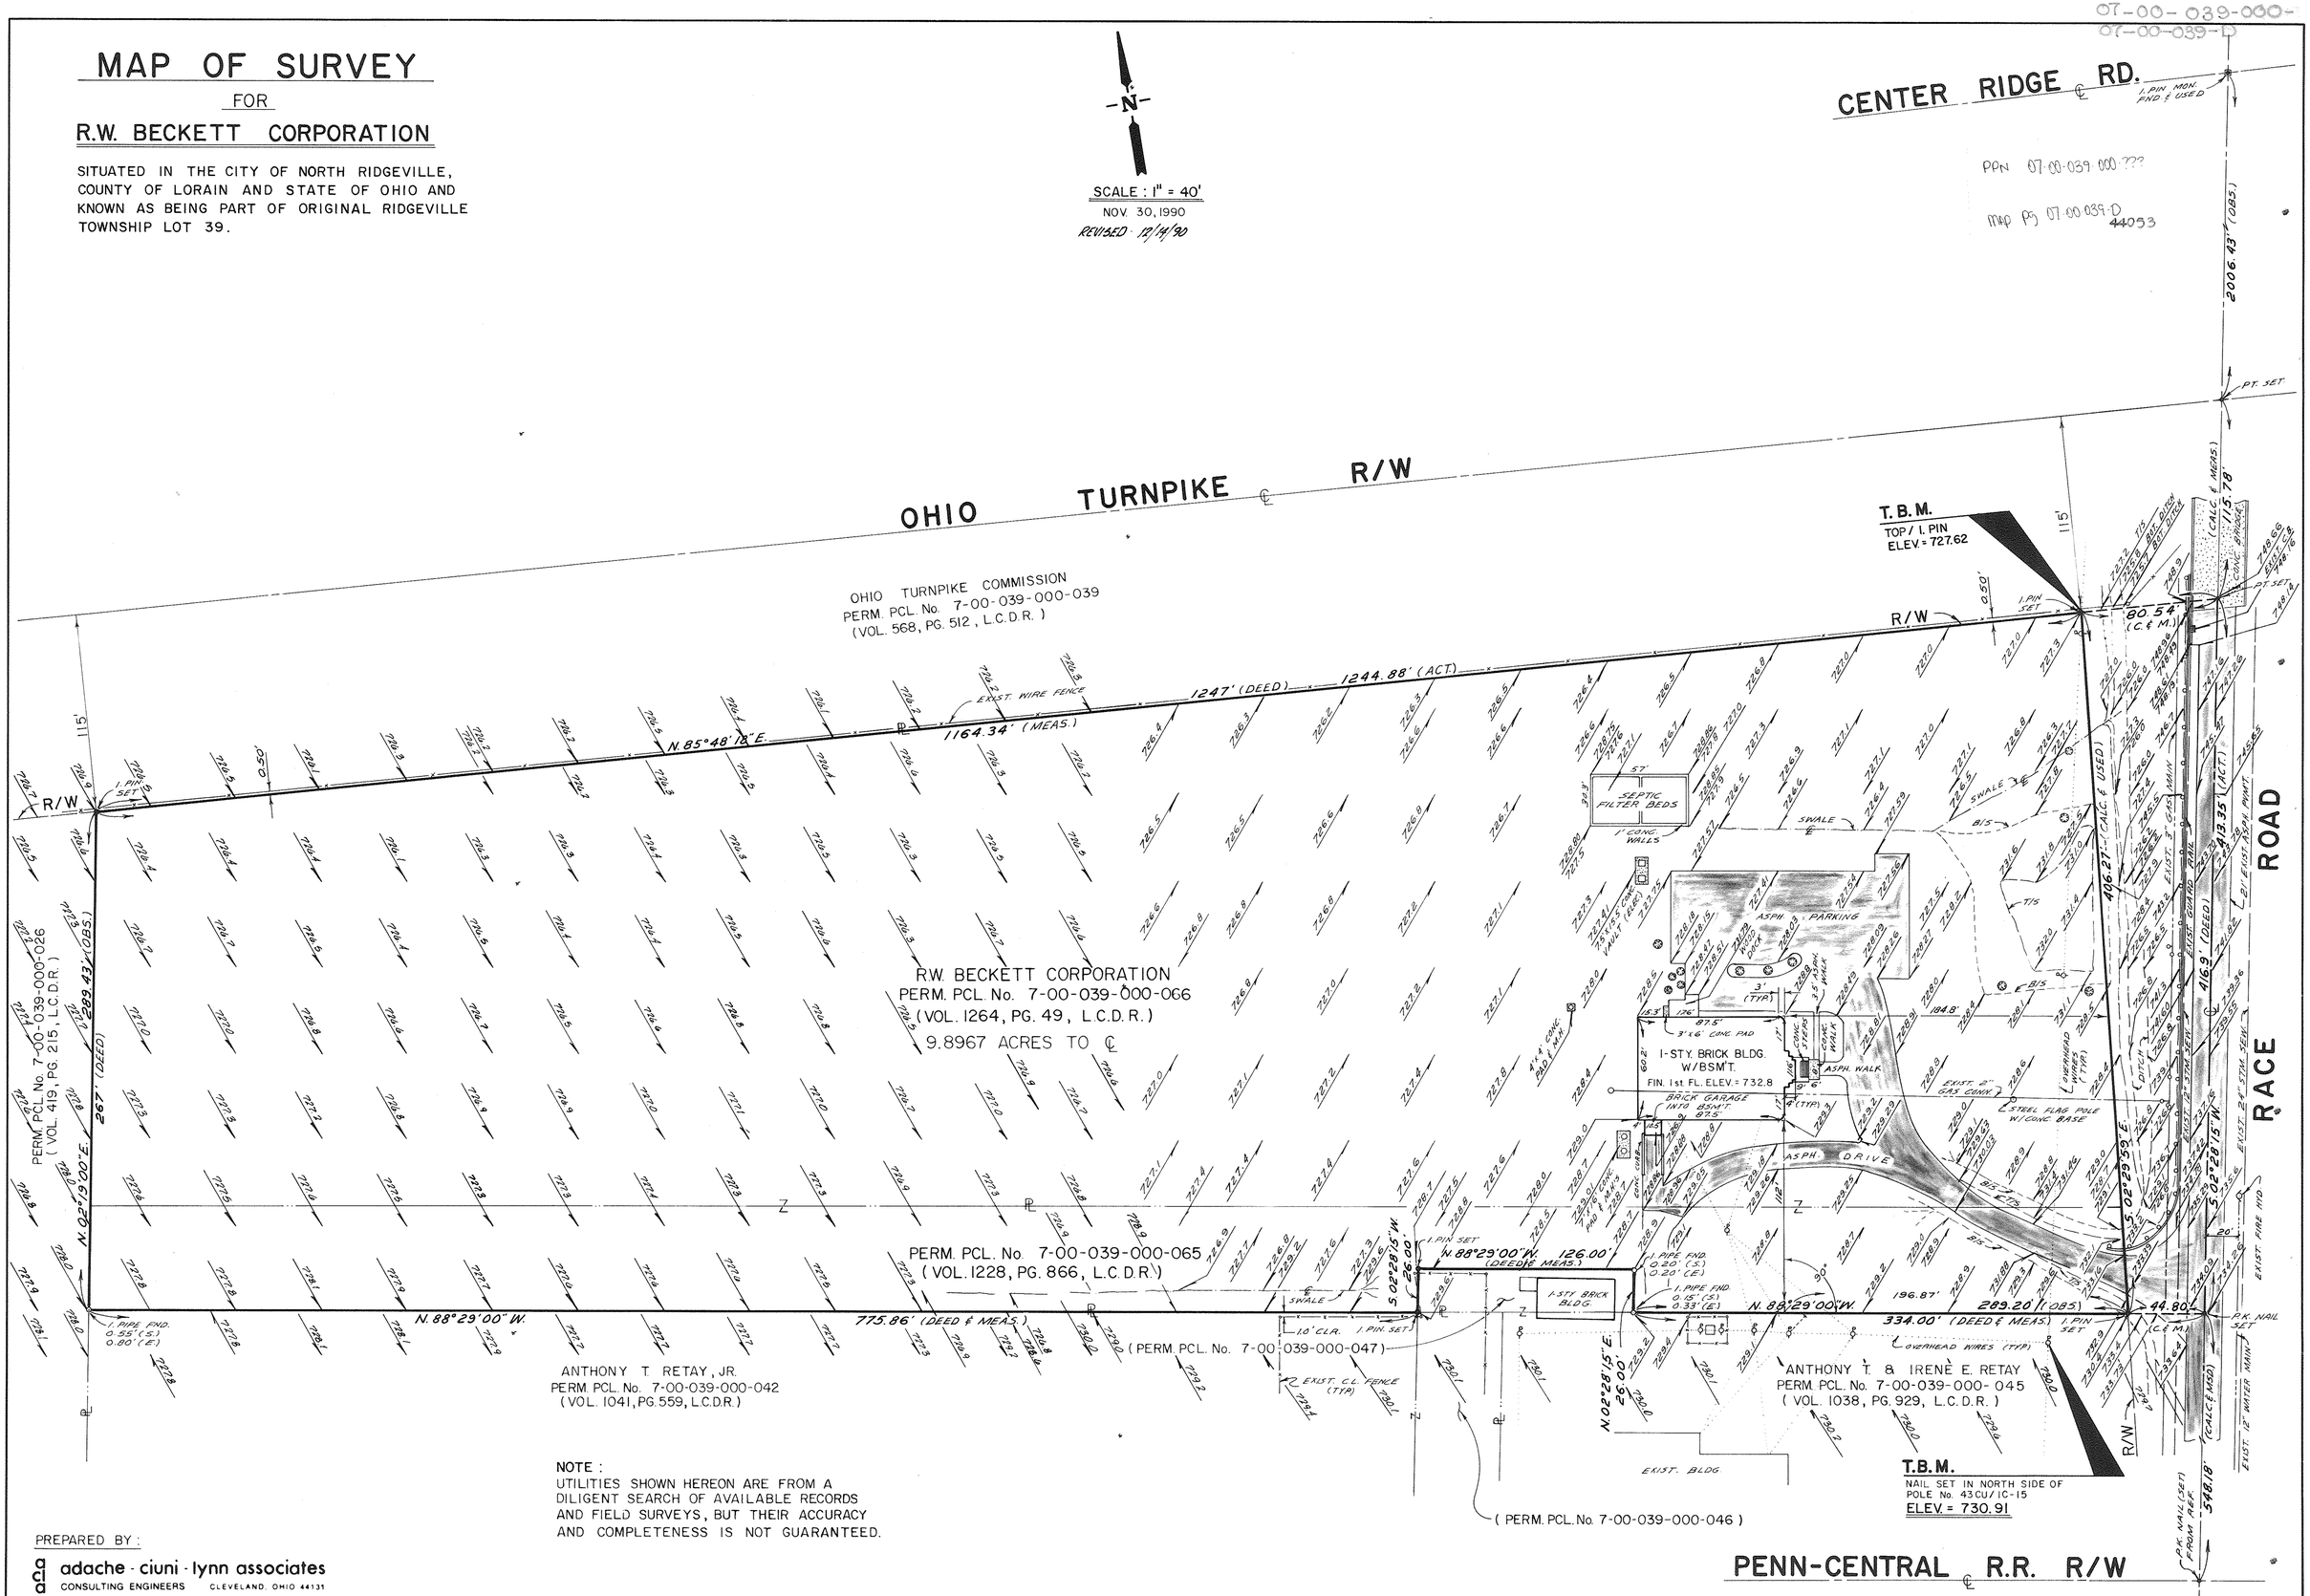

NOTE :
UTILITIES SHOWN HEREON ARE FROM A DILIGENT SEARCH OF AVAILABLE RECORDS AND FIELD SURVEYS, BUT THEIR ACCURACY AND COMPLETENESS IS NOT GUARANTEED.

PREPARED BY :

adache · ciuni · lynn associates
CONSULTING ENGINEERS CLEVELAND, OHIO 44131

JOB No. 90143