7-B
07-00-029-000-070, 072, 073

PPN 07-00-029-000-070
072
073

Map Pg 7-B 44054

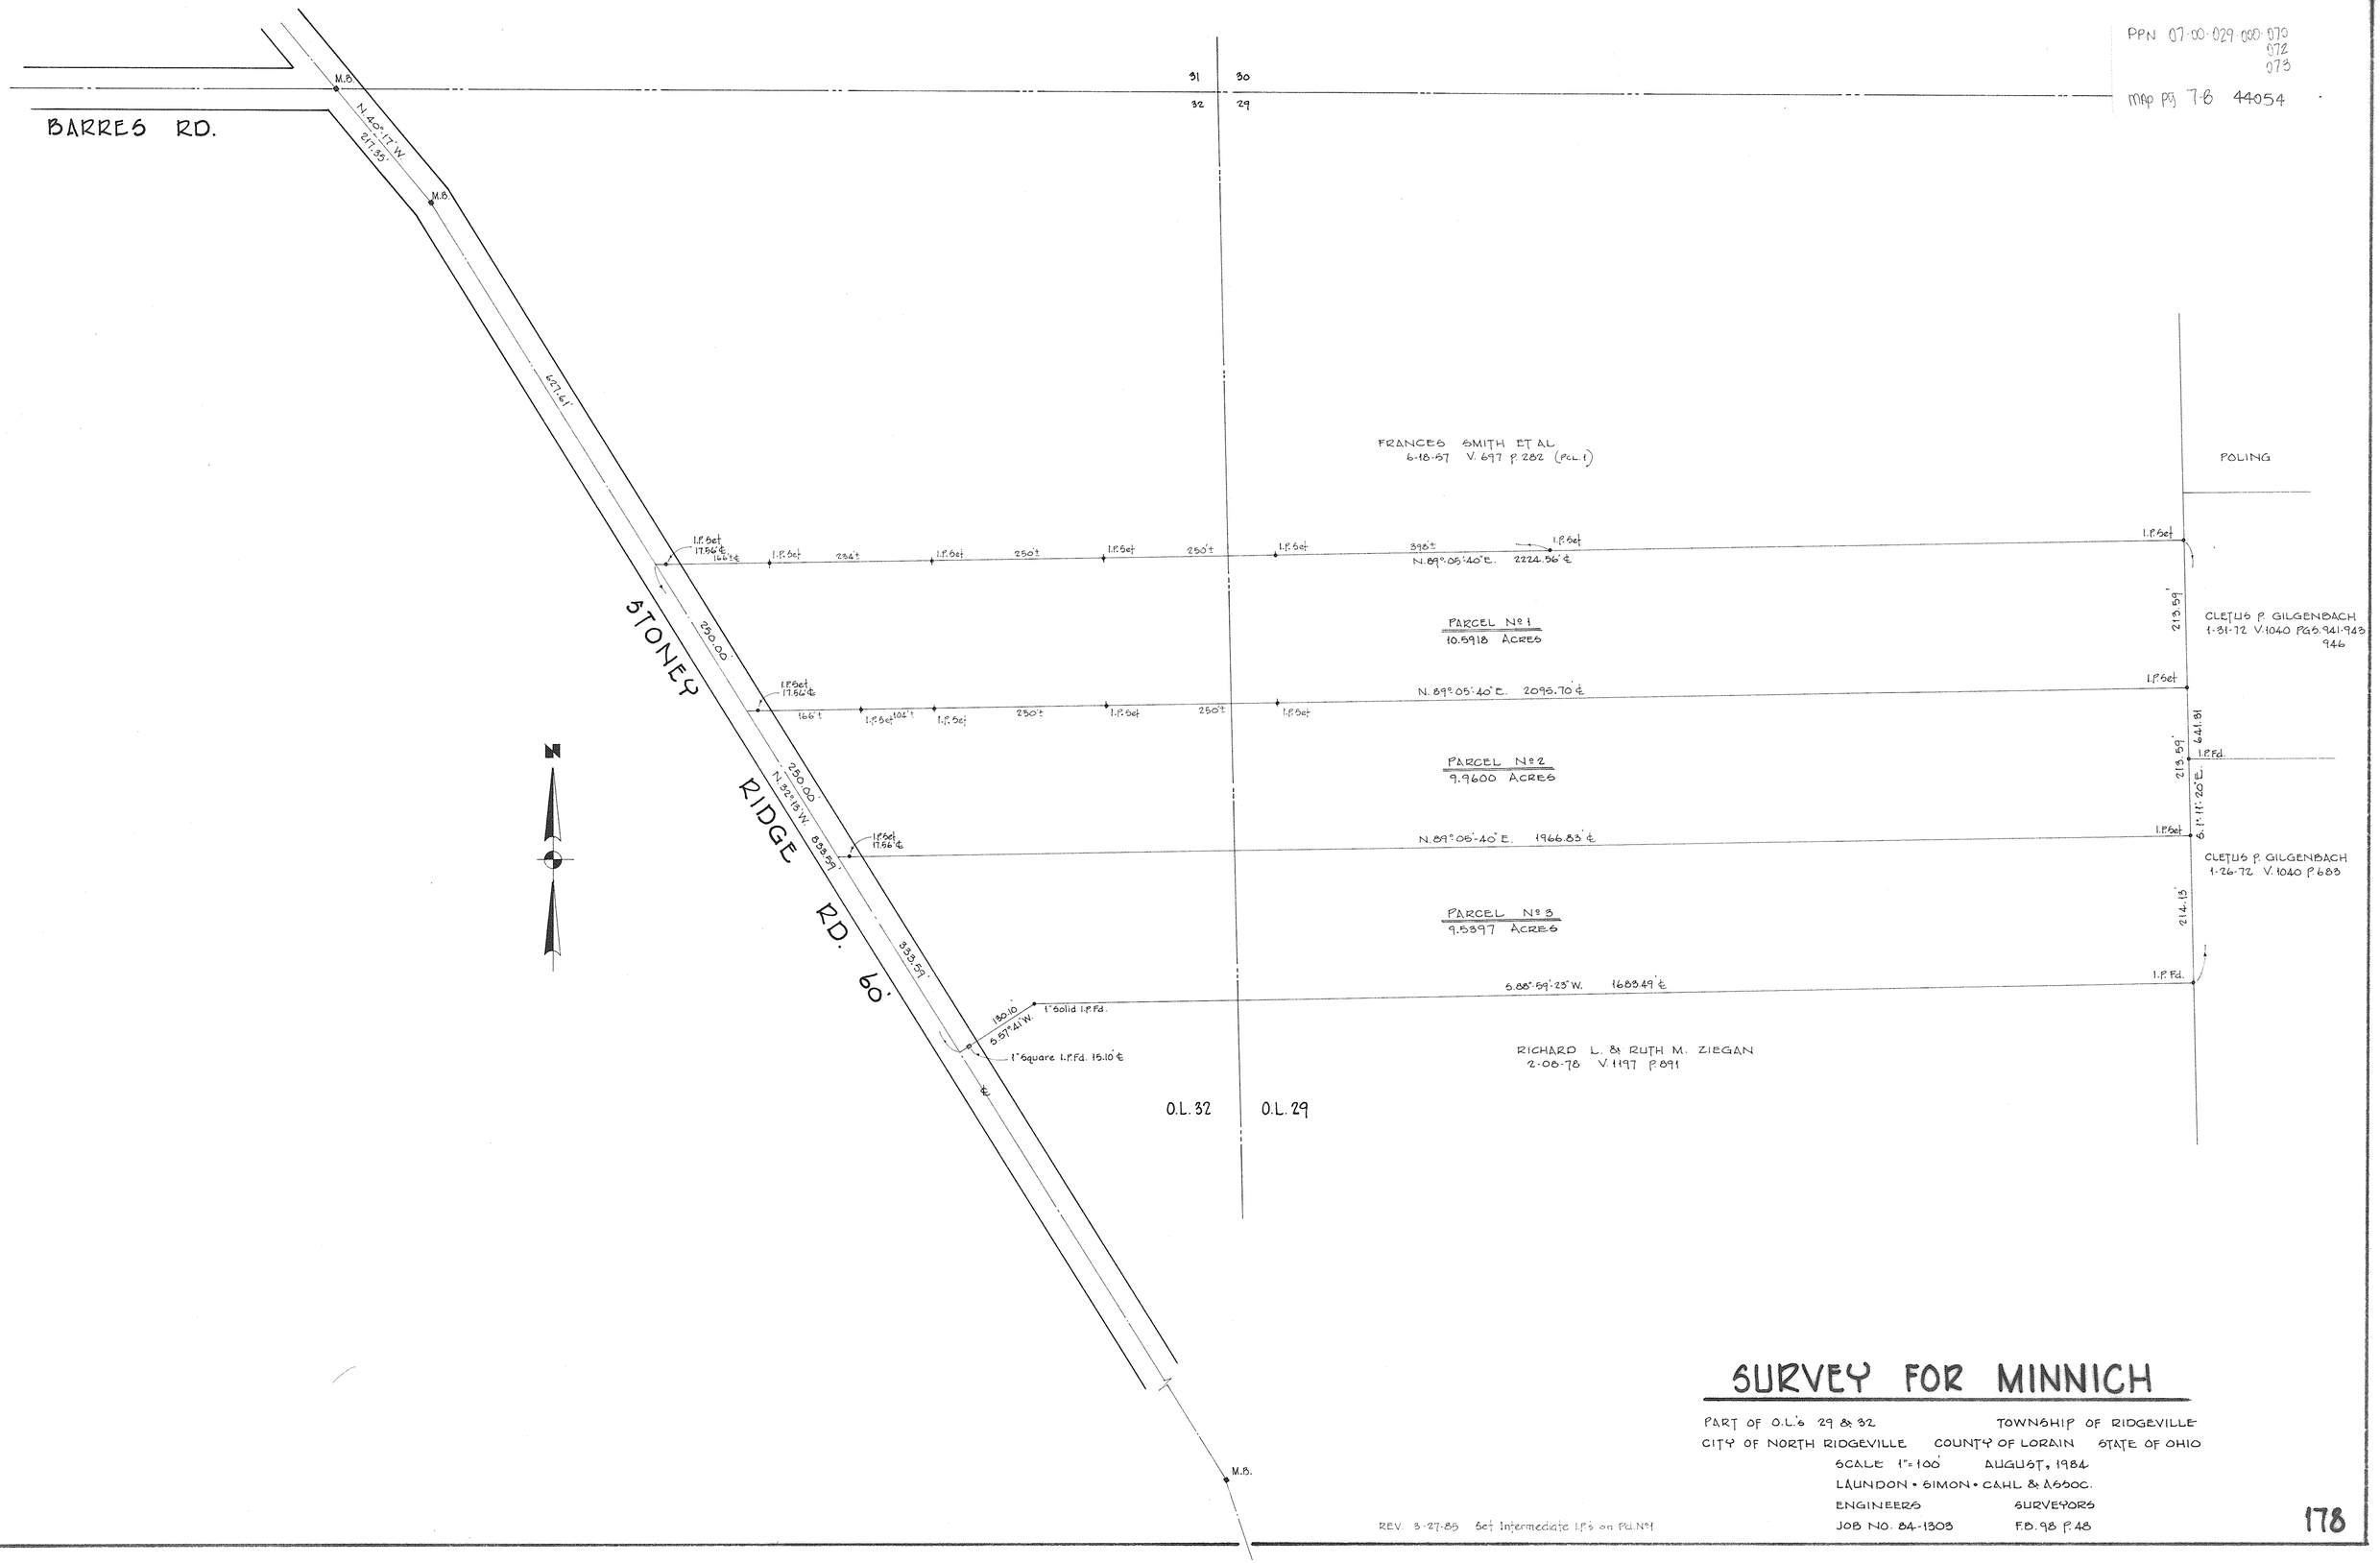

SURVEY FOR MINNICH

PART OF O.L.'s 29 & 32 TOWNSHIP OF RIDGEVILLE
CITY OF NORTH RIDGEVILLE COUNTY OF LORAIN STATE OF OHIO
SCALE 1" = 100' AUGUST, 1984
LAUNDON • SIMON • CAHL & ASSOC.
ENGINEERS SURVEYORS
JOB NO. 84-1303 F.B. 98 P. 48

REV. 3-27-85 Set Intermediate I.P.'s on Pcl. Nº 1

178