7-B
O.L. 29 - 000-076 & 077

PAN 07-00-029-000-076
077

MAP PG 7-B 44055

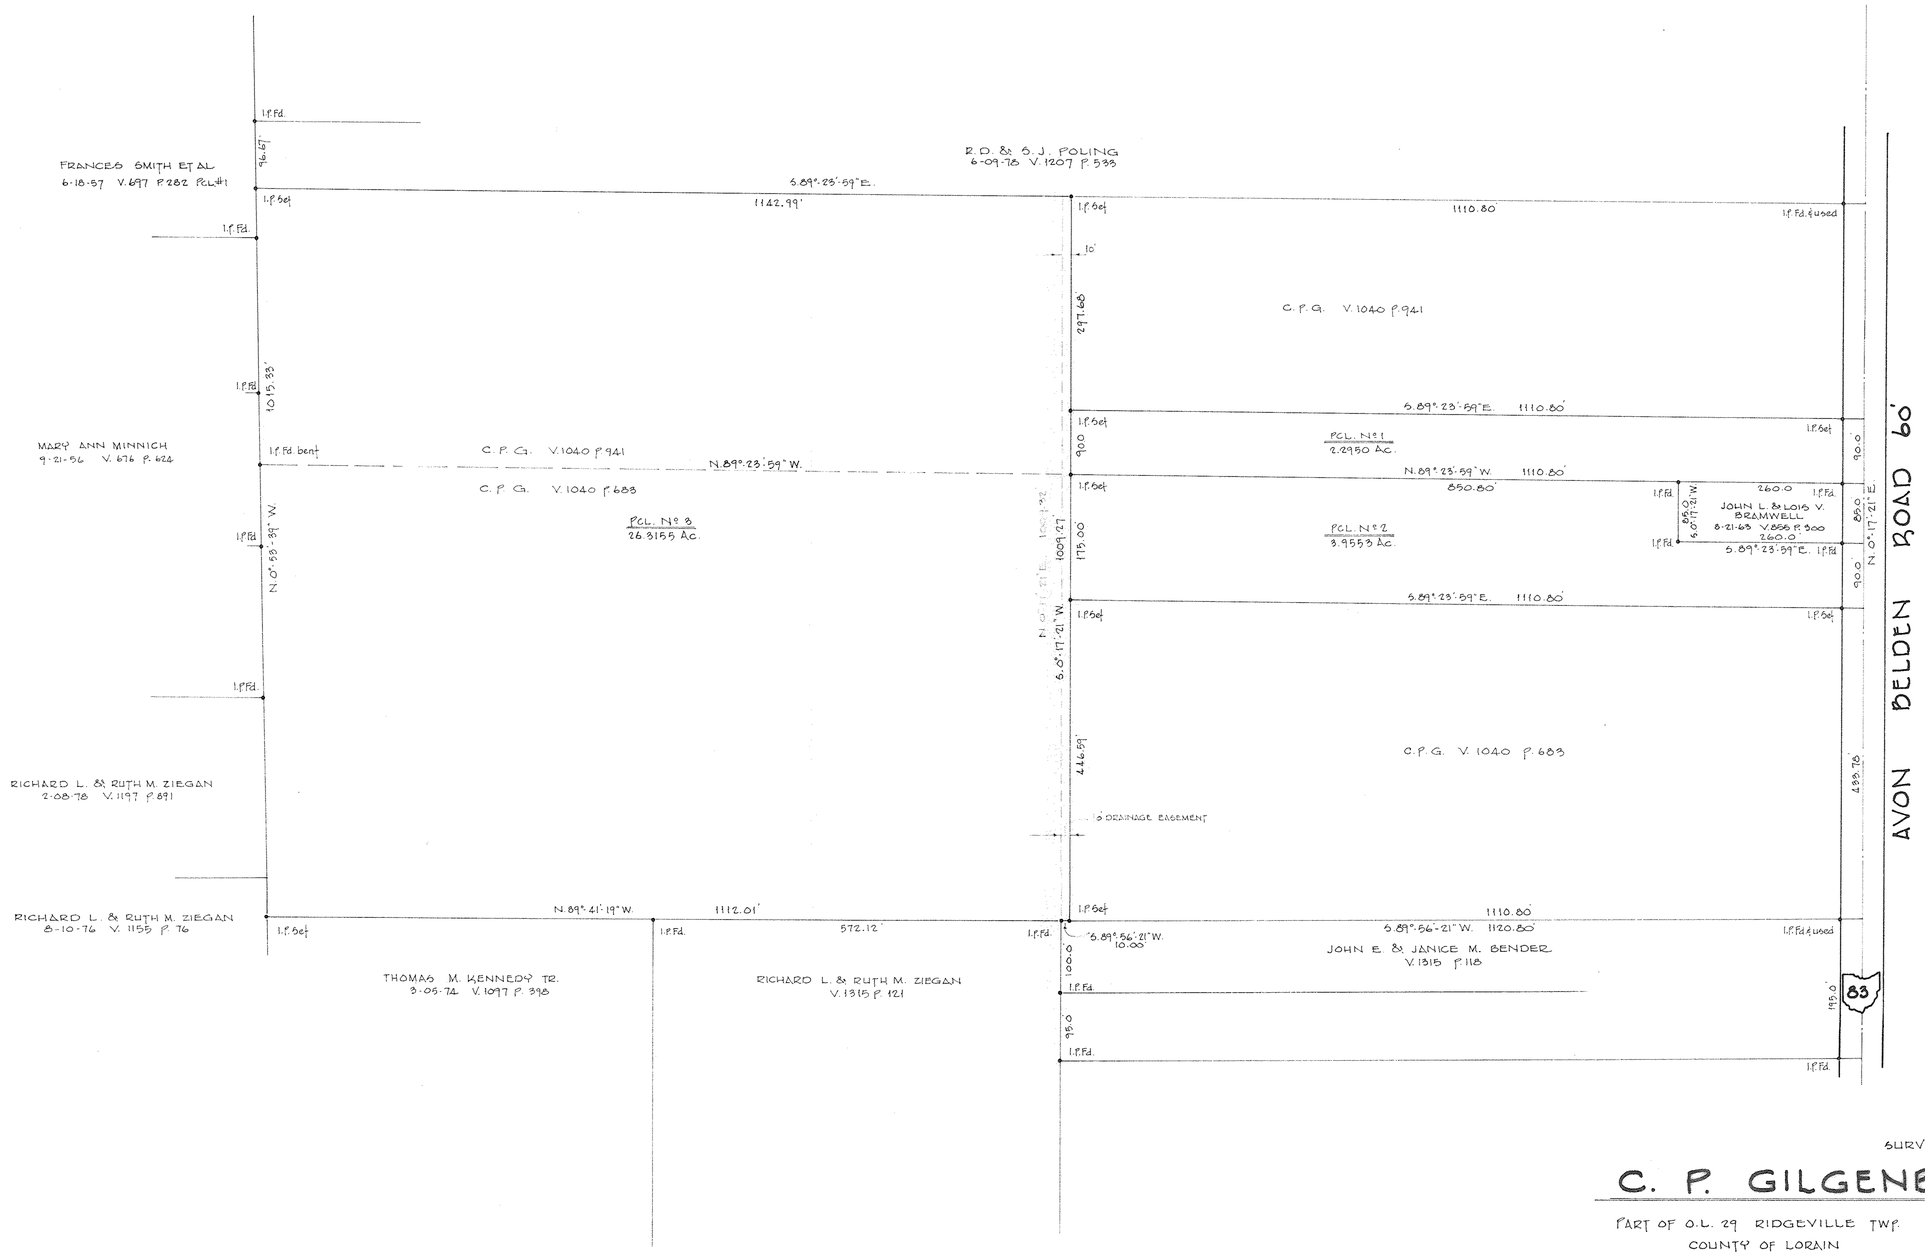

SURVEY OF

C. P. GILGENBACH LANDS

PART OF O.L. 29 RIDGEVILLE TWP. CITY OF NORTH RIDGEVILLE
COUNTY OF LORAIN STATE OF OHIO
SCALE 1"=100' JAN. 9, 1985
LAUNDON • SIMON • CAHL & ASSOC.
ENGINEERS SURVEYORS
JOB Nº 84-1342 F.B. 98 P. 58

REV. 5-22-90 10' UE EASMT

183