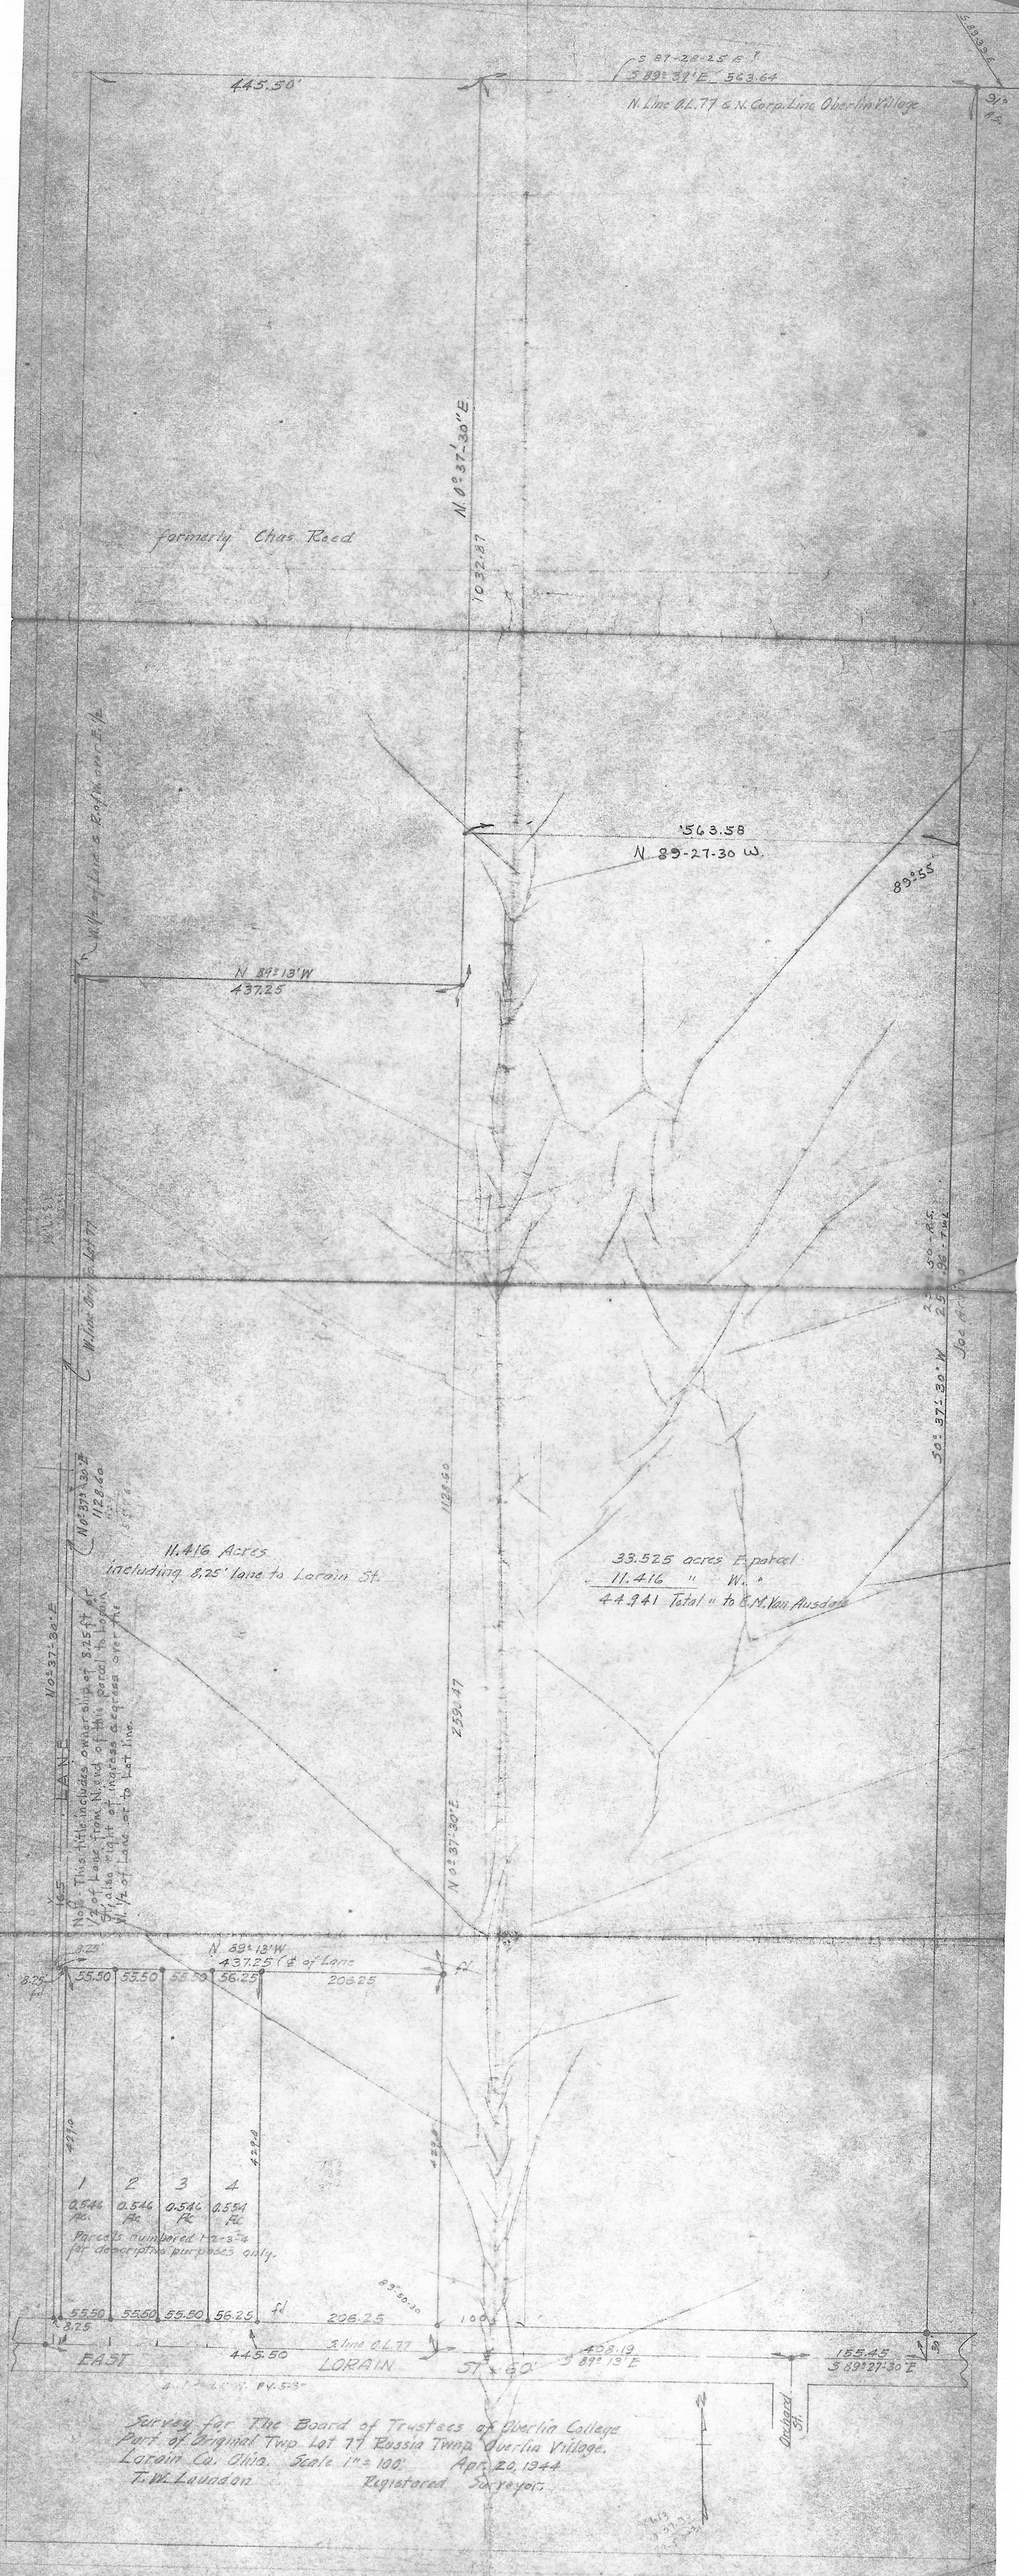
445.50'
S 87-28-25 E
S 89° 31' E 563.64
N. Line O.L. 77 & N. Corp. Line Oberlin Village
N 0° 37-30" E
formerly Chas. Reed
1032.87
563.58
N 89-27-30 W.
N 89° 13' W
437.25
W'ly of Line 5 Rods from E'ly
11.416 Acres
including 8.25' lane to Lorain St.
33.525 acres E parcel
11.416 " W. "
44.941 Total " to E.M. Van Ausdal
1158.60
2590.37
N 0° 37-30" E
LANE
Note: This title includes overslip of 8.25 ft. on E. of Lane from N. end of this parcel to Lorain St. also "right of ingress & egress over the W. 1/4 of Lane as to Lot line.
N 89° 13' W
437.25 (E of Lane
55.50
55.50
55.50
56.25
206.25
8.25
1
2
3
4
0.546 Ac.
0.546 Ac
0.546 Ac
0.554 Ac
Parcels numbered 1-2-3-4 for description purposes only.
445.50
3 line O.L. 77
LORAIN
ST. 60'
408.19
S 89° 13' E
155.45
S 89° 27-30 E
EAST
Dedicated St.
Survey for The Board of Trustees of Oberlin College
Part of Original Twp Lot 77 Russia Twnp. Oberlin Village.
Lorain Co. Ohio. Scale 1" = 100'
Apr. 20, 1944
T. W. Laundon
Registered Surveyor.