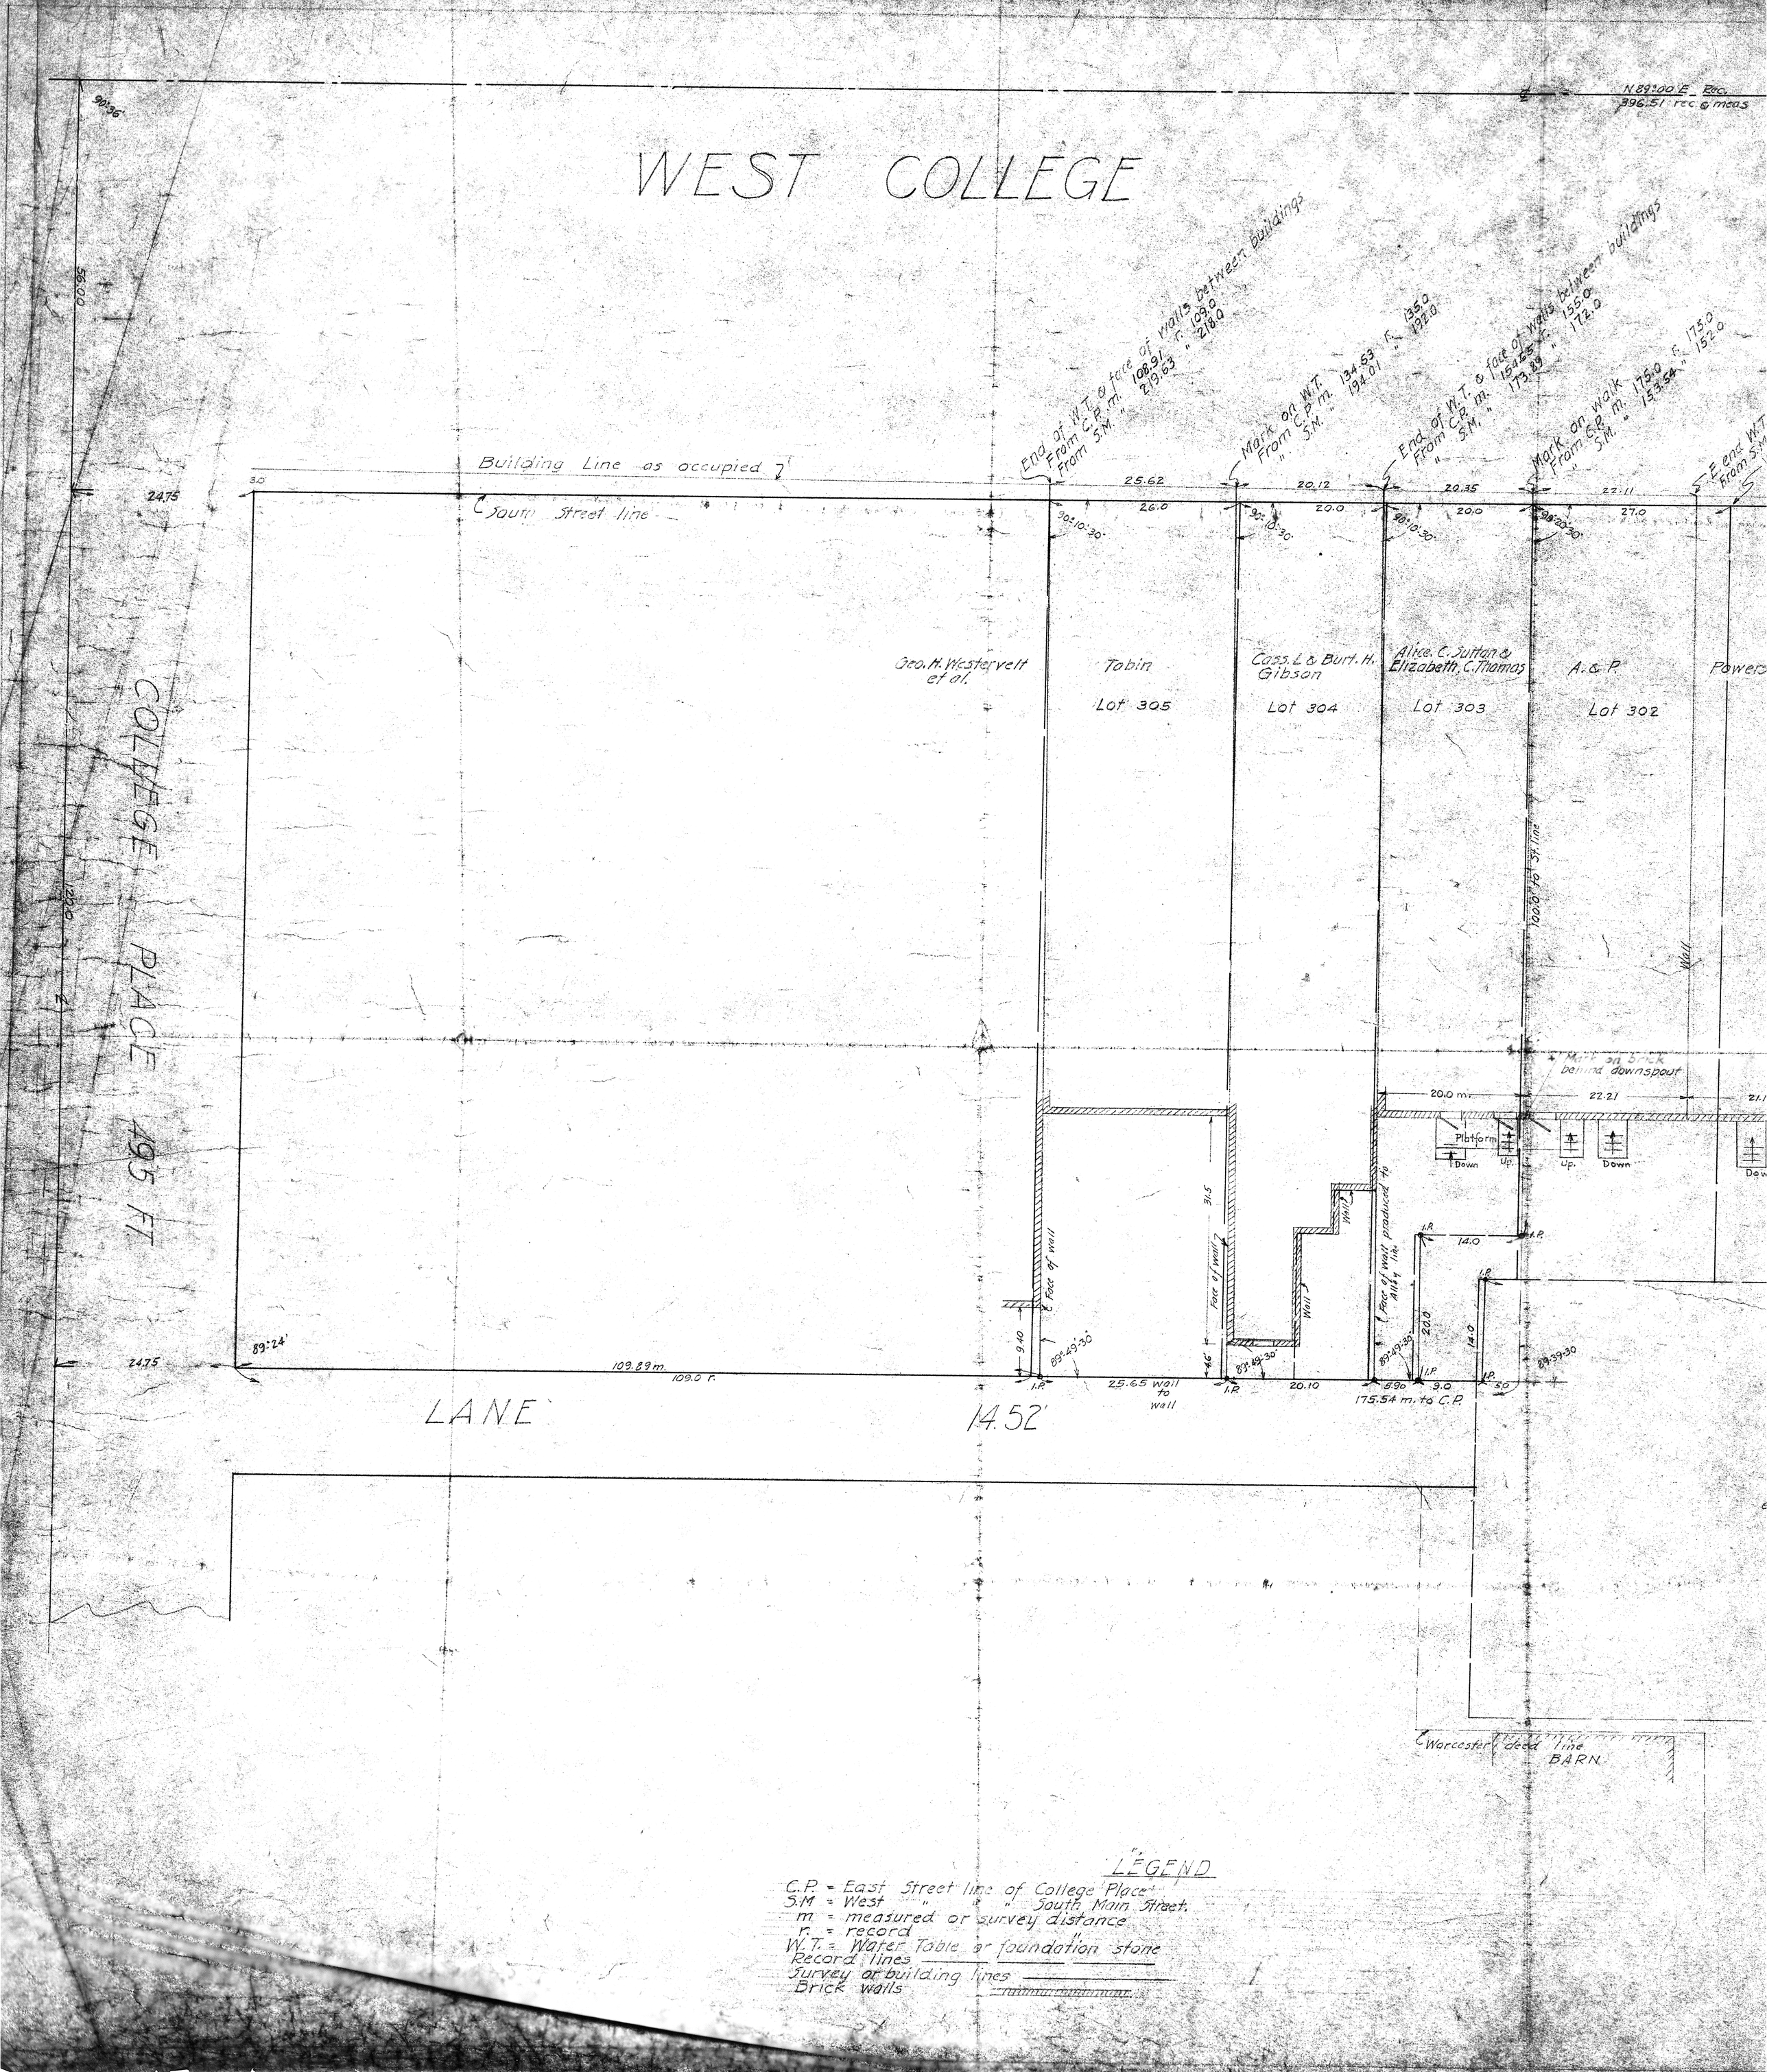
WEST COLLEGE
N 89°00' E Rec.
396.51 rec & meas
90°36'
56.00
Building Line as occupied
24.75
30
South Street line
End of W.T. & face of walls between buildings
From C.P. m. 108.91 r. 109.0
" S.M. " 219.63 " 218.0
Mark on W.T.
From C.P. m. 134.53 r. 135.0
" S.M. " 194.01 " 192.0
End of W.T. & face of walls between buildings
From C.P. m. 154.65 r. 155.0
" S.M. " 173.89 " 172.0
Mark on walk
From C.P. m. 175.0 r. 175.0
" S.M. " 153.54 " 152.0
End W.T.
From S.M.
25.62
26.0
20.12
20.0
20.35
20.0
22.11
27.0
90°10'30"
90°10'30"
90°10'30"
90°20'30"
Geo. H. Westervelt et al.
Tobin
Lot 305
Cass. L. & Burt. H. Gibson
Lot 304
Alice C. Sutton & Elizabeth C. Thomas
Lot 303
A. & P.
Lot 302
Power
Wall
Mark on Brick behind downspout
20.0 m.
22.21
Platform
Down
Up.
Up.
Down
Face of wall
31.5
Face of wall produced to Alley line
Wall
Wall
I.P.
14.0
20.0
14.0
9.40
89°49'30"
4.6
89°49'30"
89°49'30"
89°39'30"
89°24'
24.75
109.89 m.
109.0 r.
25.65 wall to wall
20.10
6.90
9.0
5.0
175.54 m. to C.P.
COLLEGE PLACE 495 FT.
LANE
14.52'
Worcester deed line
BARN
LEGEND
C.P. = East Street line of College Place
S.M = West " " South Main Street.
m = measured or survey distance
r. = record "
W.T. = Water Table or foundation stone
Record lines
Survey or building lines
Brick walls