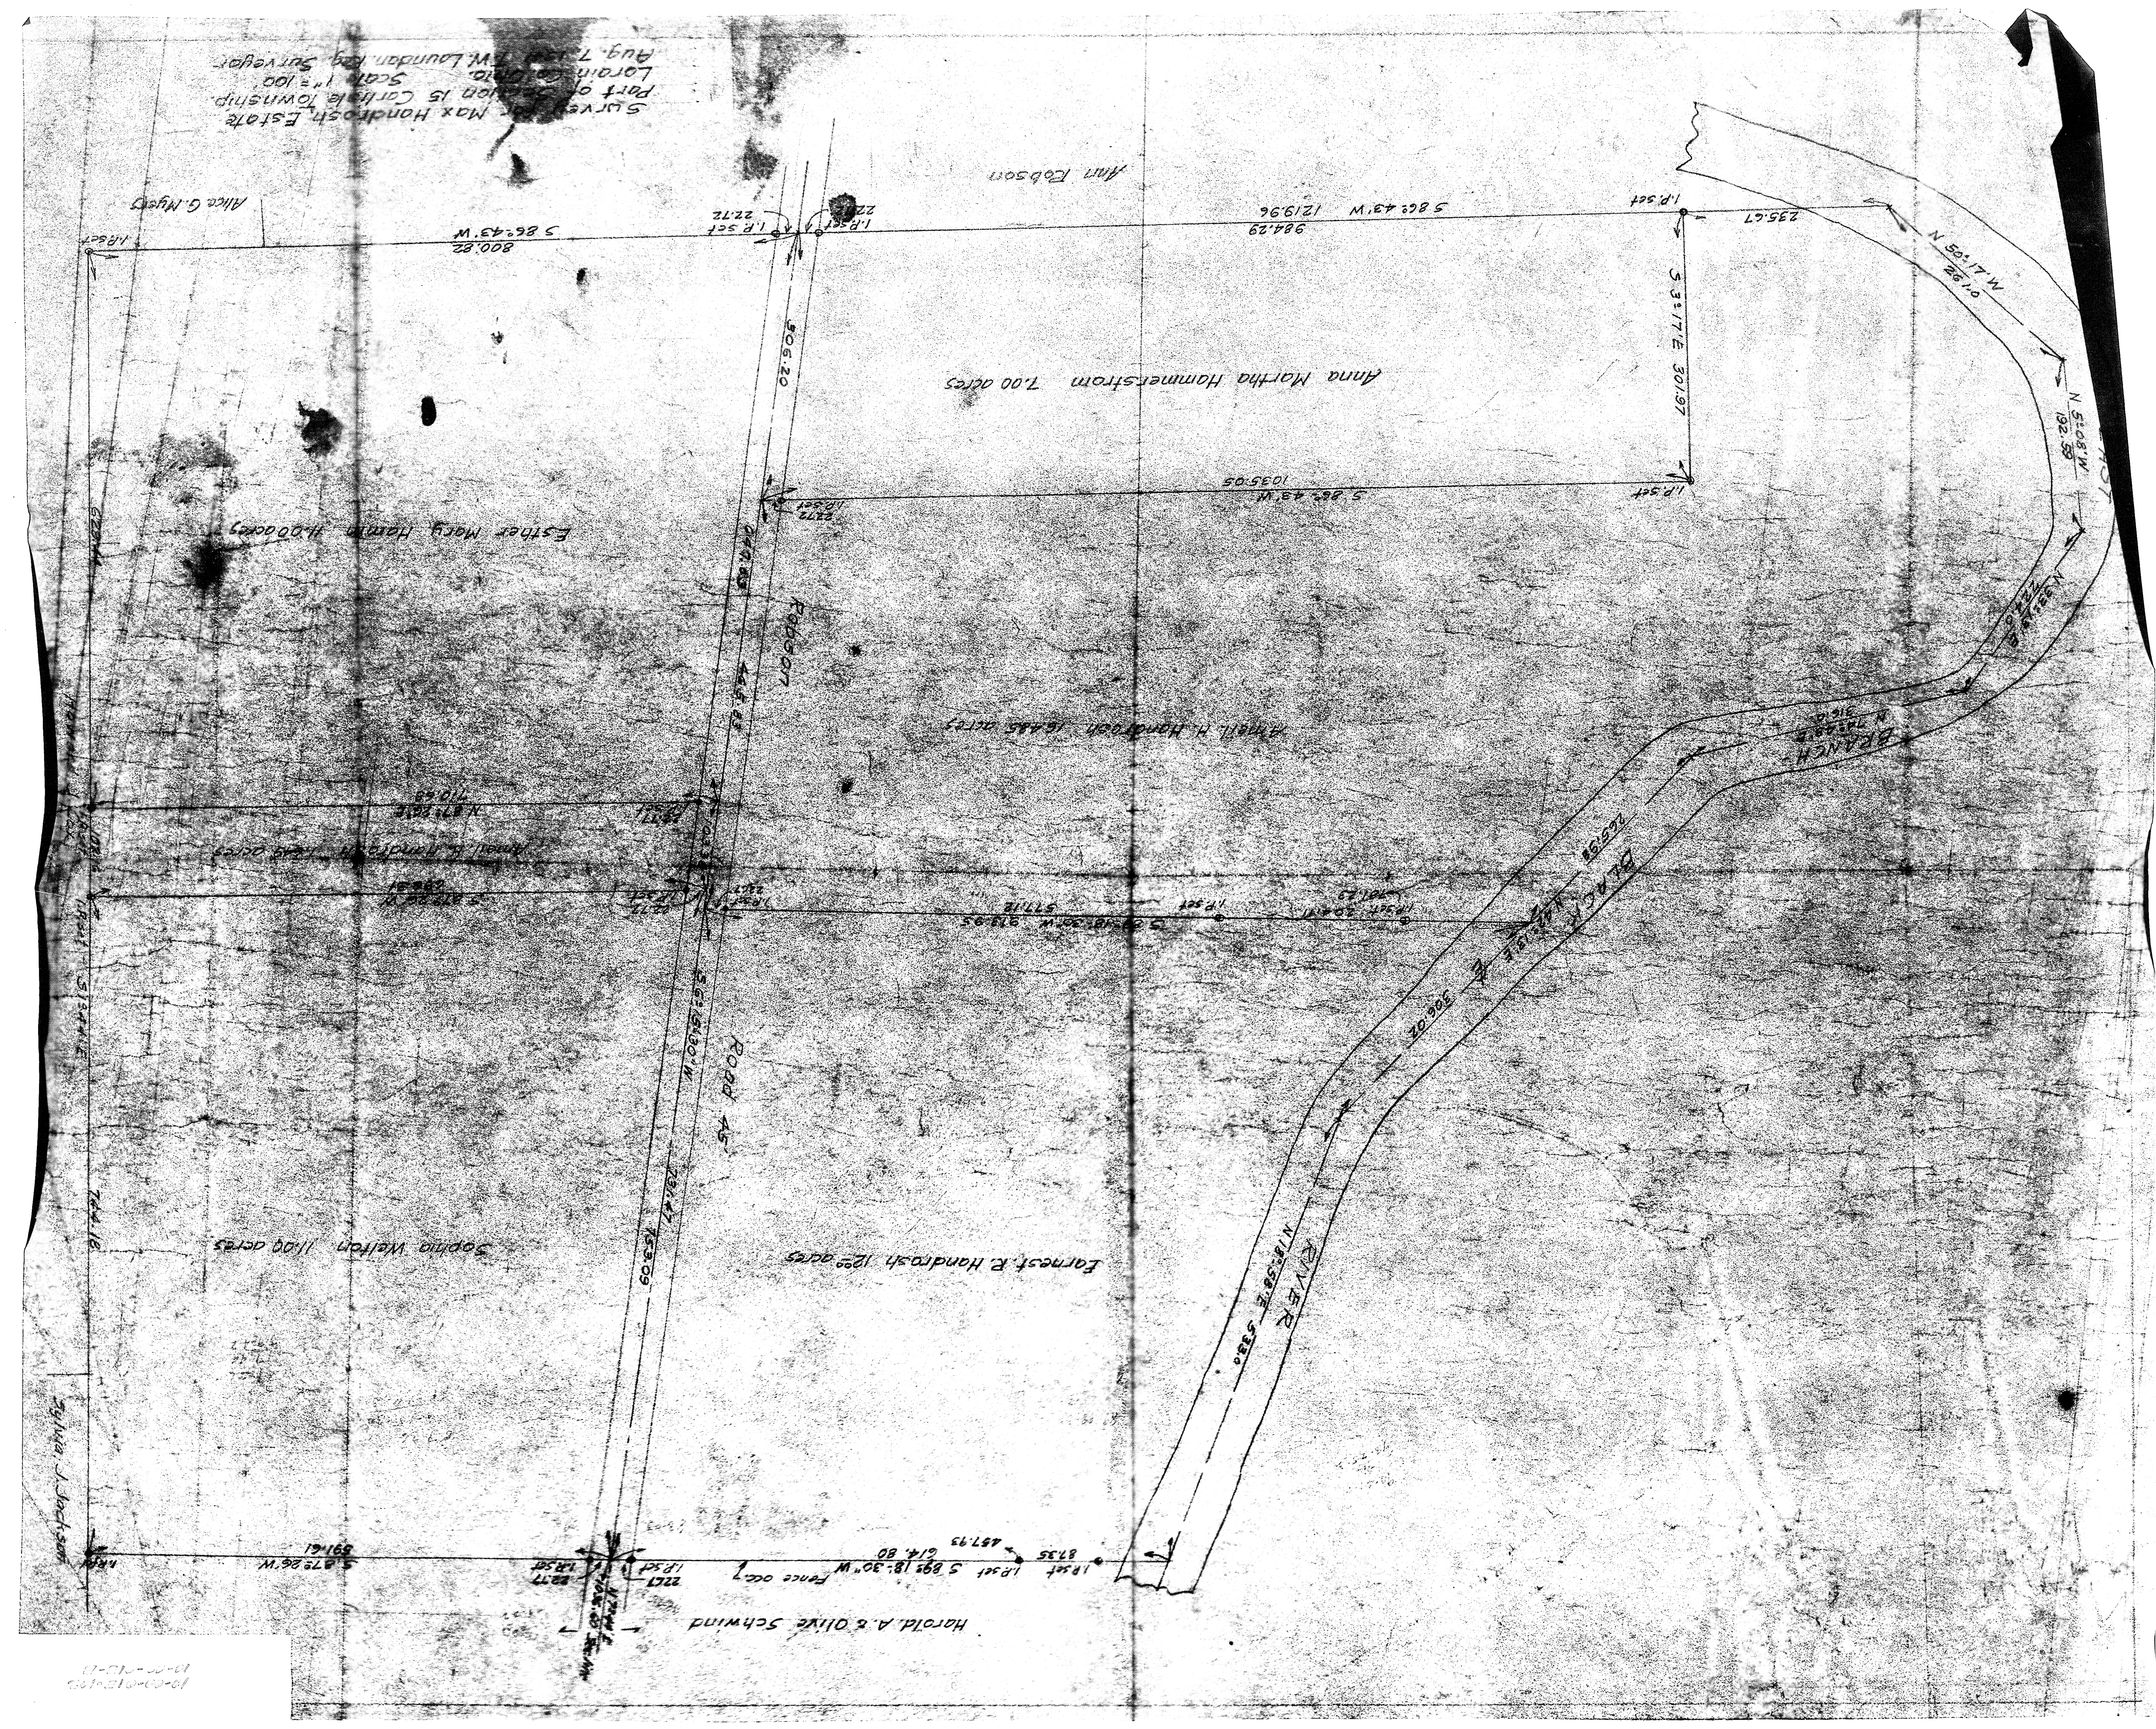

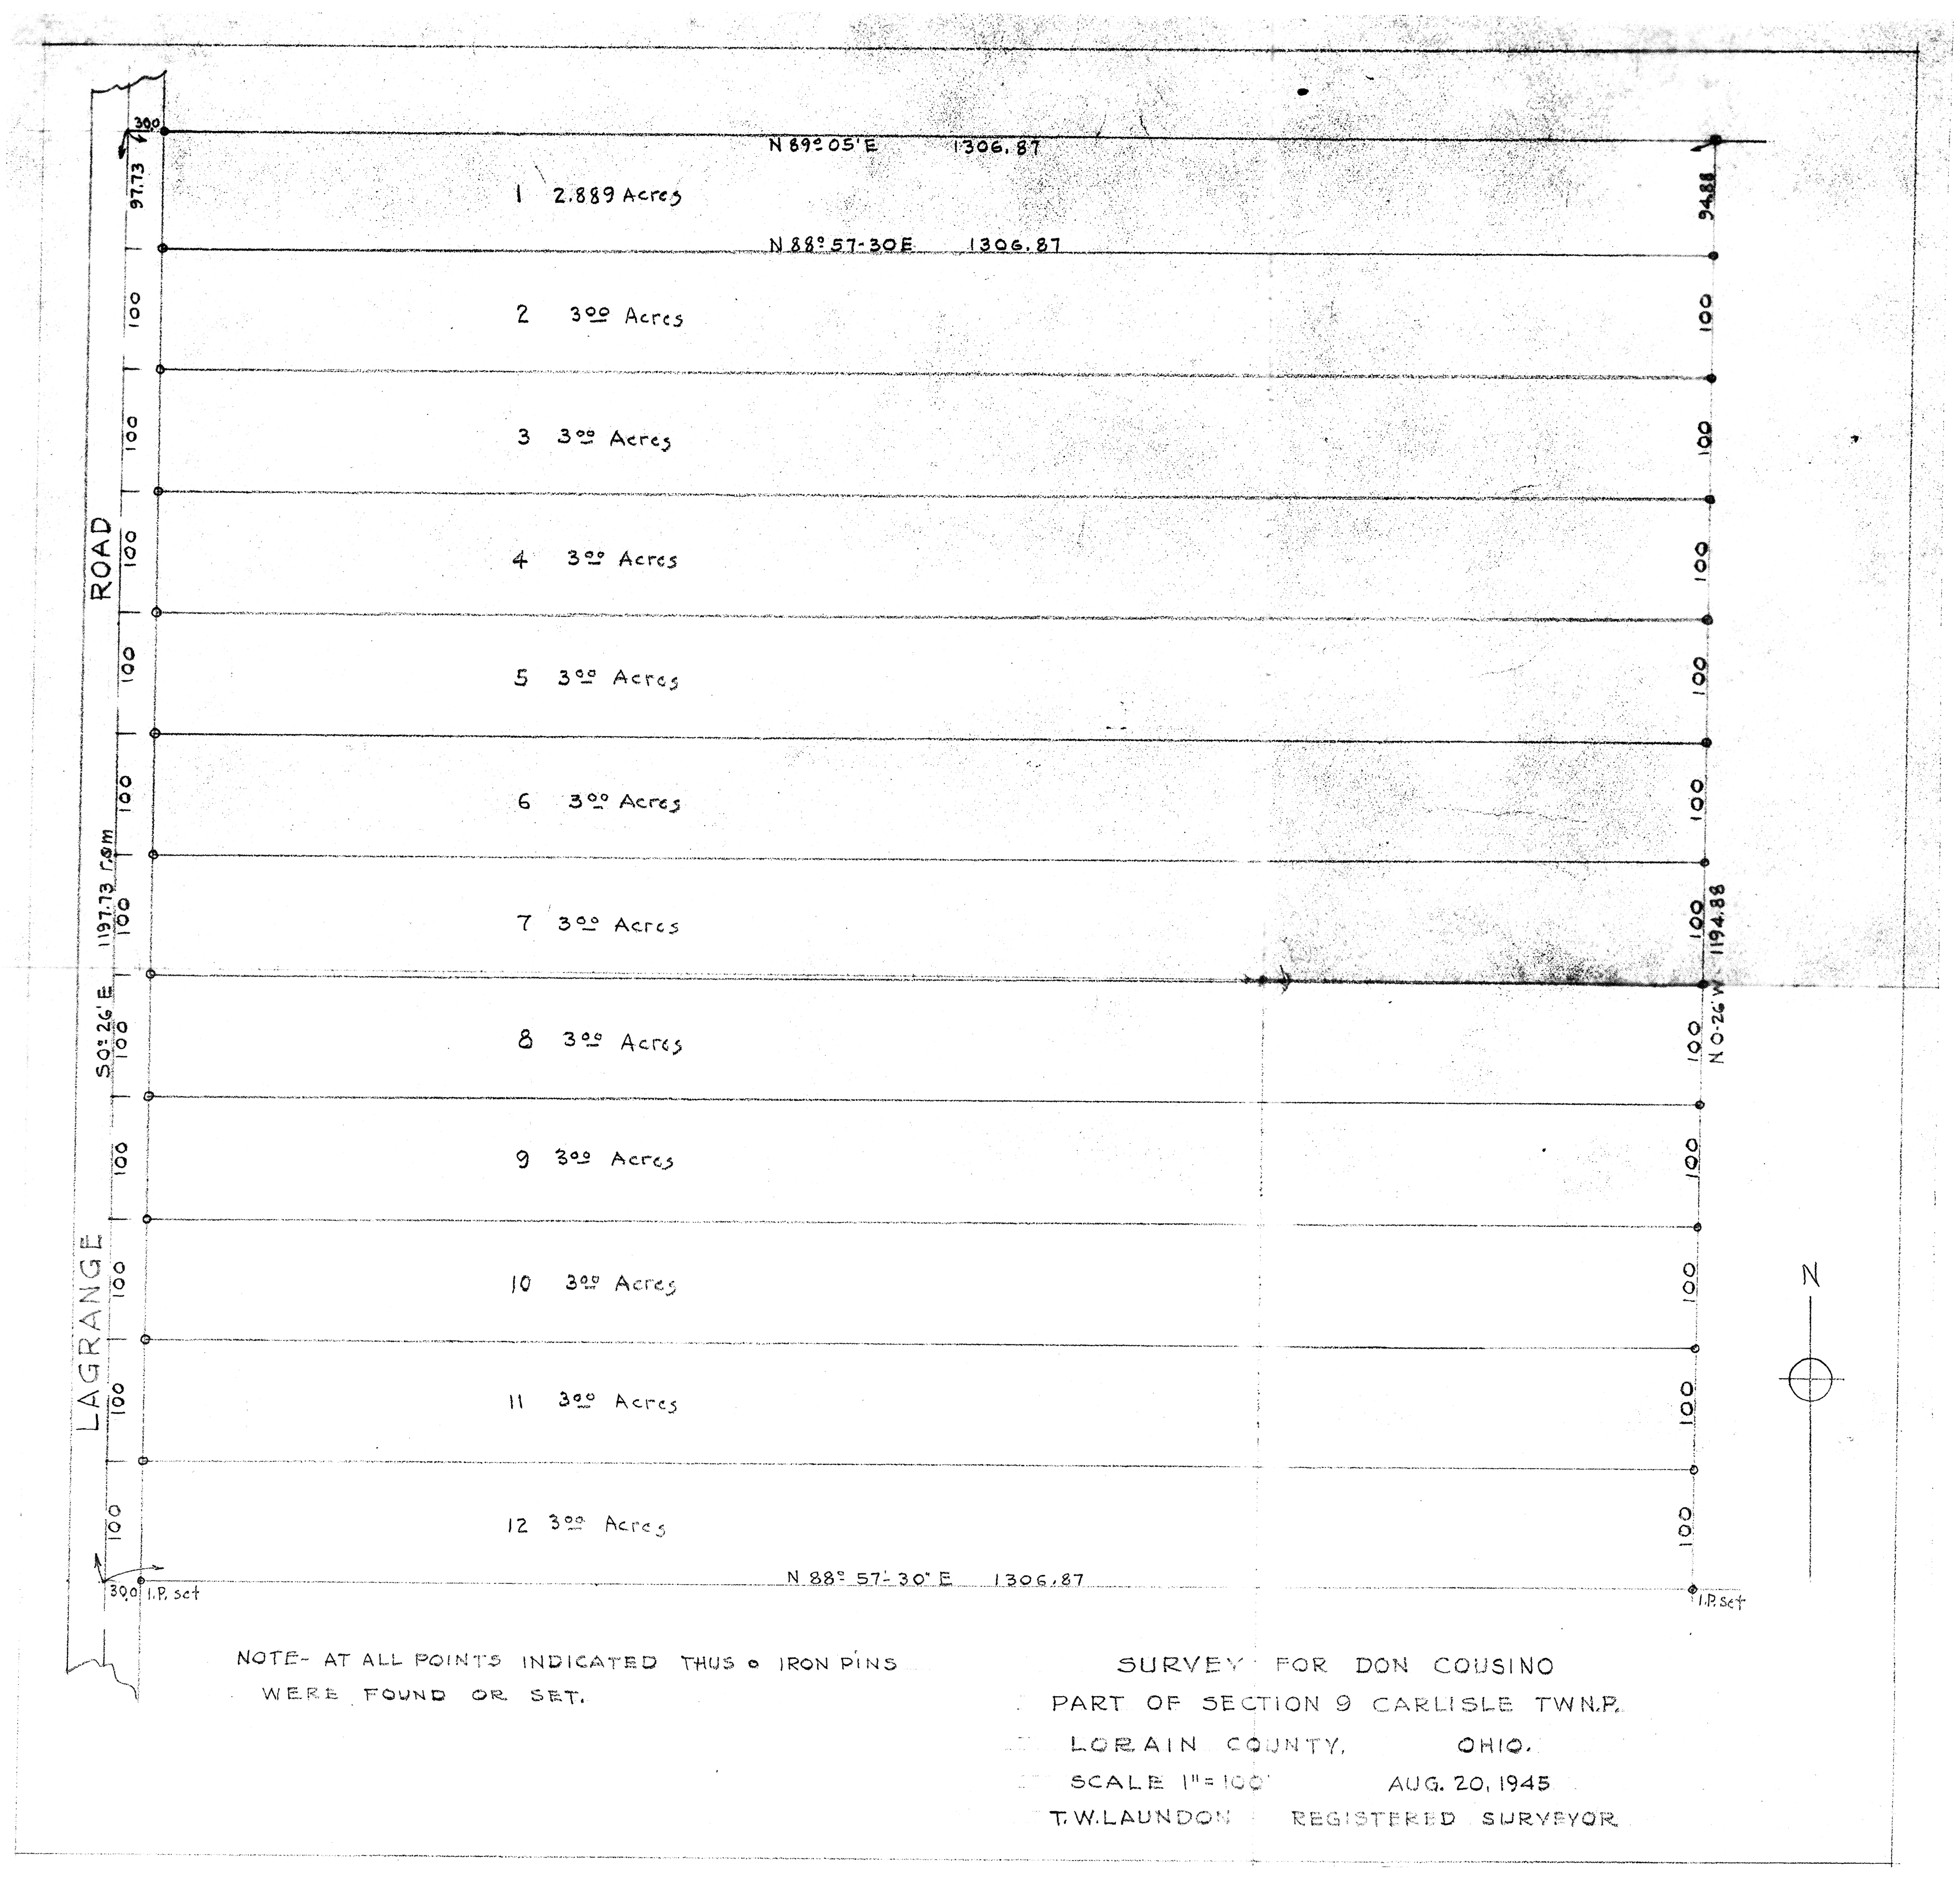

NOTE- AT ALL POINTS INDICATED THUS o IRON PINS WERE FOUND OR SET.

SURVEY FOR DON COUSINO
PART OF SECTION 9 CARLISLE TWN.P.
LORAIN COUNTY, OHIO.
SCALE 1"=100' AUG. 20, 1945
T.W. LAUNDON REGISTERED SURVEYOR

PPN 10-00-008-117-???
10-00-015-102-???
MAP 09 10-00-008-6
10-00-015-B
4471