9-E, 9-F, 9-G
9-00-073-B,-077-B,-083-B
9-00-086-B,-087-A,-094-A&B
9-00-095-A&B,-096-A&B,-103

4407

SURVEY:
THE PENN CENTRAL RAILROAD
25.6931 ACRES

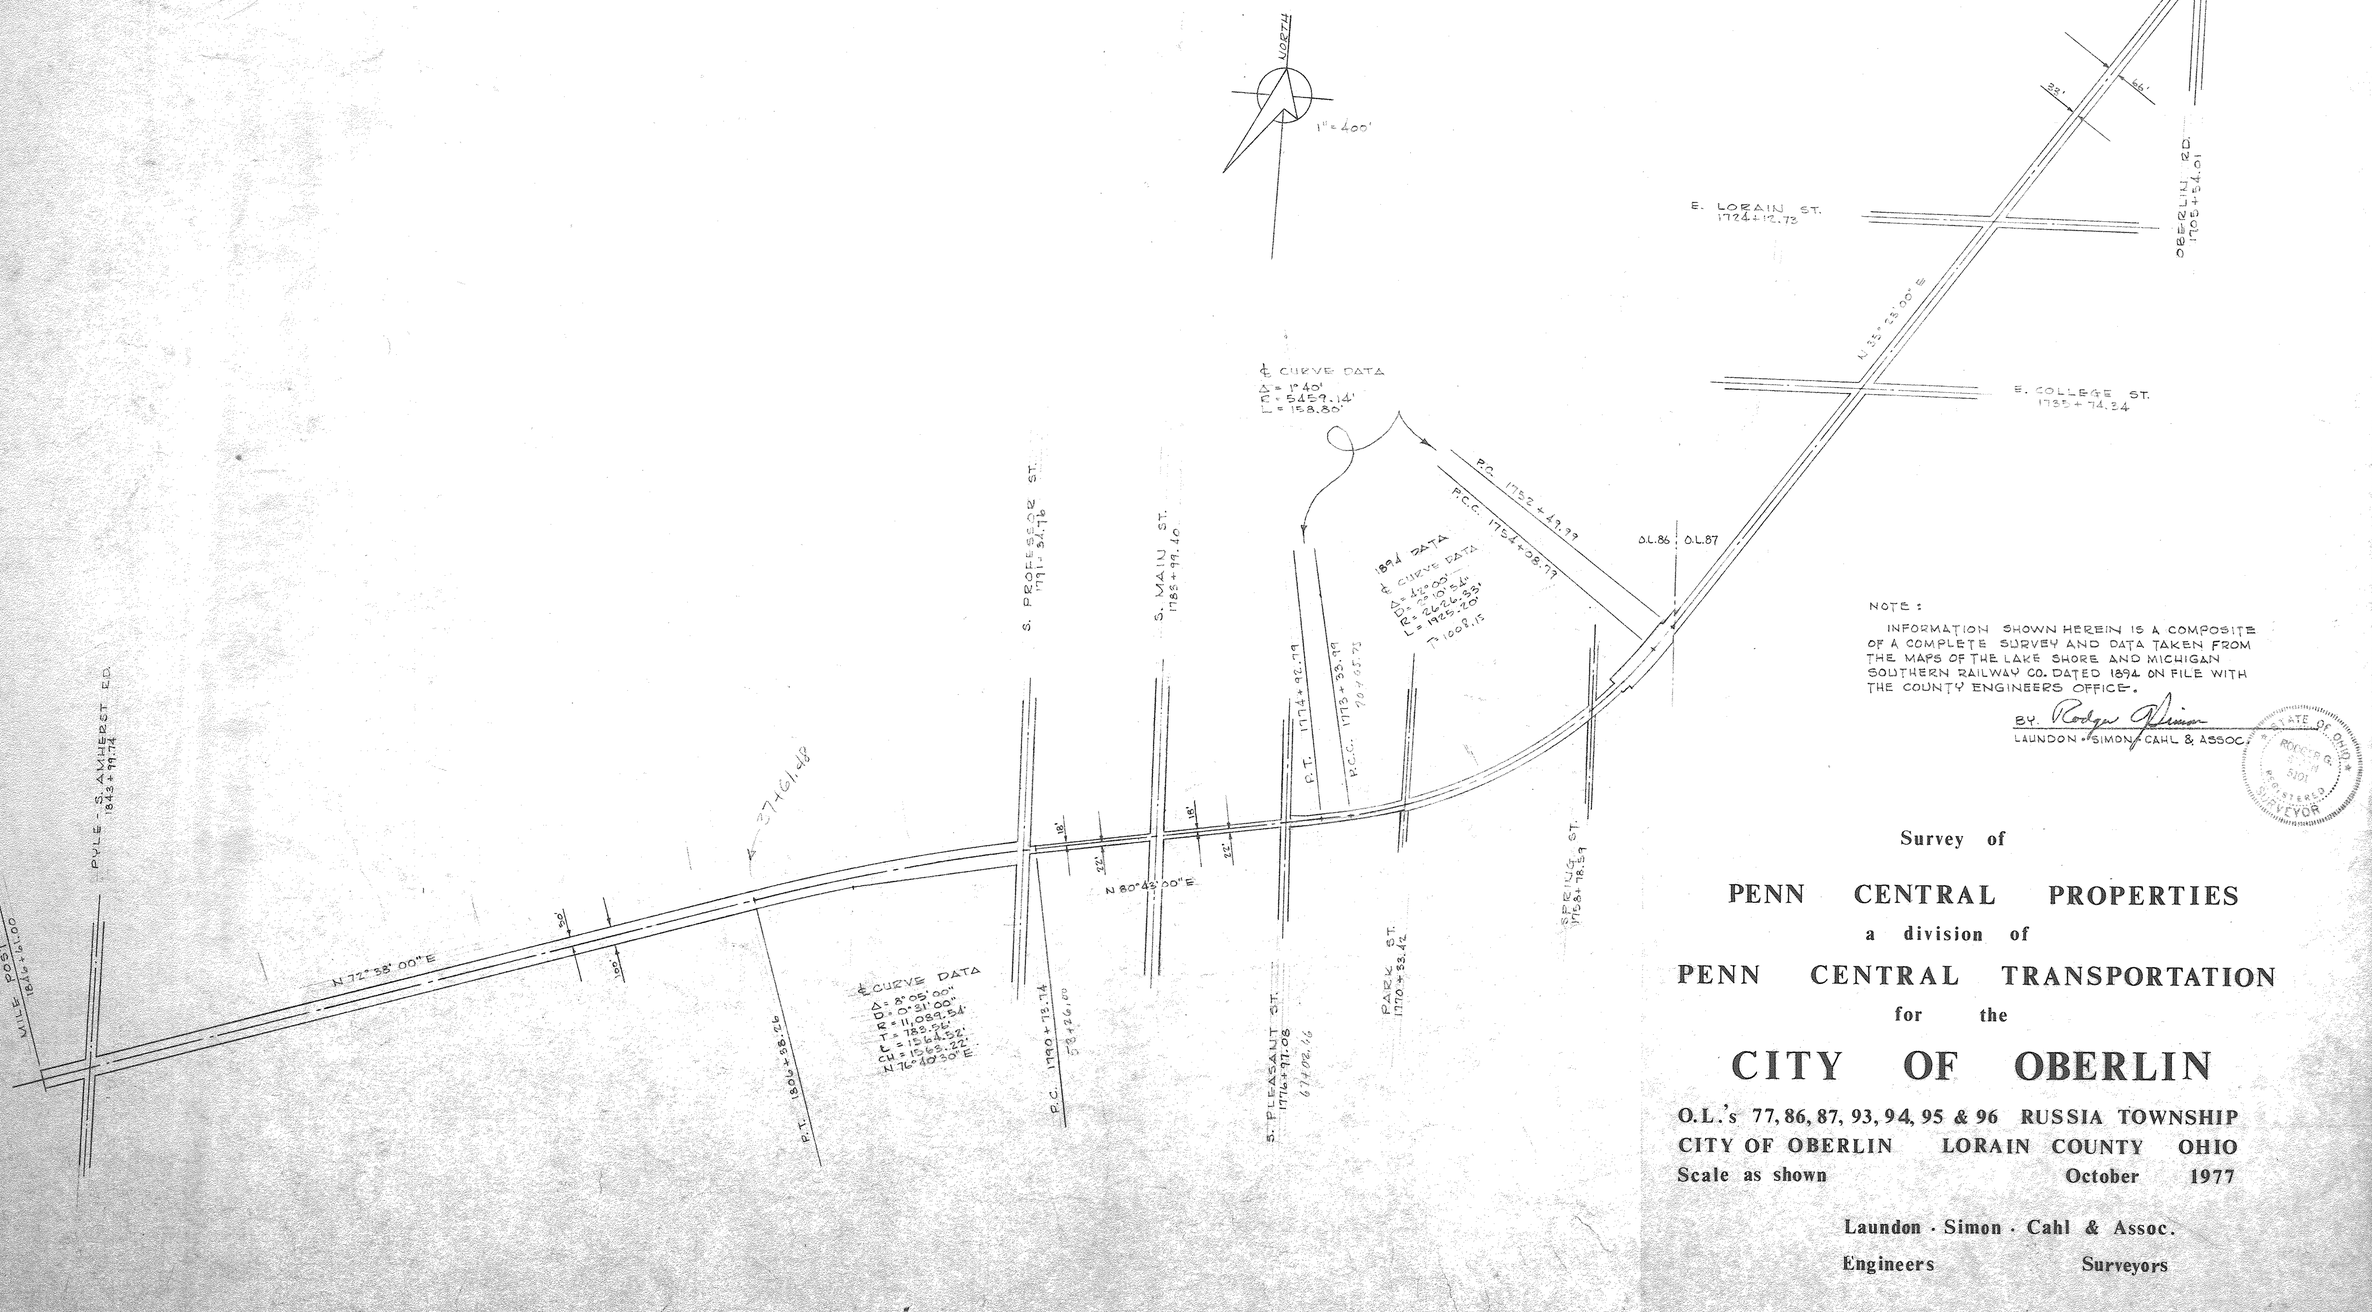

Survey of

PENN CENTRAL PROPERTIES

a division of

PENN CENTRAL TRANSPORTATION

for the

CITY OF OBERLIN

O.L.'s 77, 86, 87, 93, 94, 95 & 96 RUSSIA TOWNSHIP
CITY OF OBERLIN LORAIN COUNTY OHIO
Scale as shown October 1977

Laundon · Simon · Cahl & Assoc.
Engineers Surveyors

Revised 11-23-77 Sheets 3 and 4 R.G.S.

Job No. 77-1.44