LOT SPLIT

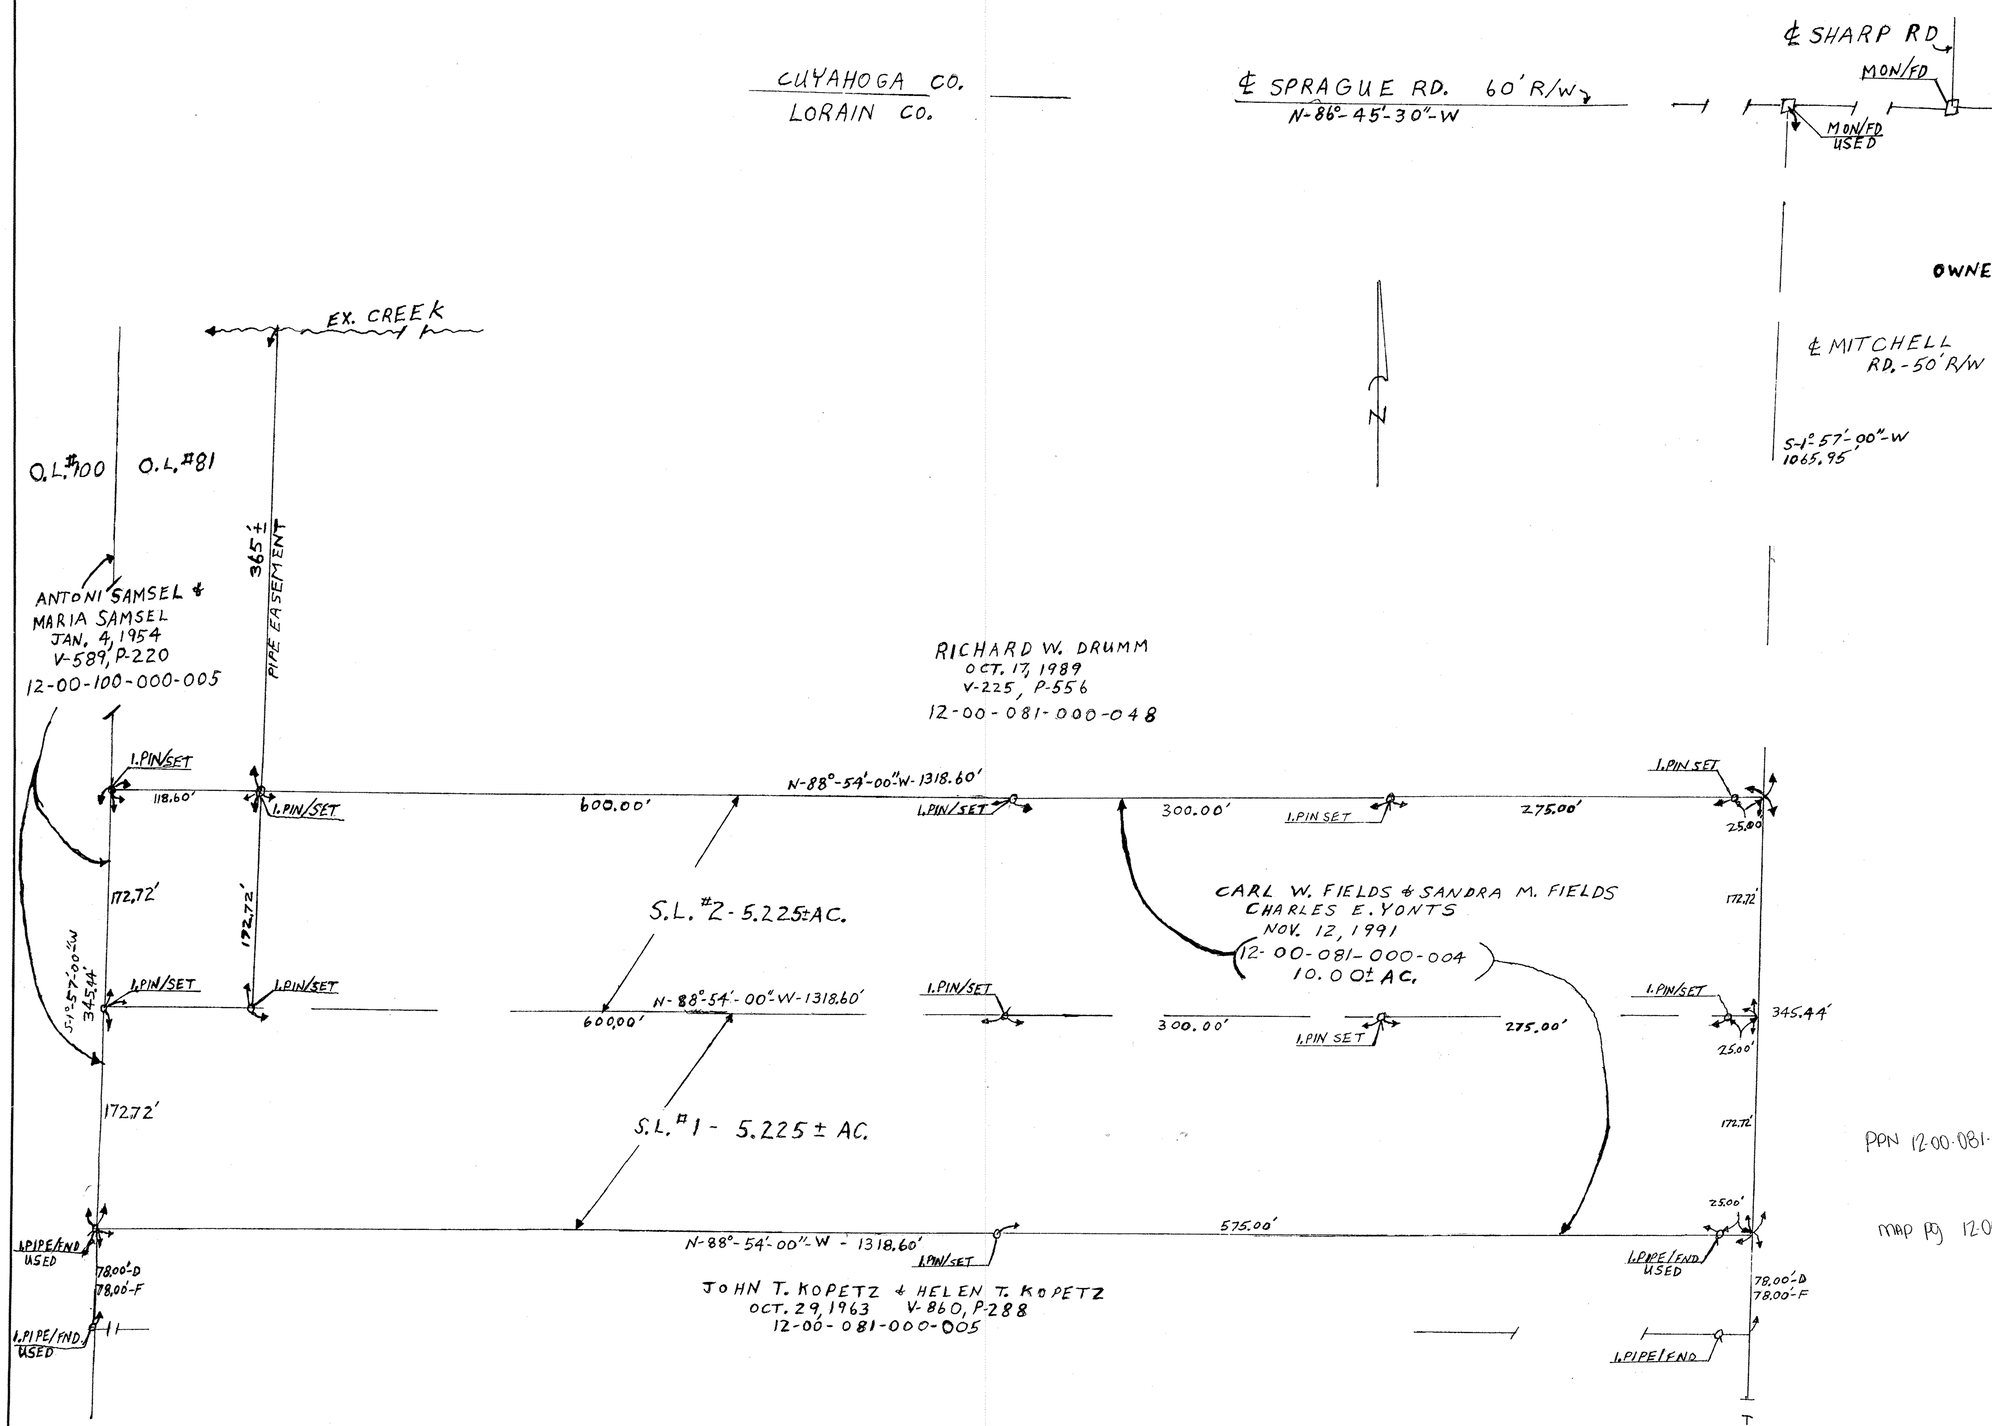

LOT SPLIT

OF LAND OWNED BY

CARL W. FIELDS AND SANDRA M. FIELDS

CHARLES E. YONTS

SITUATED IN THE TOWNSHIP OF COLUMBIA, COUNTY OF LORAIN, STATE OF OHIO, AND PART OF ORIGINAL LOT NO. 81, P.P. NO. 12-00-081-000-004

ACCEPTANCE

WE THE UNDERSIGNED, OWNER(S) OF THE WITHIN PLATTED LANDS, DO HEREBY ACCEPT THIS SURVEY AND PARTION OF SAME.

OWNER(S) _____ CARL W. FIELDS _____ SANDRA M. FIELDS

_____ CHARLES E. YONTS _____ WITNESS

_____ WITNESS

COUNTY OF LORAIN
STATE OF OHIO

BEFORE ME, A NOTARY PUBLIC IN AND FOR SAID COUNTY AND STATE, PERSONALLY APPEARED THE ABOVE NAMED

_____ WHO ACKNOWLEDGED THE SIGNING OF THE FOREGOING INSTRUMENT, AND THAT THE SAME IS OF THEIR OWN FREE ACT AND DEED. IN TESTIMONY WHEREOF I HAVE HEREUNTO SET MY HAND AND OFFICIAL SEAL AT _____, OHIO, THIS _____ DAY OF _____, 199__

_____
NOTARY PUBLIC
MY COMMISSION EXPIRES

APPROVALS

THIS PLAT IS HEREBY APPROVED BY THE PLANNING COMMISSION OF THE COLUMBIA TOWNSHIP, THIS _____ DAY OF _____, 199__

_____

CERTIFICATION

DISTANCES SHOWN HERE ARE IN DECIMALS OF A FOOT AND ANGLES ARE A PART OF A CIRCLE, BEARINGS ARE TO AN ASSUMED MERIDIAN AND USED TO INDICATE ANGLES ALL OF WHICH I CERTIFY TO BE CORRECT.

Ronald D. Robison L.S. #5687
RONALD D. ROBISON
L.S. # 5687

STATE OF OHIO
RONALD DALE ROBISON
5687
REGISTERED LAND SURVEYOR

PPN 12-00-081-000-055
056

44097

MAP PG 12-00-081-A

CHARLES E. YONTS
9879 MITCHELL
COLUMBIA TWSH.

SCALE: 1 = 60	APPROVED BY:	DRAWN BY R.D.R.
DATE: MAY 1, 1992		REVISED

LOT SPLIT: PP #12-00-081-000-004
STATE OF OHIO, COUNTY OF LORAIN, TOWNSHIP OF COLUMBIA, ORIGINAL LOT NO. 81

SURVEYED: R. D. ROBISON, L.S. #5687
25247 REDWOOD
BEREA FALLS, OHIO 44138

DRAWING NUMBER