9-00-106-000-048
9-00-106-A

PPN 09-00-106-000-048

MAP PG 09-00-106-A

44105

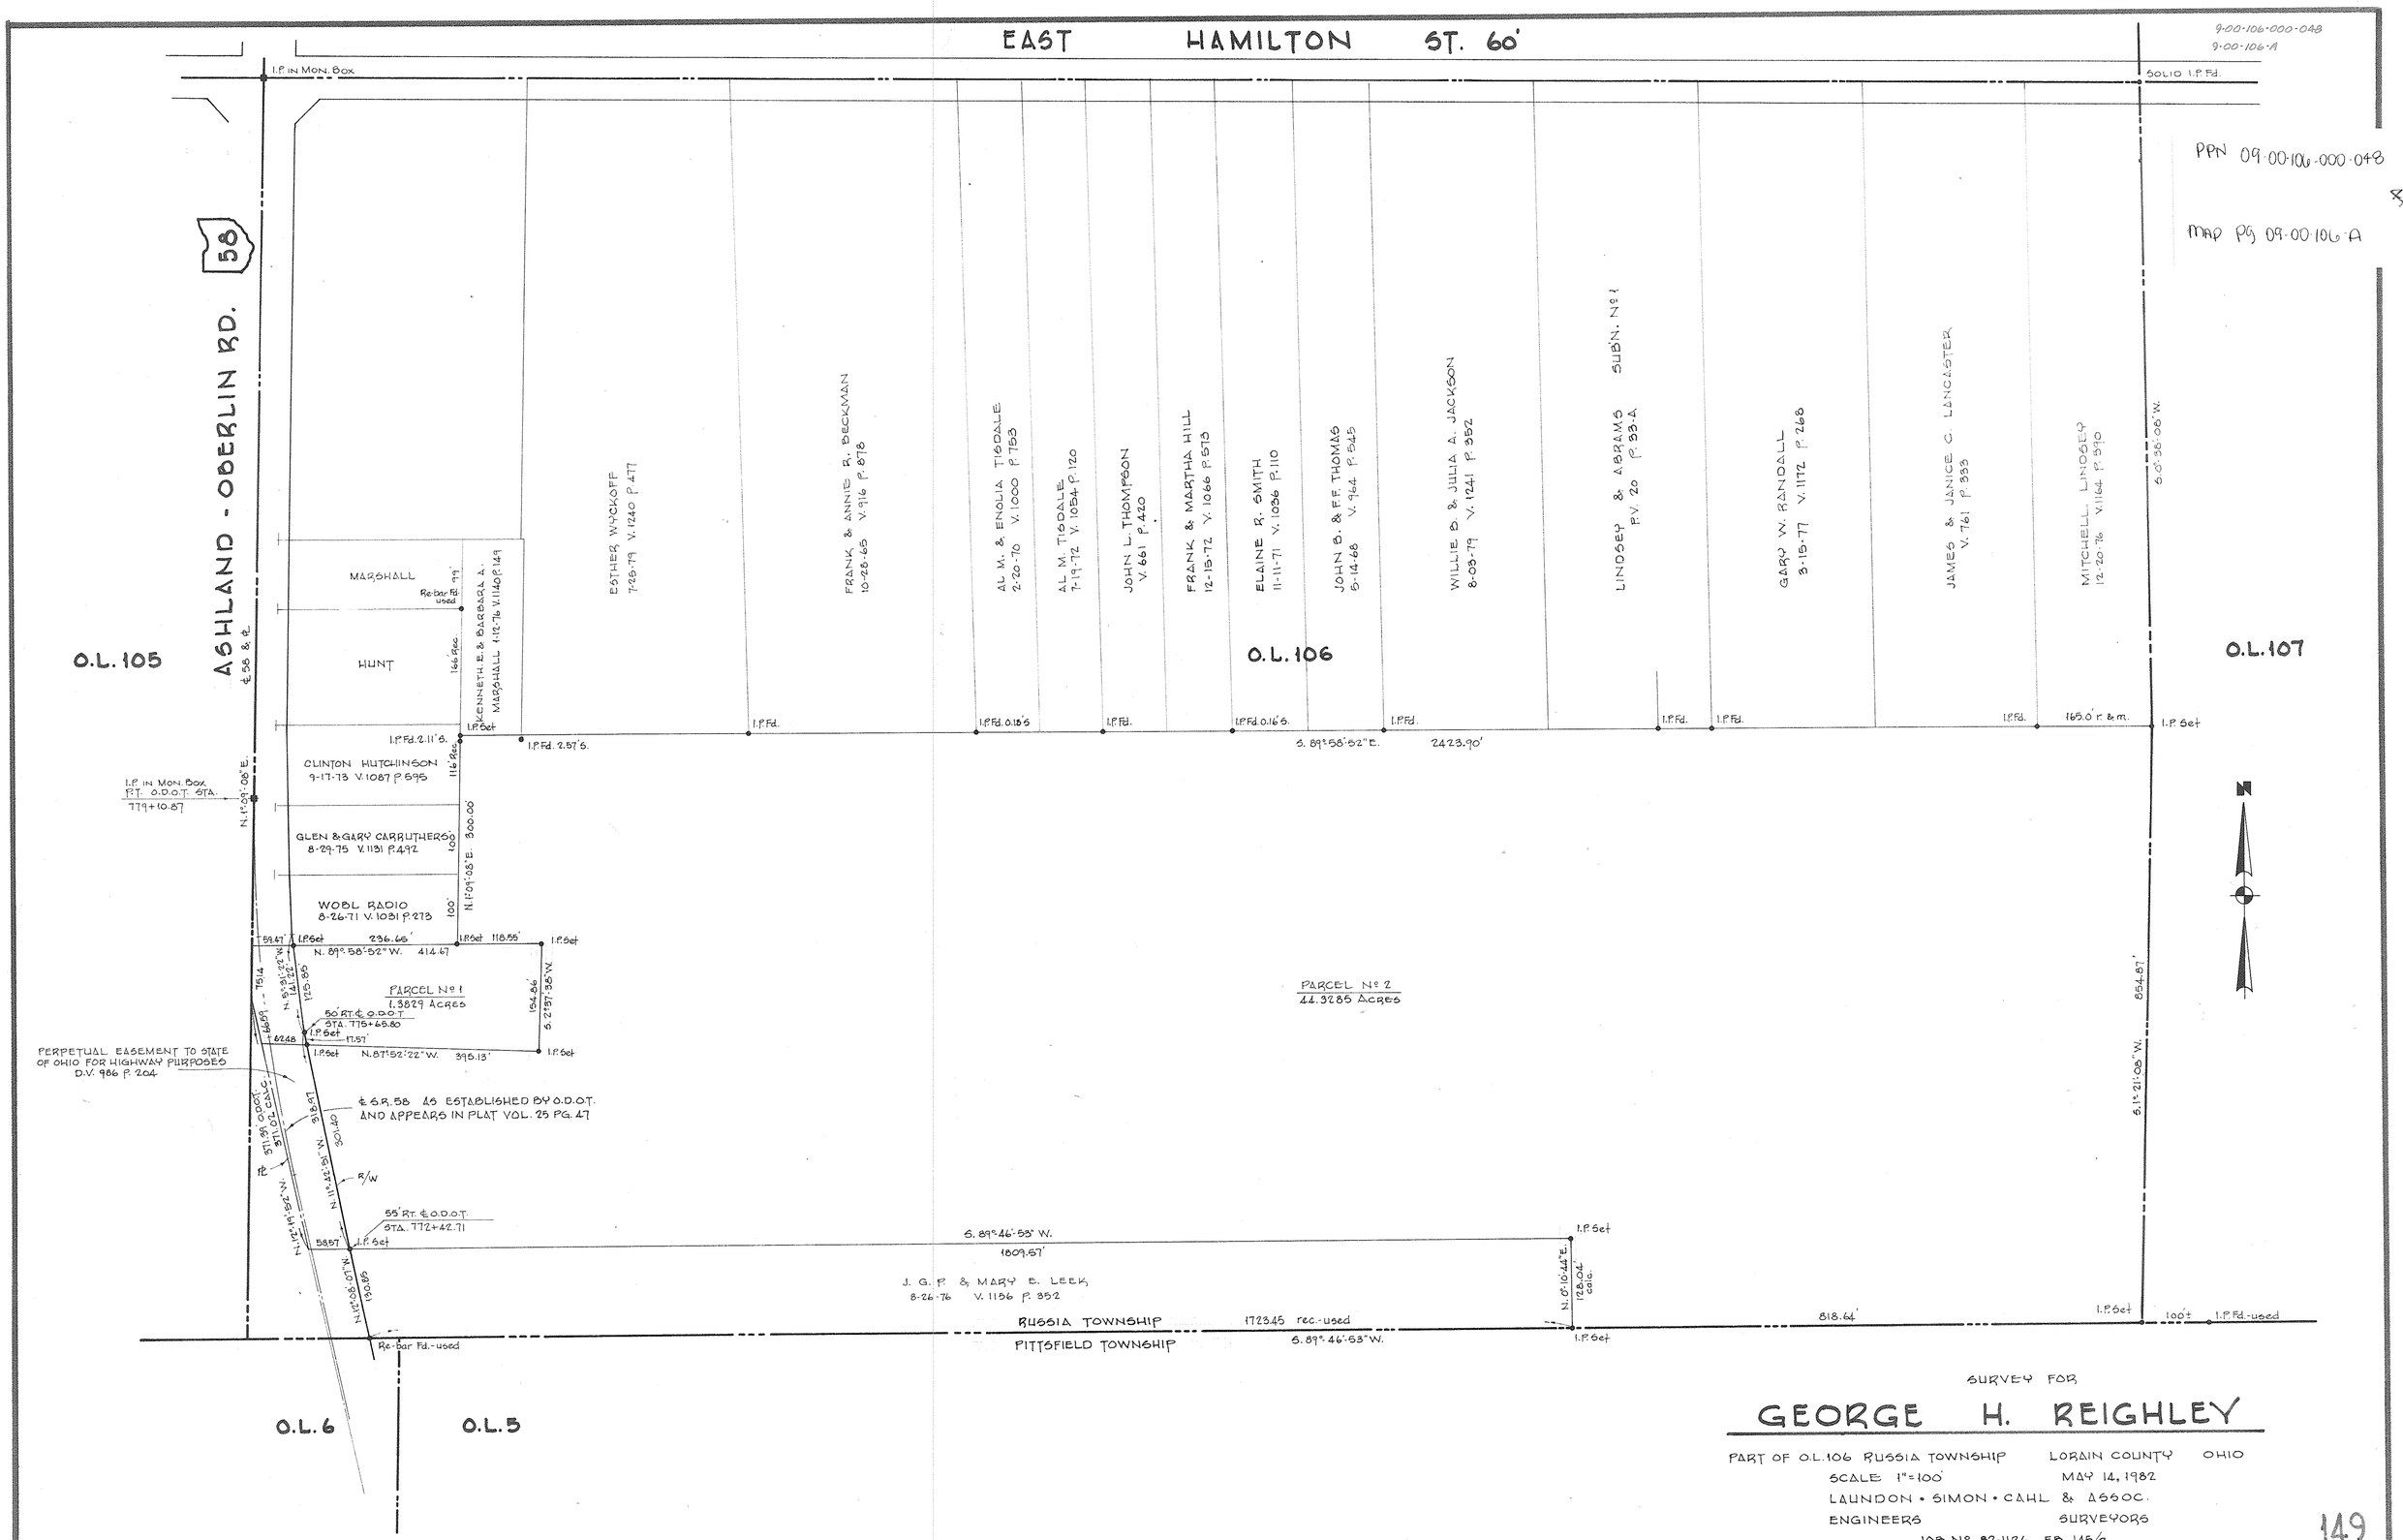

SURVEY FOR

GEORGE H. REIGHLEY

PART OF O.L. 106 RUSSIA TOWNSHIP LORAIN COUNTY OHIO

SCALE 1" = 100' MAY 14, 1982

LAUNDON • SIMON • CAHL & ASSOC.

ENGINEERS SURVEYORS

JOB No. 82-1126 F.B. 145/2

149