


PPN 07-00-007-101-074

MAP PG 07-00-007-C
44132

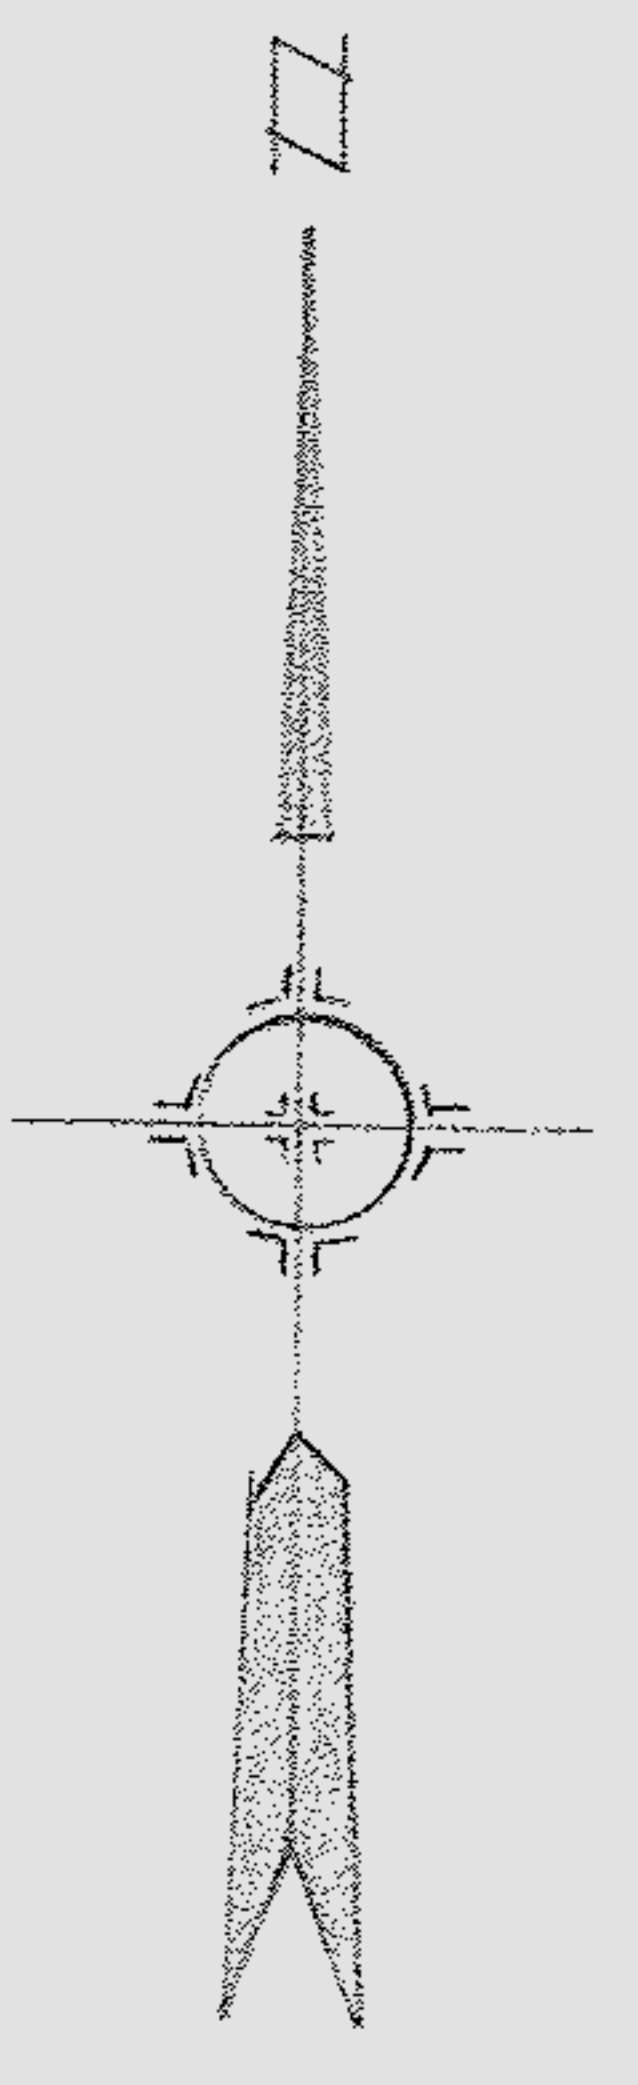

JAMES & CATHERINE M. KUBES
D.V. 434 PG. 449 3-15-48

S. 89° 20' W.

1129.03

PARCEL 3

PARCEL 2

PARCEL 1

N. 89° 11' 30" W.

1132.18

EXPAN. CONSTRUCTION CO.
D.V. 303 PG. 219 8-9-61

I.P. fd. 0.13 W.

S. 0° 41' 44" W.

I.P. fd. 0.12 N.

35.75

I.P. 281.58 r. & m.

I.P. Set

I.P. Set

I.P. Set 129.41 I.P. Set

N. 89° 18' 16" W.

HERMAN & MARGARET M.
COLEMAN D.V. 420 PG. 97
AUGUST 23, 1947

LEARNER ROAD 50'
S. 23° 59' 04" E.
309.89

EDWIN J. SNYDER
D.V. 537 PG. 527
N. 12° 11' 34" E.

364.55

I.P. fd. 0.33' W.

18
7
0
0

TOTAL ACREAGE 9.9161

SURVEY FOR
THE RIDGEVILLE BOARD OF EDUCATION
PART OF ORIGINAL LOTS 7 & 18 RIDGEVILLE TOWNSHIP
CITY OF NORTH RIDGEVILLE - LOBAIN COUNTY - OHIO
SCALE 1"=60'
LAUNDON, HUFFMAN & SIMON
NOVEMBER 1964
REG. SURVEYORS