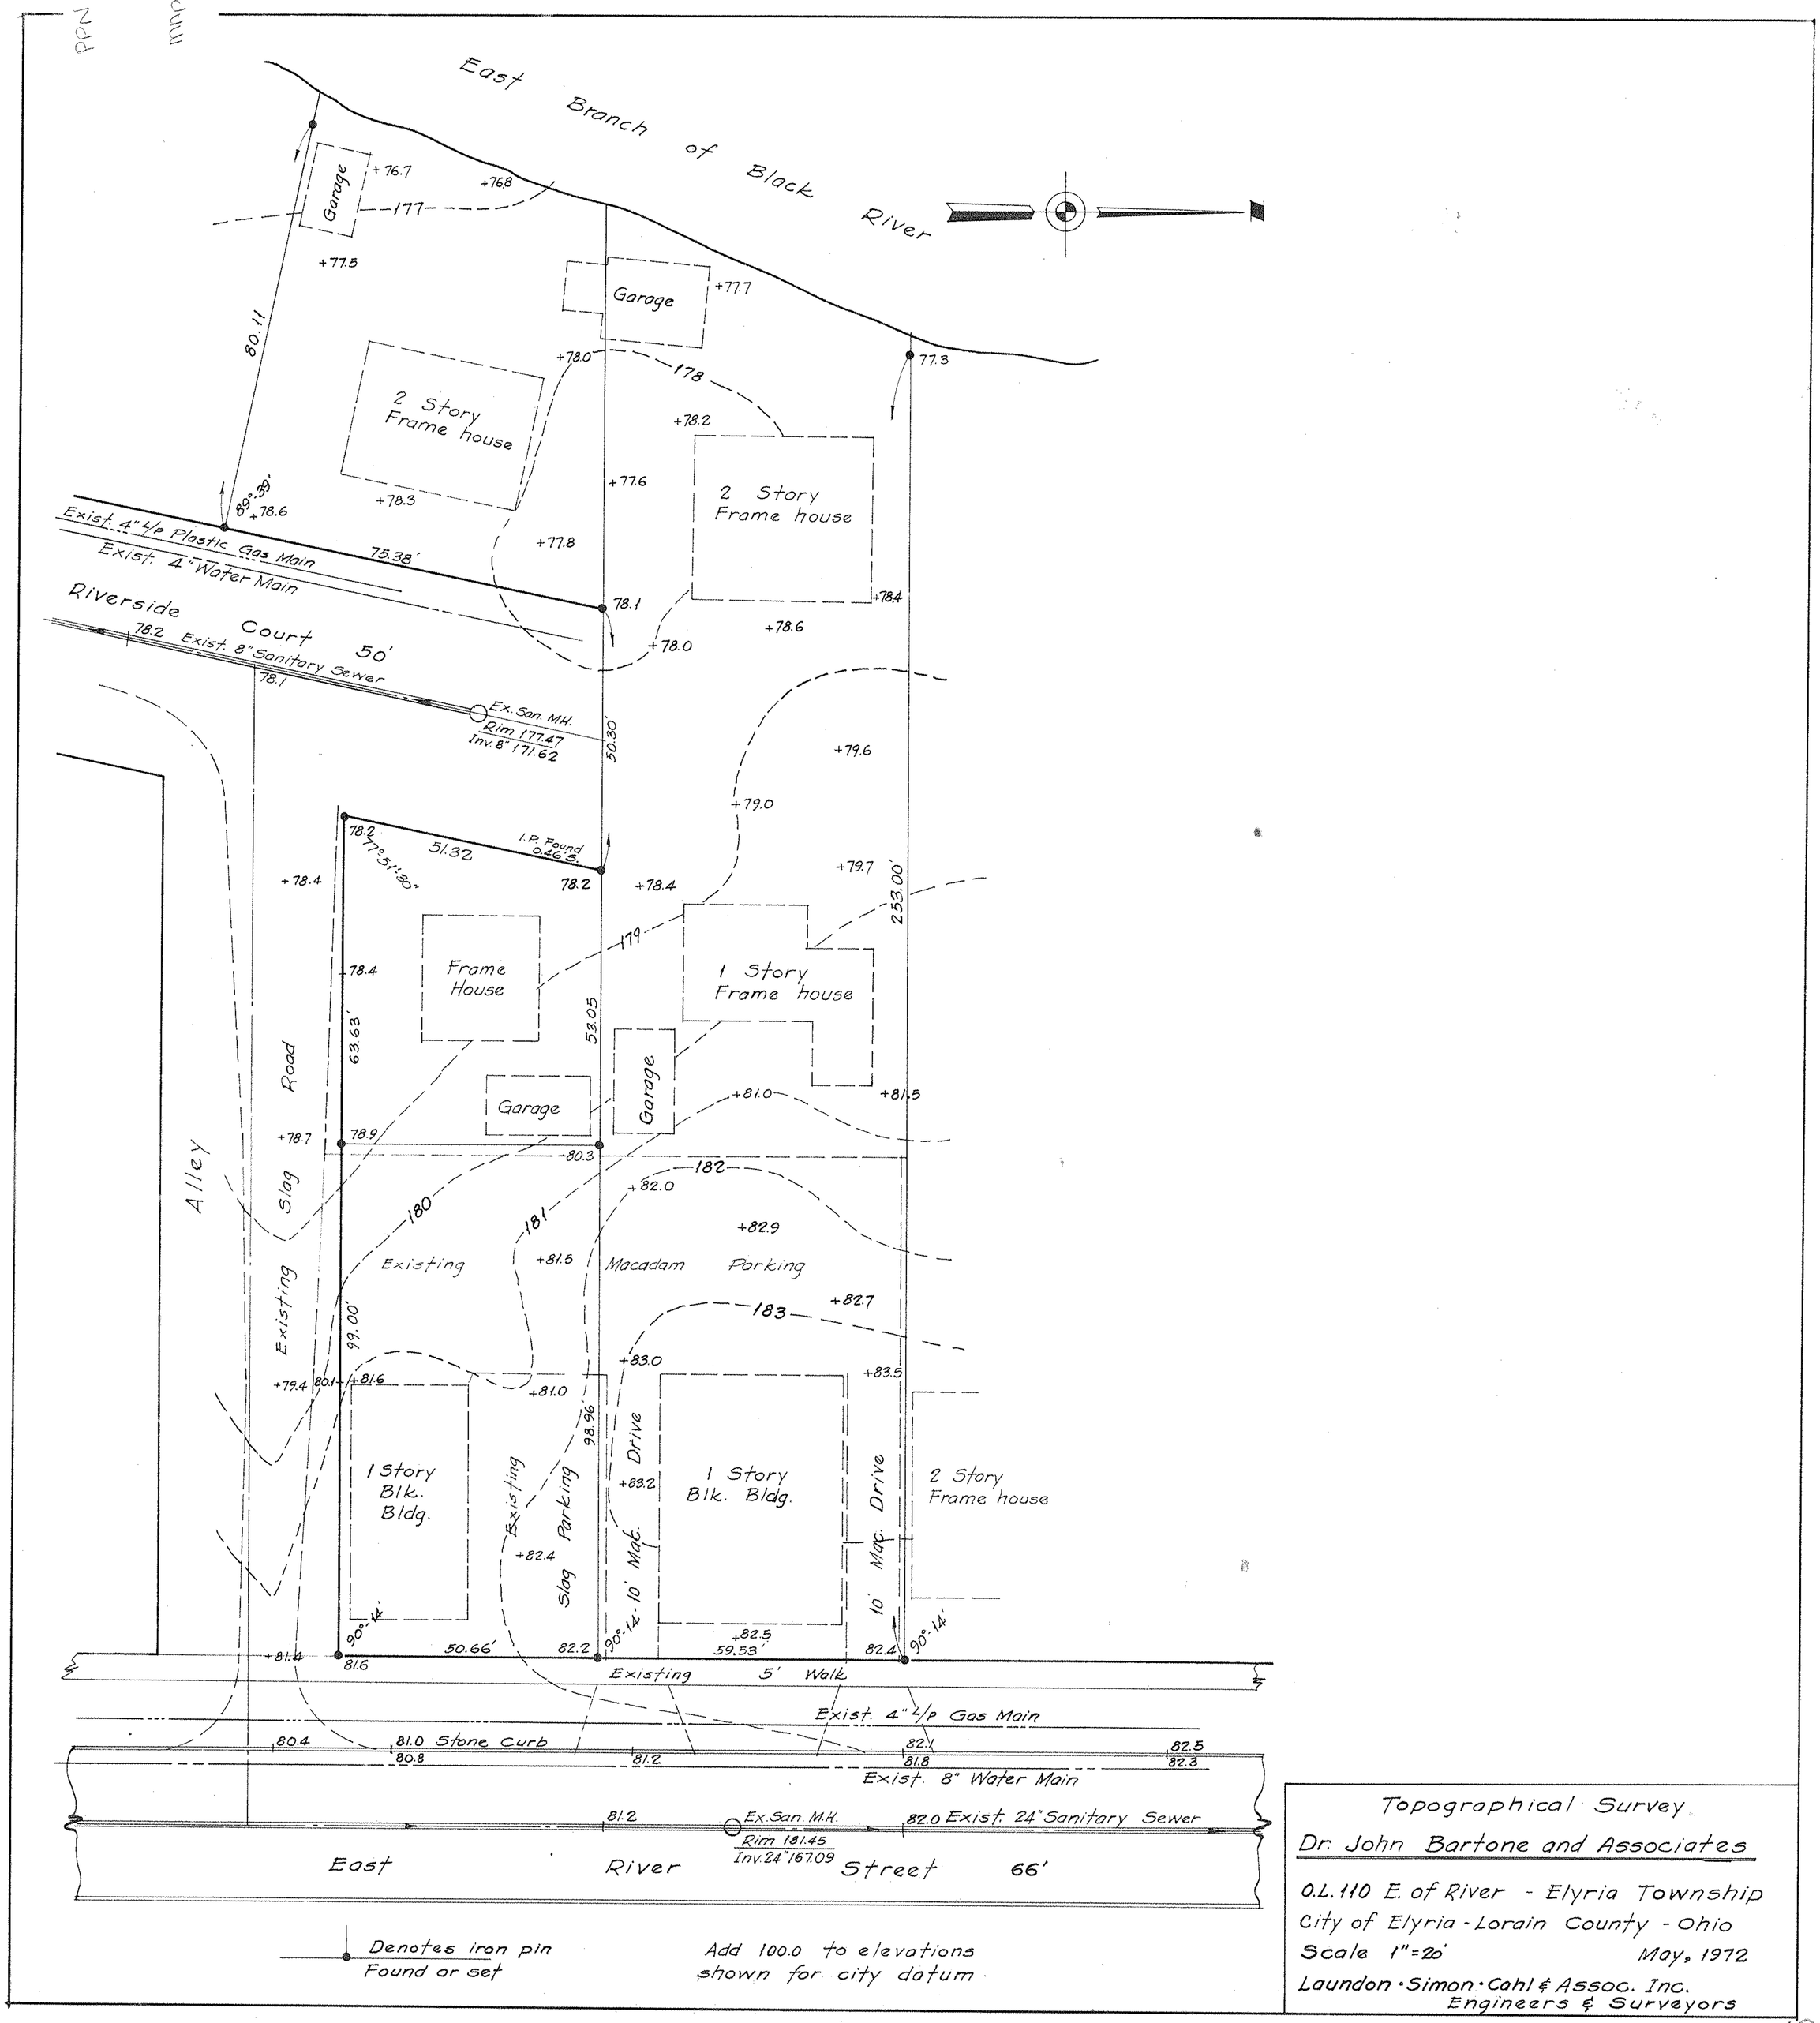

Topographical Survey

Dr. John Bartone and Associates

O.L. 110 E. of River - Elyria Township

City of Elyria - Lorain County - Ohio

Scale 1" = 20' May, 1972

Laundon · Simon · Cahl & Assoc. Inc.
Engineers & Surveyors