06-25-077-102
06-25-078-102
6-121

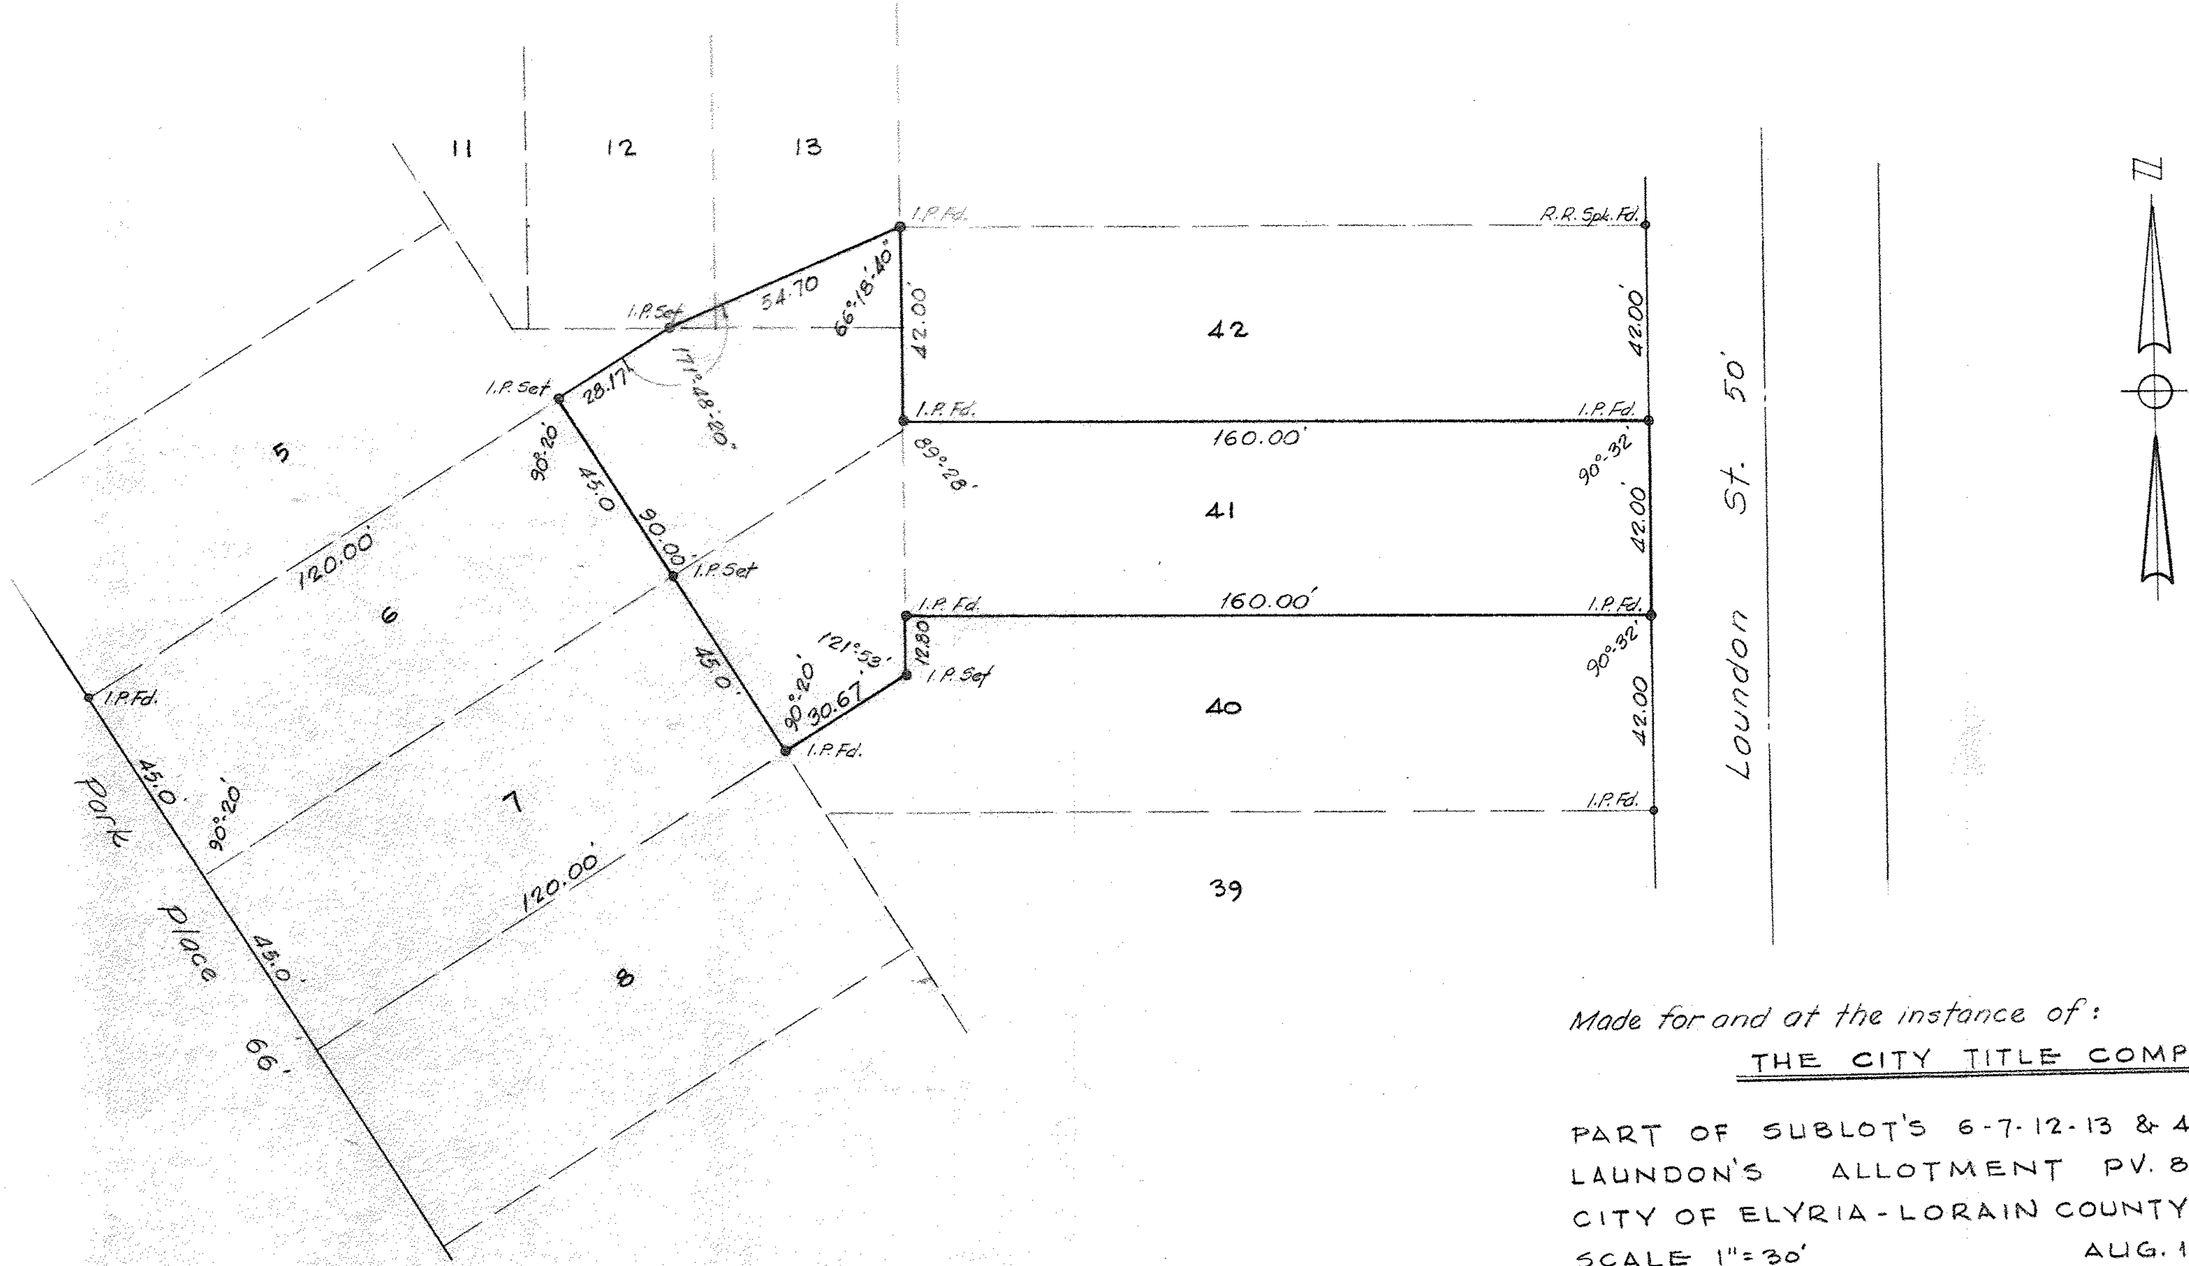

Made for and at the instance of:

THE CITY TITLE COMPANY

PART OF SUBLOT'S 6-7-12-13 & 41 OF
LAUNDON'S ALLOTMENT PV. 8 PG. 1
CITY OF ELYRIA - LORAIN COUNTY - OHIO
SCALE 1" = 30' AUG. 13, 1973
LAUNDON · SIMON · CAHL & ASSOC.
ENGINEERS - SURVEYORS

FB 187-1 Job No. 73-146