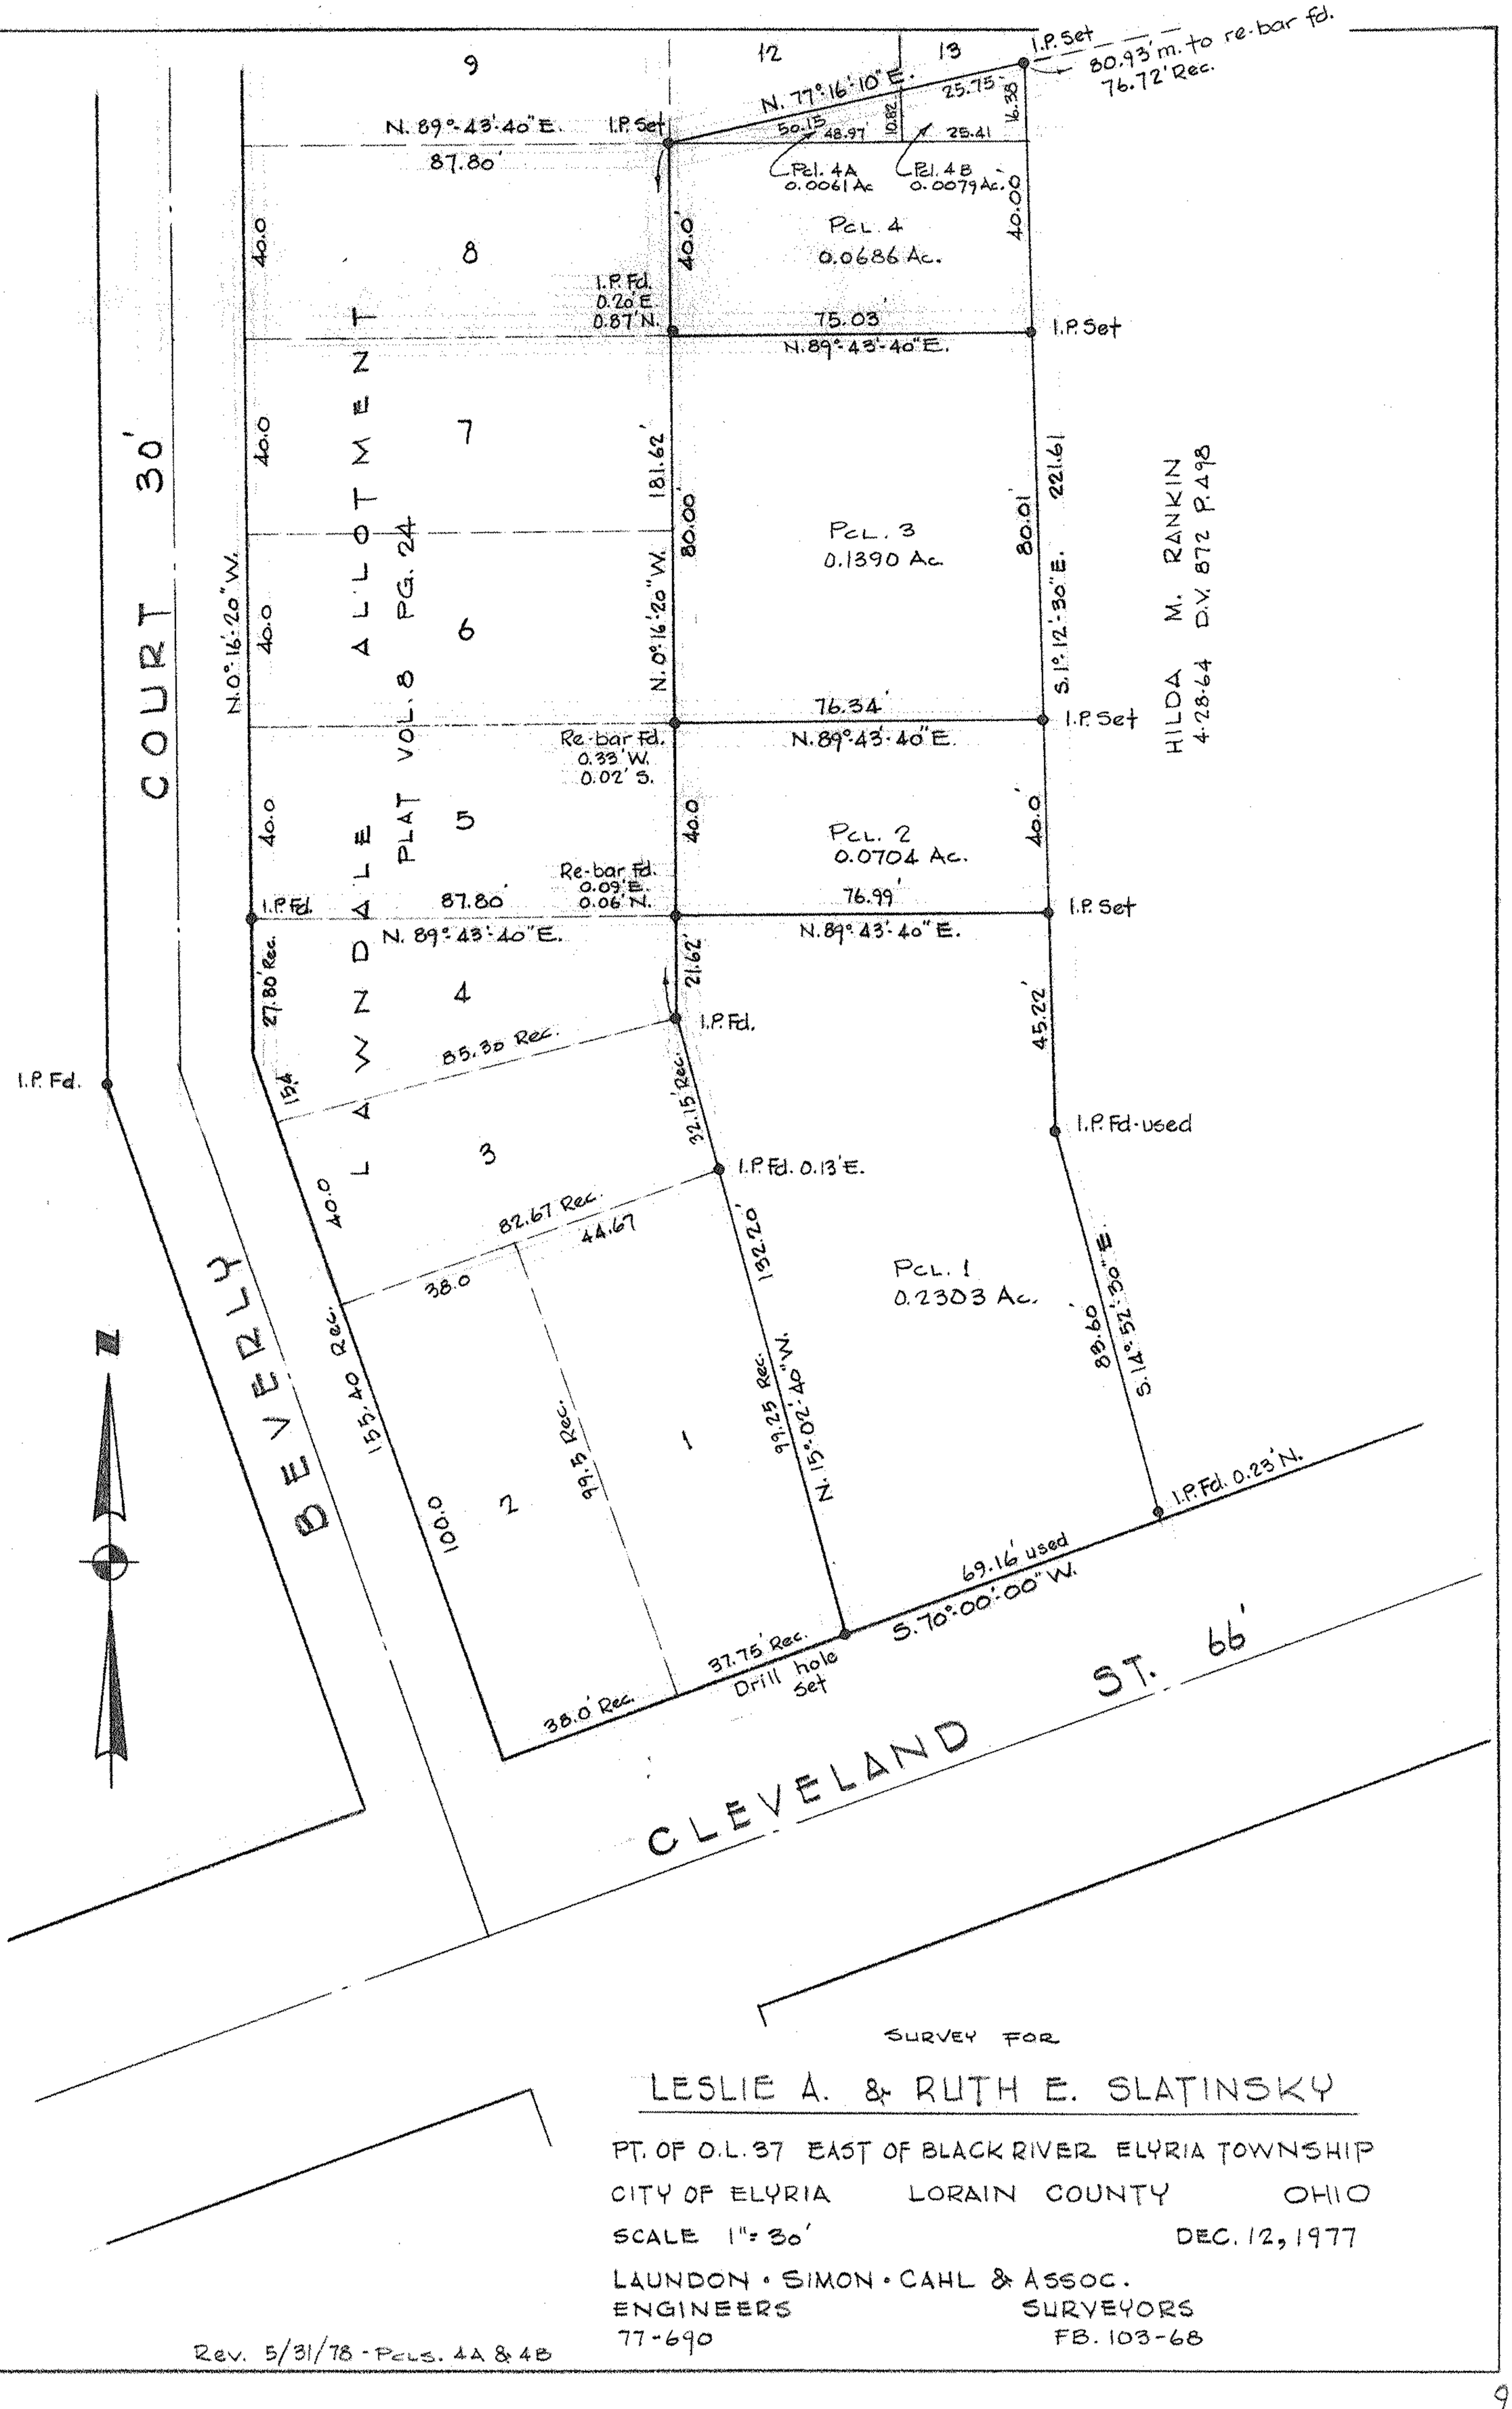

Rev. 5/31/78 - Pcls. 4A & 4B

SURVEY FOR

LESLIE A. & RUTH E. SLATINSKY

PT. OF O.L. 37 EAST OF BLACK RIVER ELYRIA TOWNSHIP

CITY OF ELYRIA LORAIN COUNTY OHIO

SCALE 1" = 30' DEC. 12, 1977

LAUNDON • SIMON • CAHL & ASSOC.

ENGINEERS SURVEYORS

77-690 FB. 103-68