TOTAL AREA	= 6.5590
TAKING AREA	= 4.6133
REMAINING AREA	= ~~1.9357~~ 1.9457

6-11
06-22-010-000-0

PPN 06-22-010.000

MAP PG 6-11

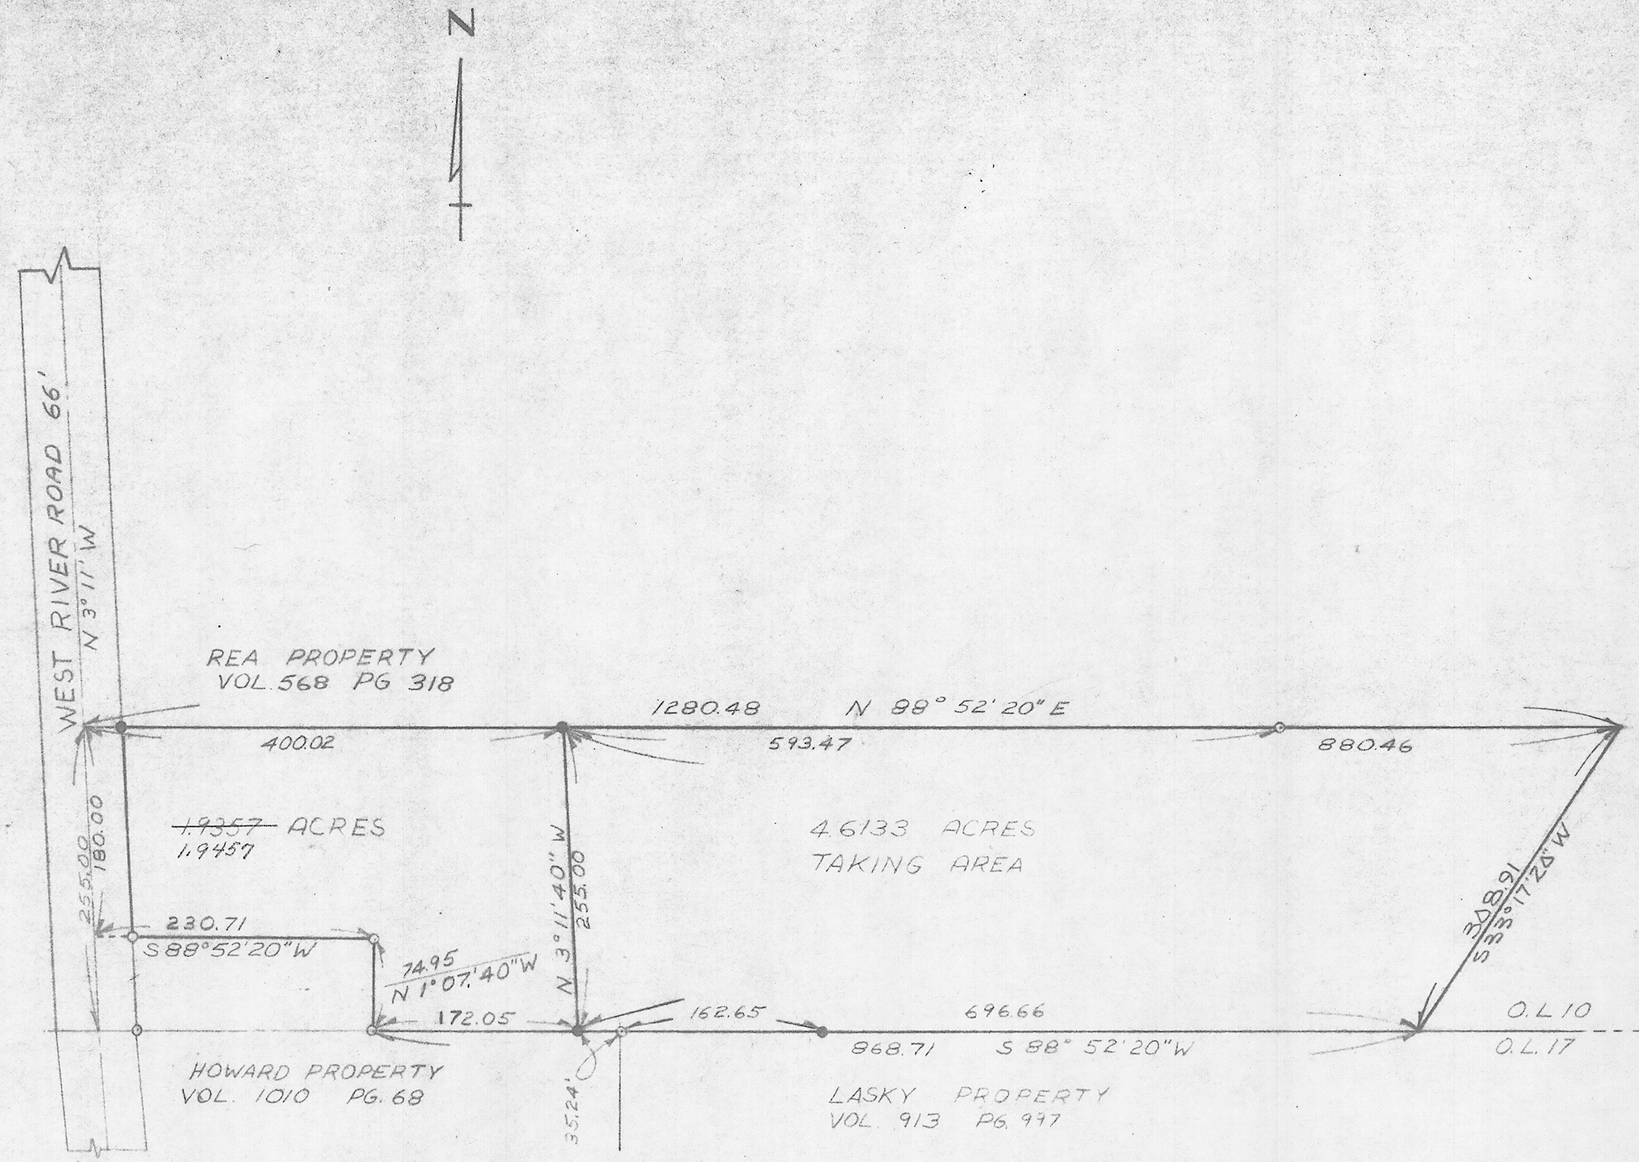

LEGEND
○ — IRON PIN FOUND
● — IRON PIN SET

RECEIVED
JAN 5 1973
LORAIN COUNTY
METROPOLITAN
PARK DISTRICT

NBR 48

STATE OF OHIO
JOHN L. MENO
3662
REGISTERED
SURVEYOR

REVISED 12-20-72

SURVEY
SAMUEL J. FRABOTTA
2629 WEST RIVER RD. N
ELYRIA, OHIO 44035

SCHAFER, HURA & ASSOCIATES, INC.
ENGINEERS AND SURVEYORS
4370 OBERLIN AVE.
LORAIN, OHIO

ORIGINAL LOT	10	DATE	9-1-72
TOWNSHIP	ELYRIA	SCALE	1" = 100'
CITY OF	ELYRIA	FIELD BOOK	219 PG. 11
COUNTY OF	LORAIN	DRAWN BY	N.G.
STATE OF	OHIO	CHECKED BY	J.L.M.
W. O.	1685-24	FILE NO.	6-10 BURREL DAY