


MAP PG 6-4

44194

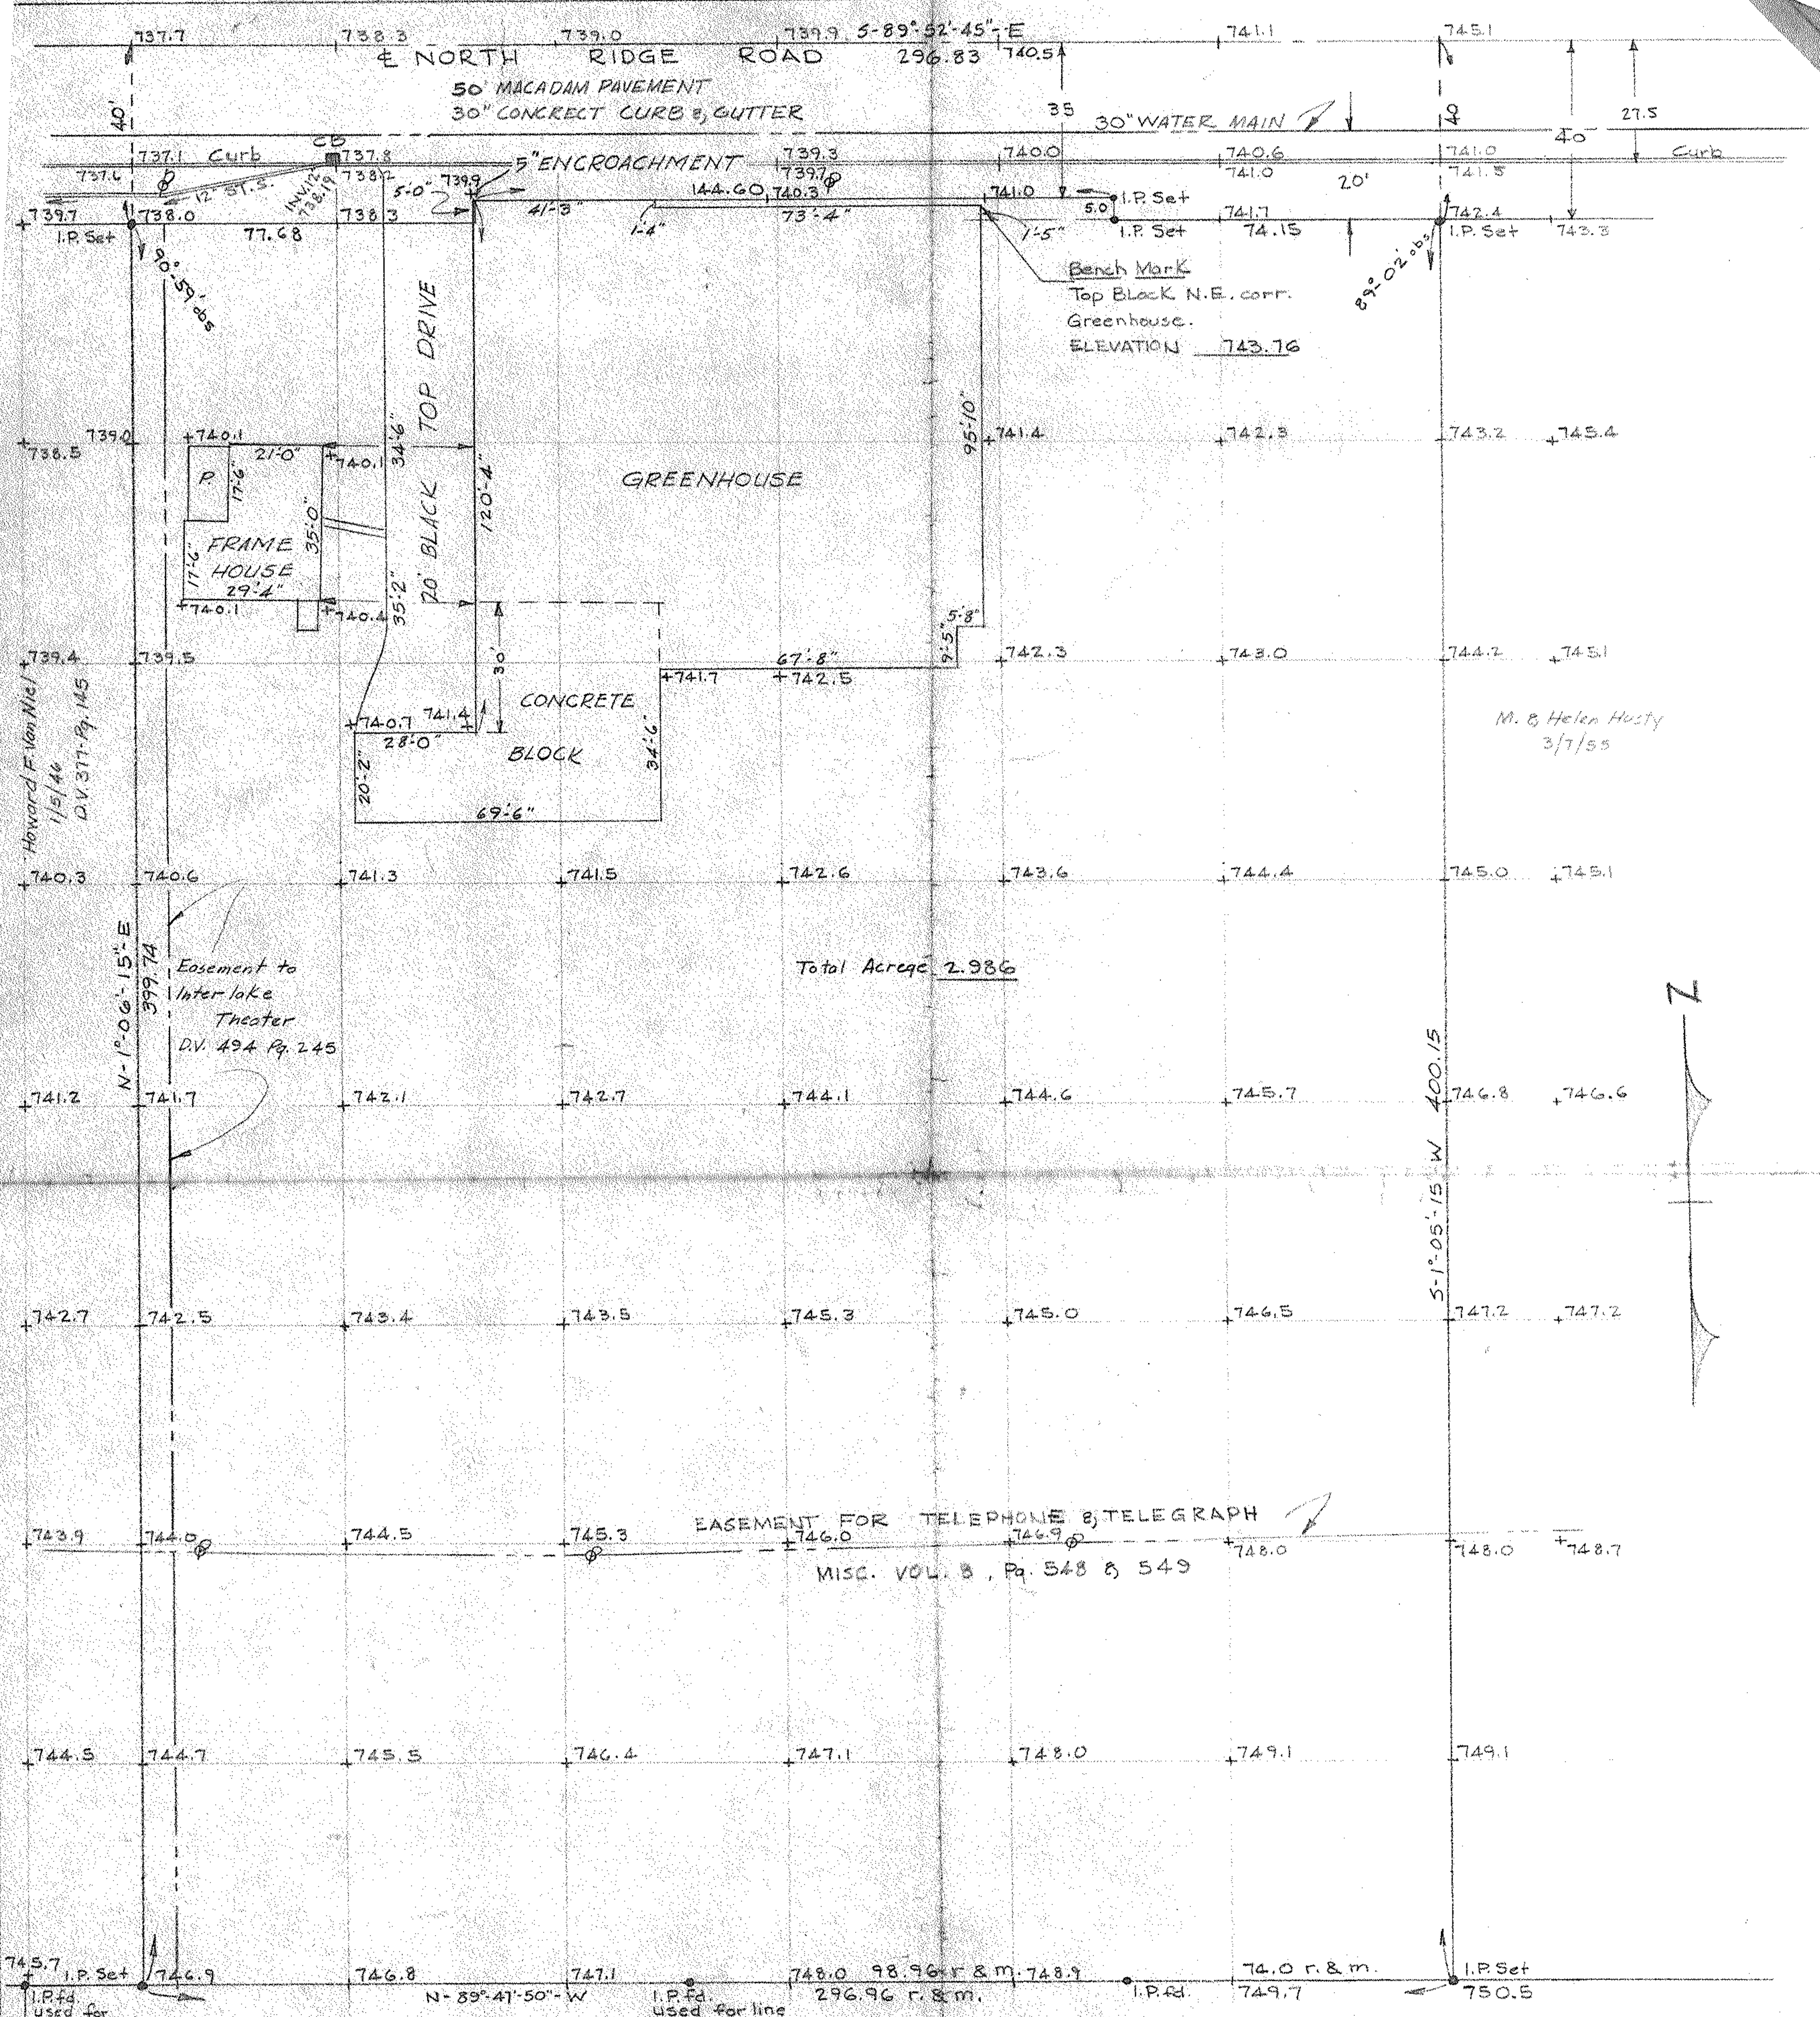

Interlake Theaters Corp.  
 11/25/43 D.V. 405, Pg. 142

**SITE & TOPO SURVEY**  
 JAMES & OLGA SOVA  
 PT. OF O.L. 4 NEWBERRY TR.  
 ELYRIA TWP. LORAIN CO., O.  
 SCALE 1"=30' JUNE, 1960  
 LAUNDON & HUFFMAN  
 ENGINEERS