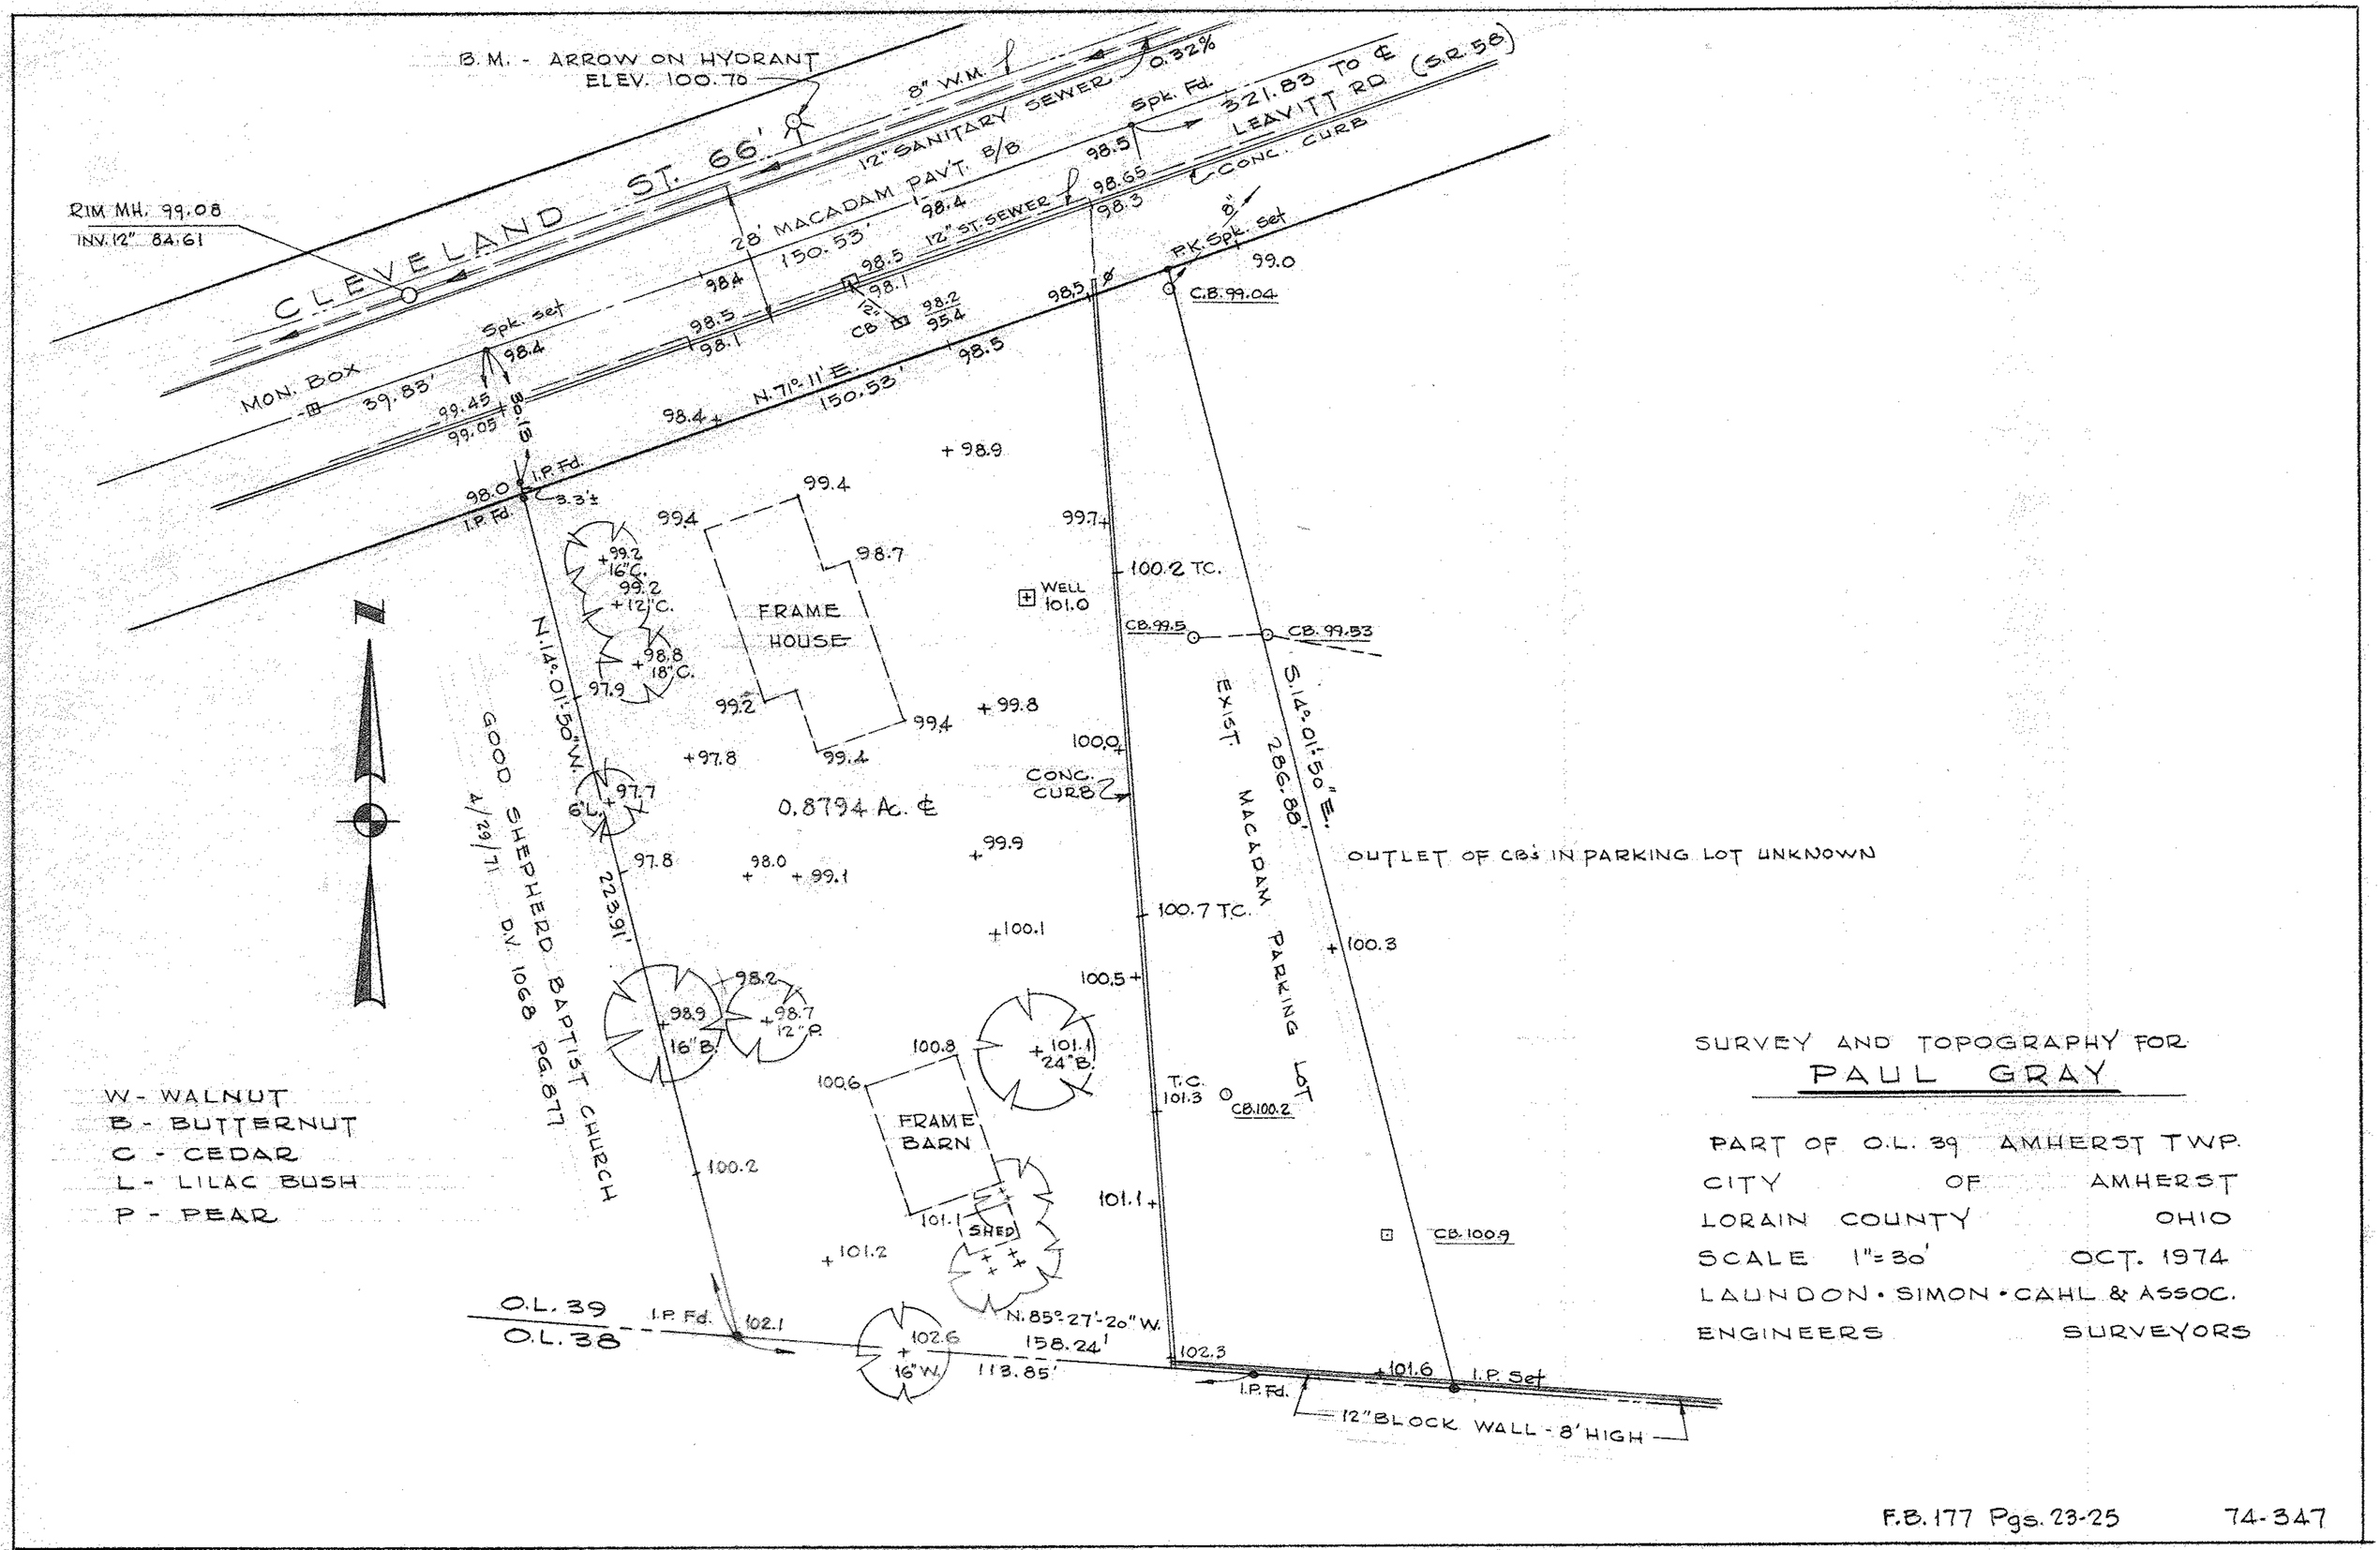

SURVEY AND TOPOGRAPHY FOR
PAUL GRAY

PART OF O.L. 39 AMHERST TWP.
CITY OF AMHERST
LORAIN COUNTY OHIO
SCALE 1"=30' OCT. 1974
LAUNDON • SIMON • CAHL & ASSOC.
ENGINEERS SURVEYORS

F.B. 177 Pgs. 23-25 74-347