


TENNEY AVE 50'

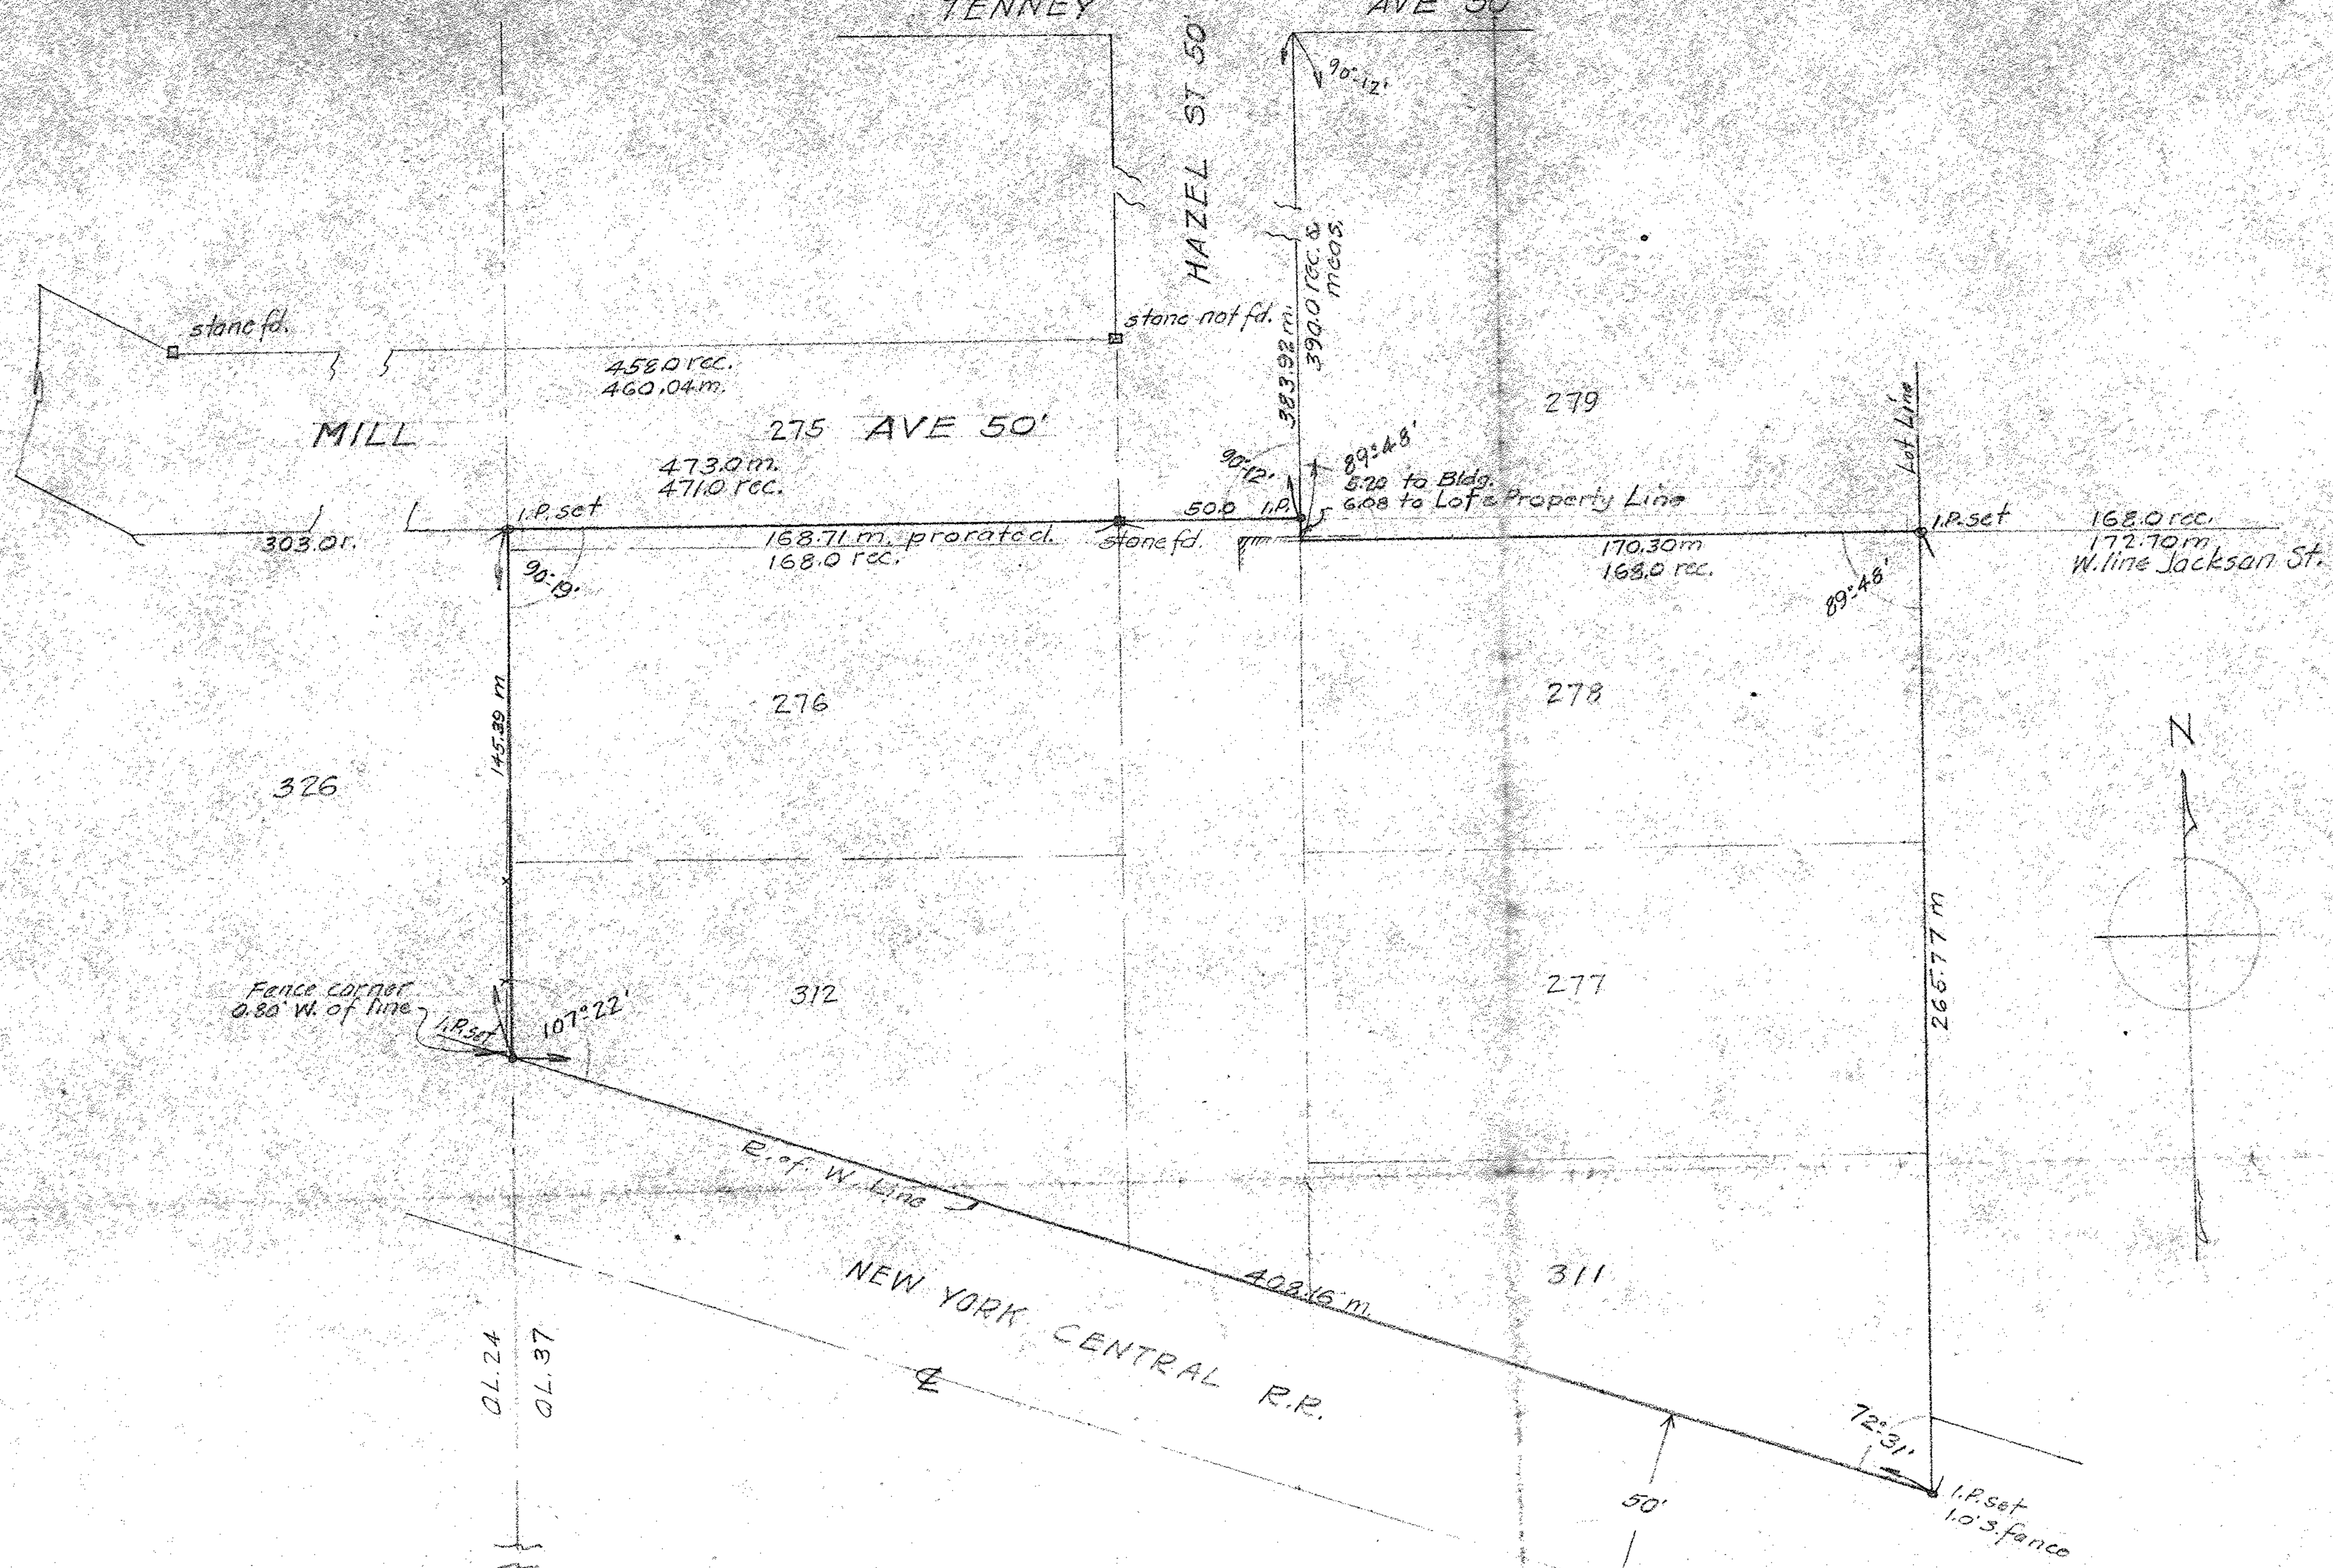

SURVEY FOR  
 THE AMHERST LUMBER CO.  
 LOTS 275-276-277-278-311-312 J. JACKSON'S  
 ADD'N AMHERST VILLAGE LORAIN CO. OHIO.  
 SEPT 14, 1949 SCALE 1" = 40'  
 T.W. LAUNDON REGISTERED SURVEYOR