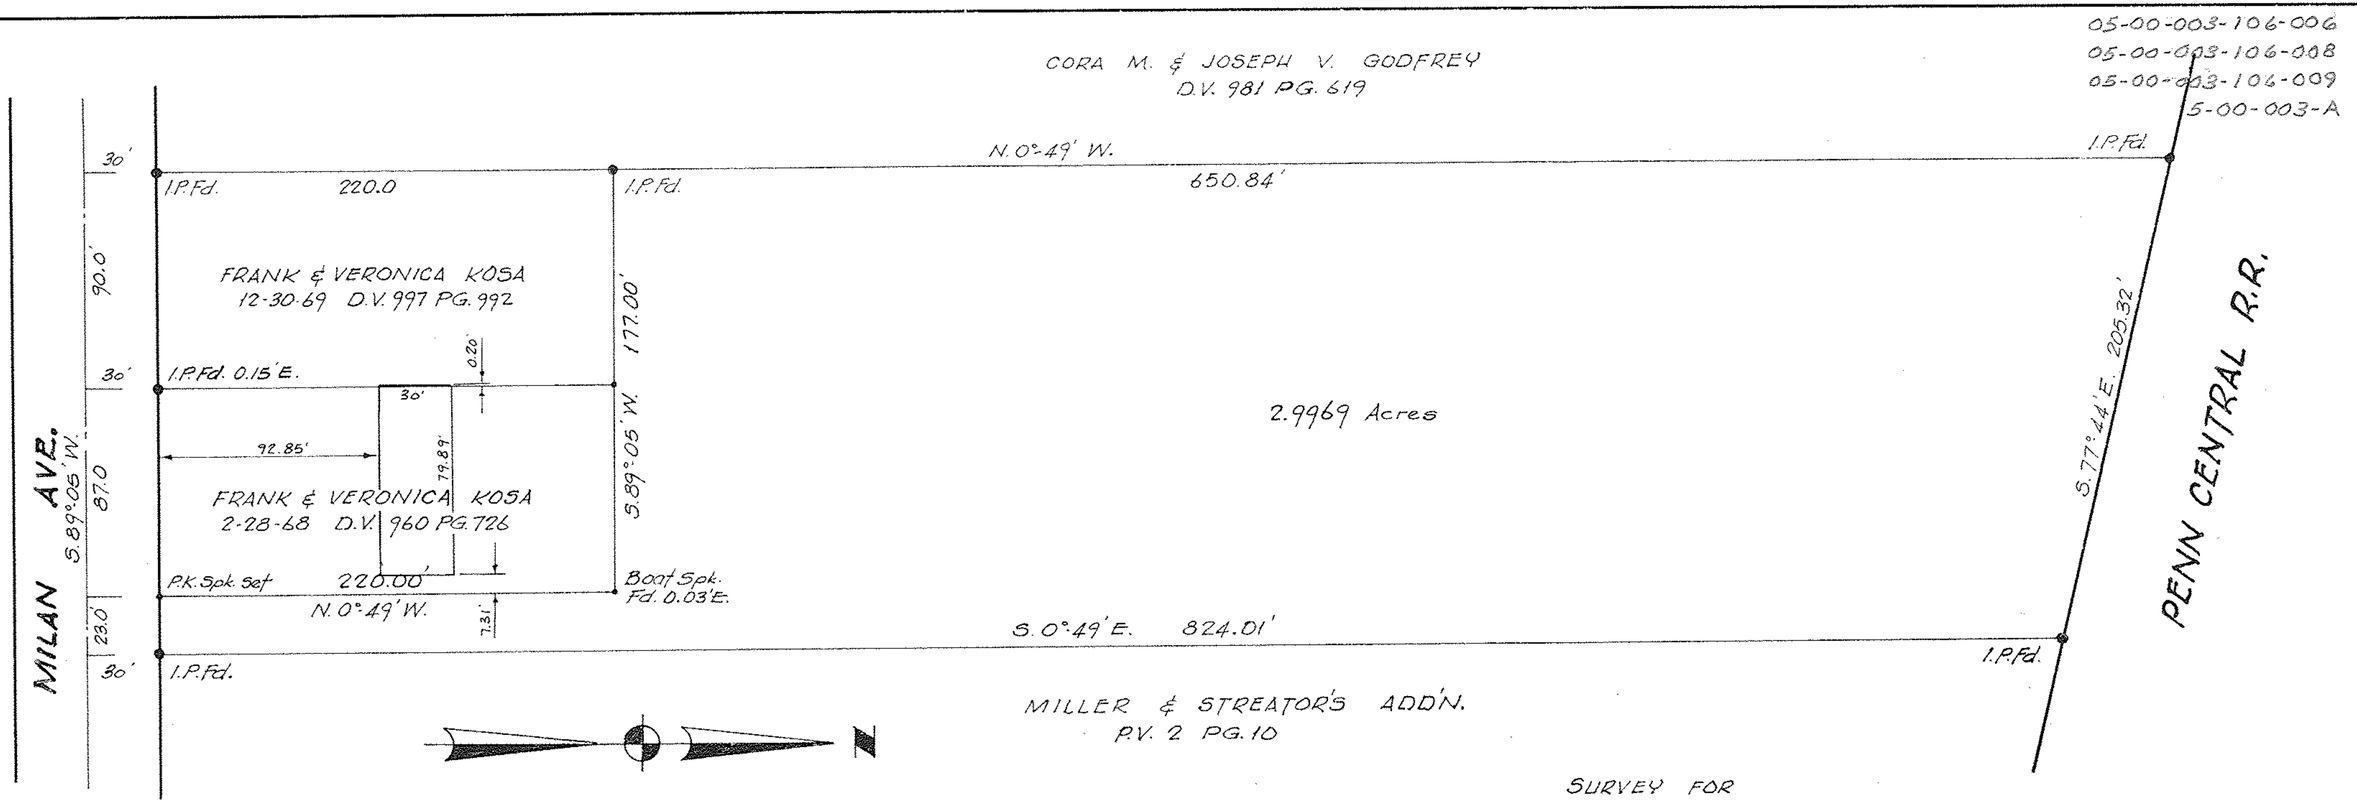

SURVEY FOR

ROBERT C. GORMAN - TRUSTEE

O.L. 3 AMHERST TWP., CITY OF AMHERST, LORAIN CO., OHIO

SCALE 1"=60'

MARCH 28, 1977

LAUNDON • SIMON • CAHL & ASSOC. ENGINEERS & SURVEYORS

JOB NO. 77-595

F.B. 180 PG. 54