


Lot Split Survey made for **JOE QUINN**  
 Part of Columbia Township Lot 20  
 Lorain County, Ohio

January 1996 95234 FB 21\36

References:

KS Assoc. survey 3\2\87  
 JB Root survey Sept. 87  
 Warden survey 11\03\48

12-00-020-123-016-017-018  
 12-00-020-020-B #21725

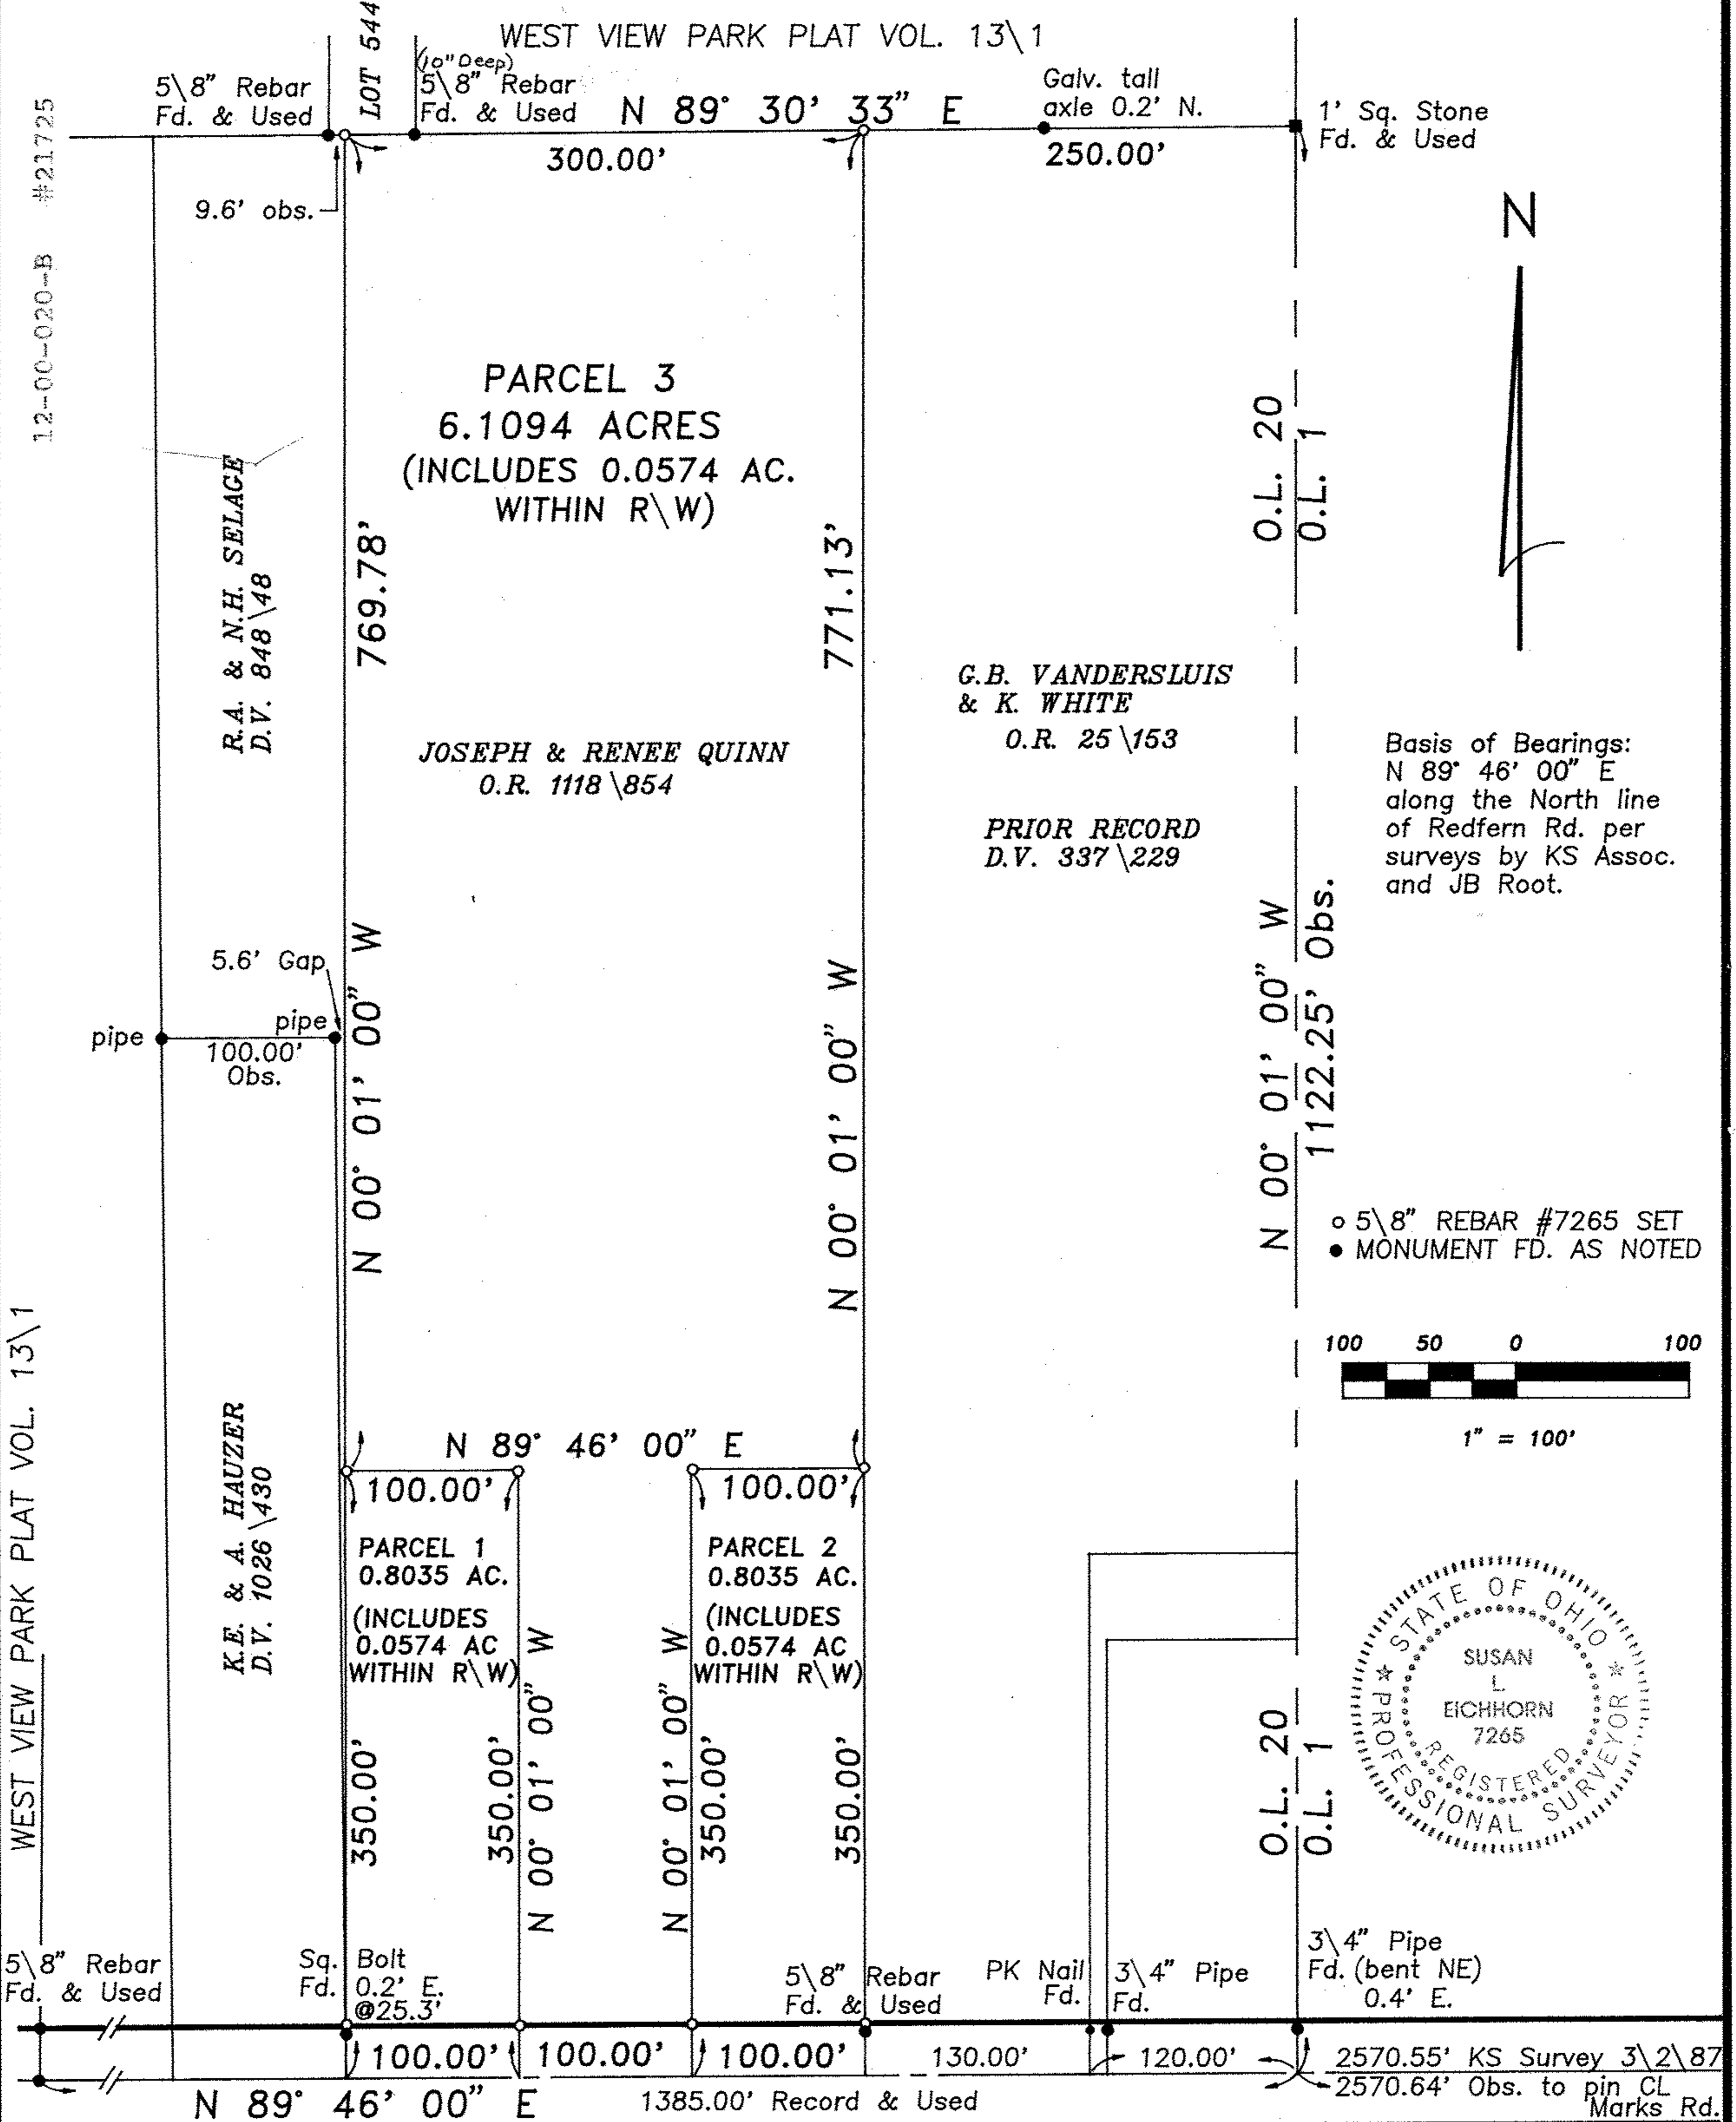

Iron Pin (Ref. Used)

**REDFERN ROAD 60'**

NOTE: ALL R\W PINS WERE FD. AT 25' FROM CL.

*Susan L. Eichhorn*  
 Susan L. Eichhorn P.S. 7265