11-00-024-000
11-00-024-B

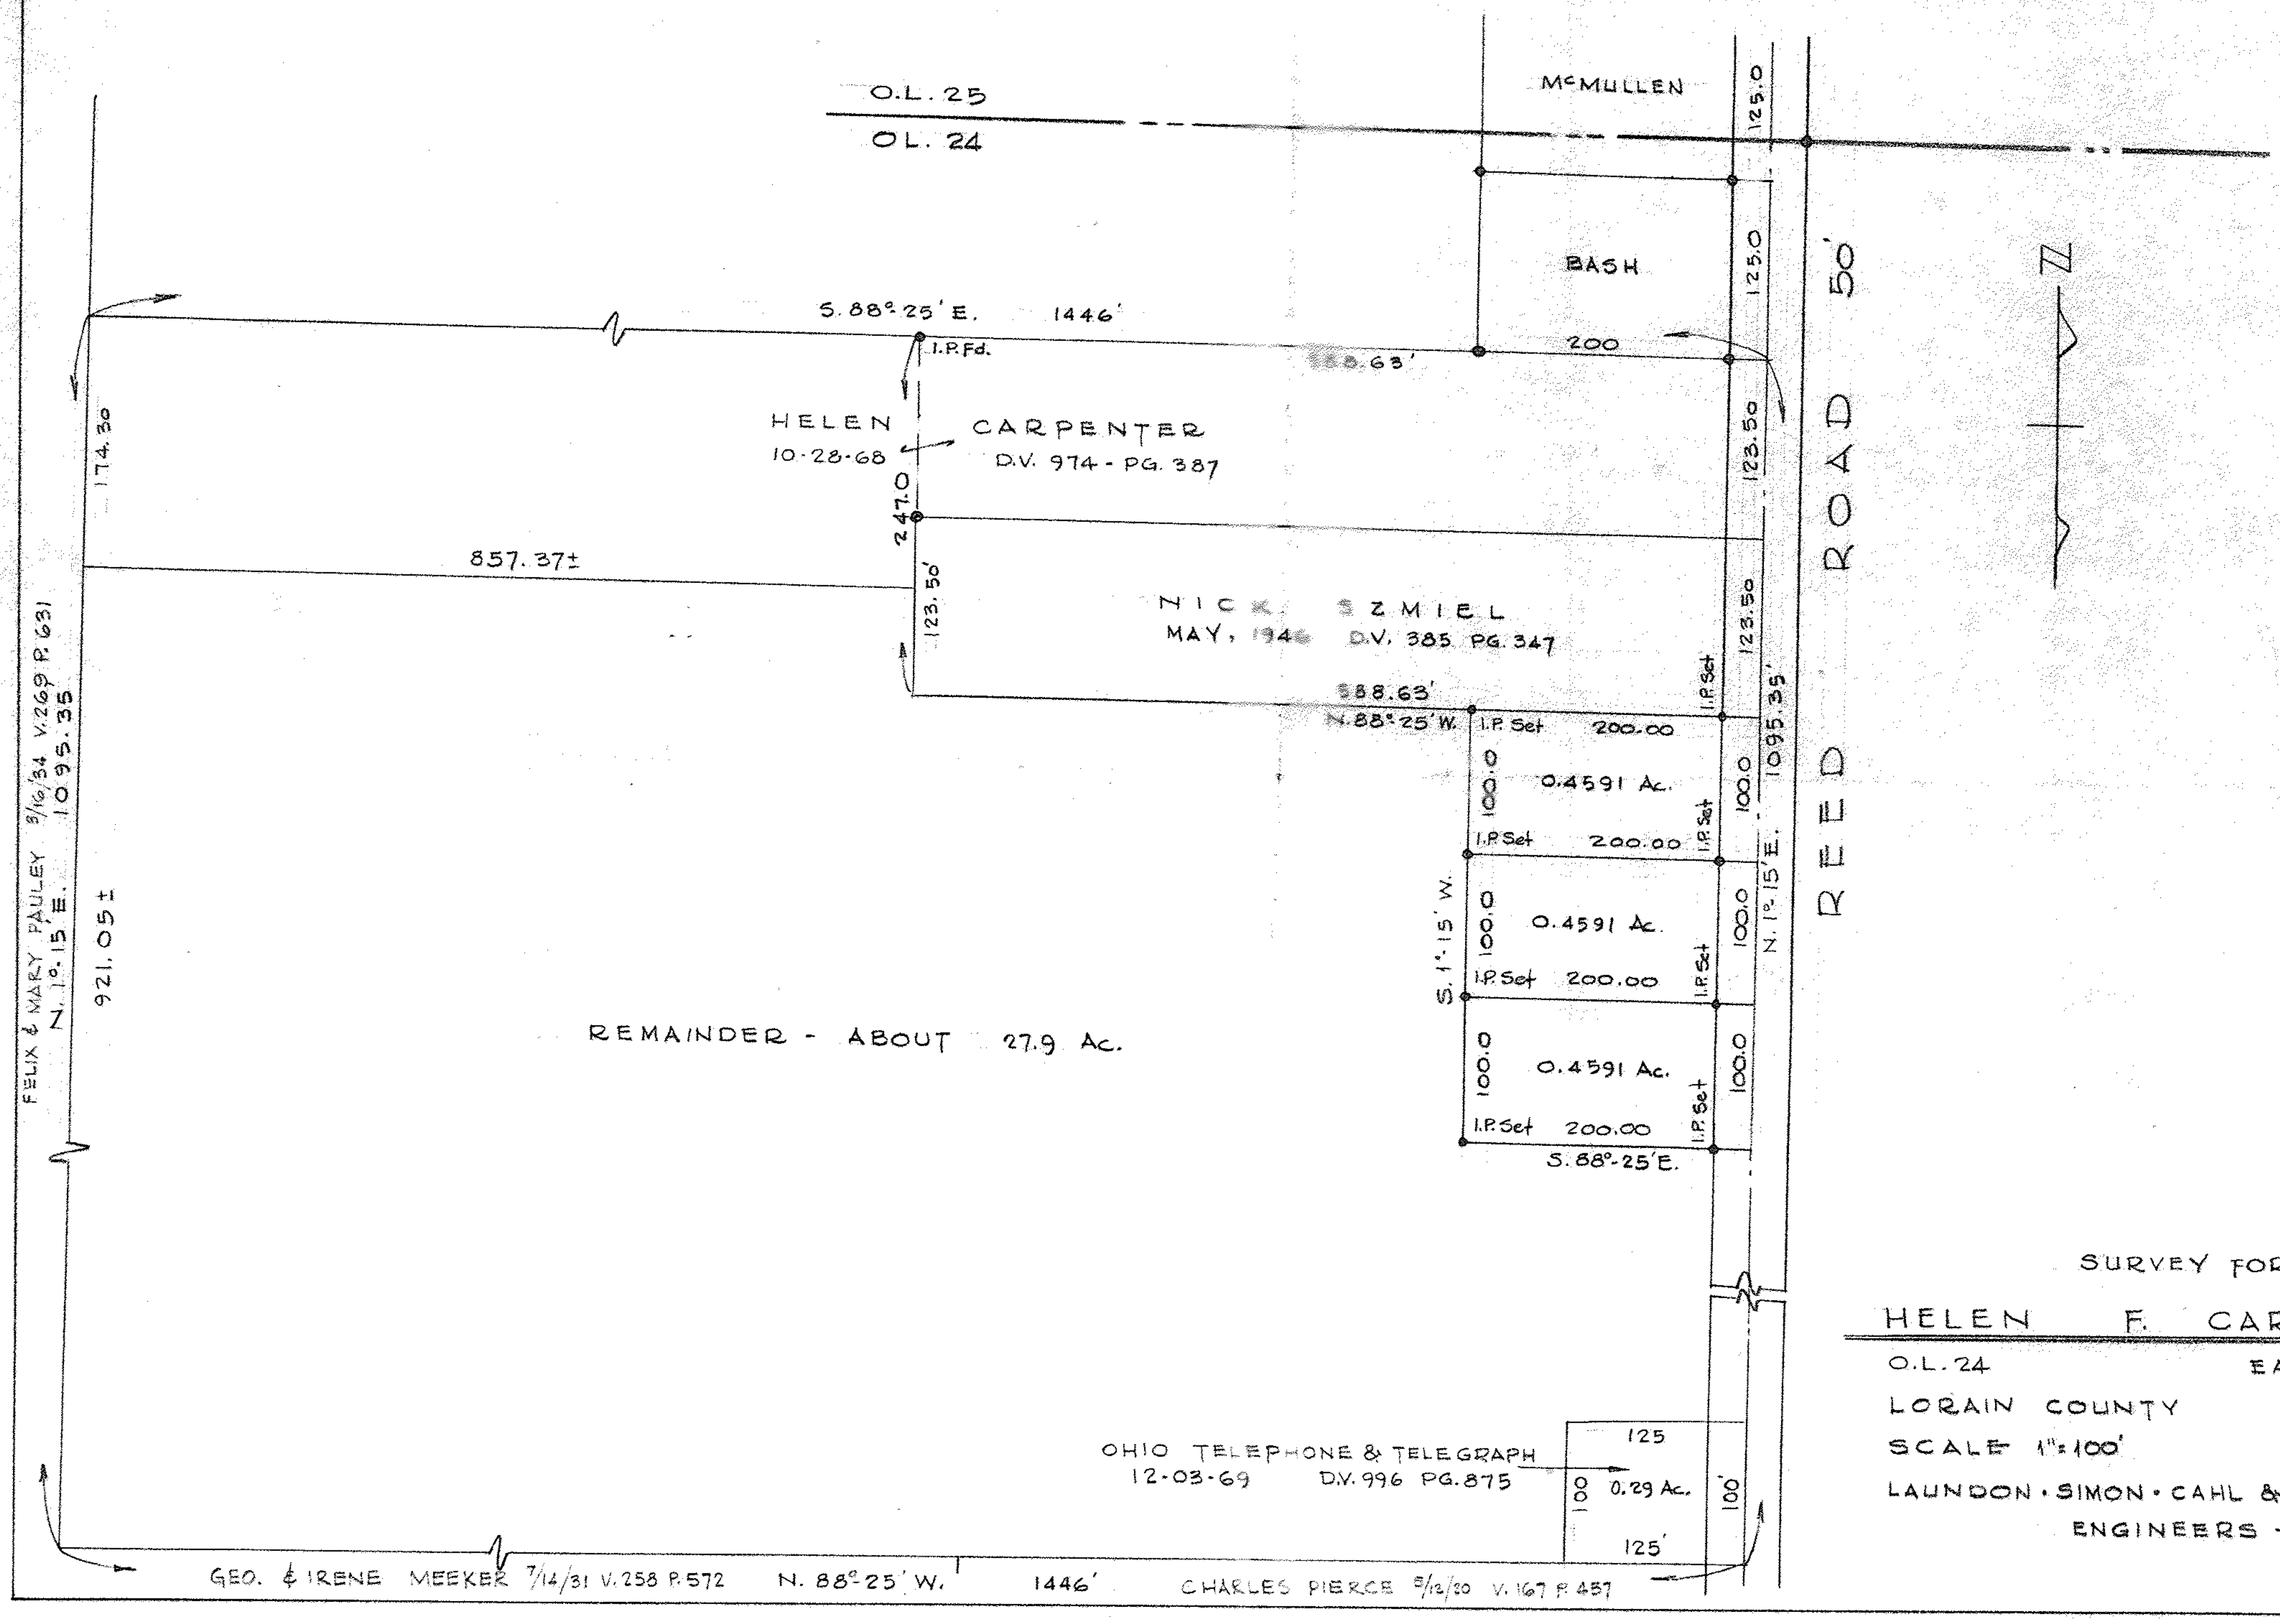

SURVEY FOR

HELEN F. CARPENTER

O.L. 24 EATON TWP.

LORAIN COUNTY OHIO

SCALE 1" = 100' MARCH, 1973

LAUNDON · SIMON · CAHL & ASSOC.

ENGINEERS - SURVEYORS

J.N. 73-89

FB - 181 - 7

18