
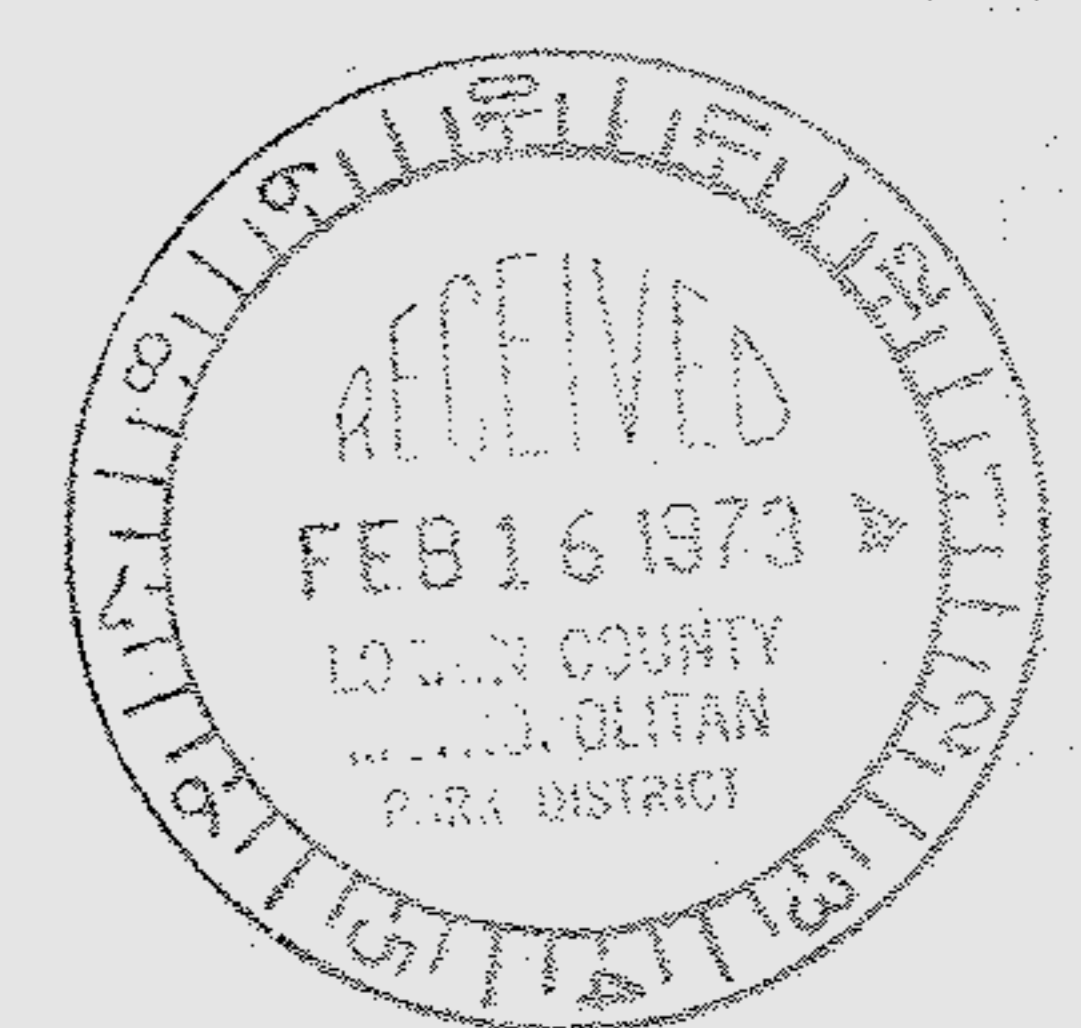
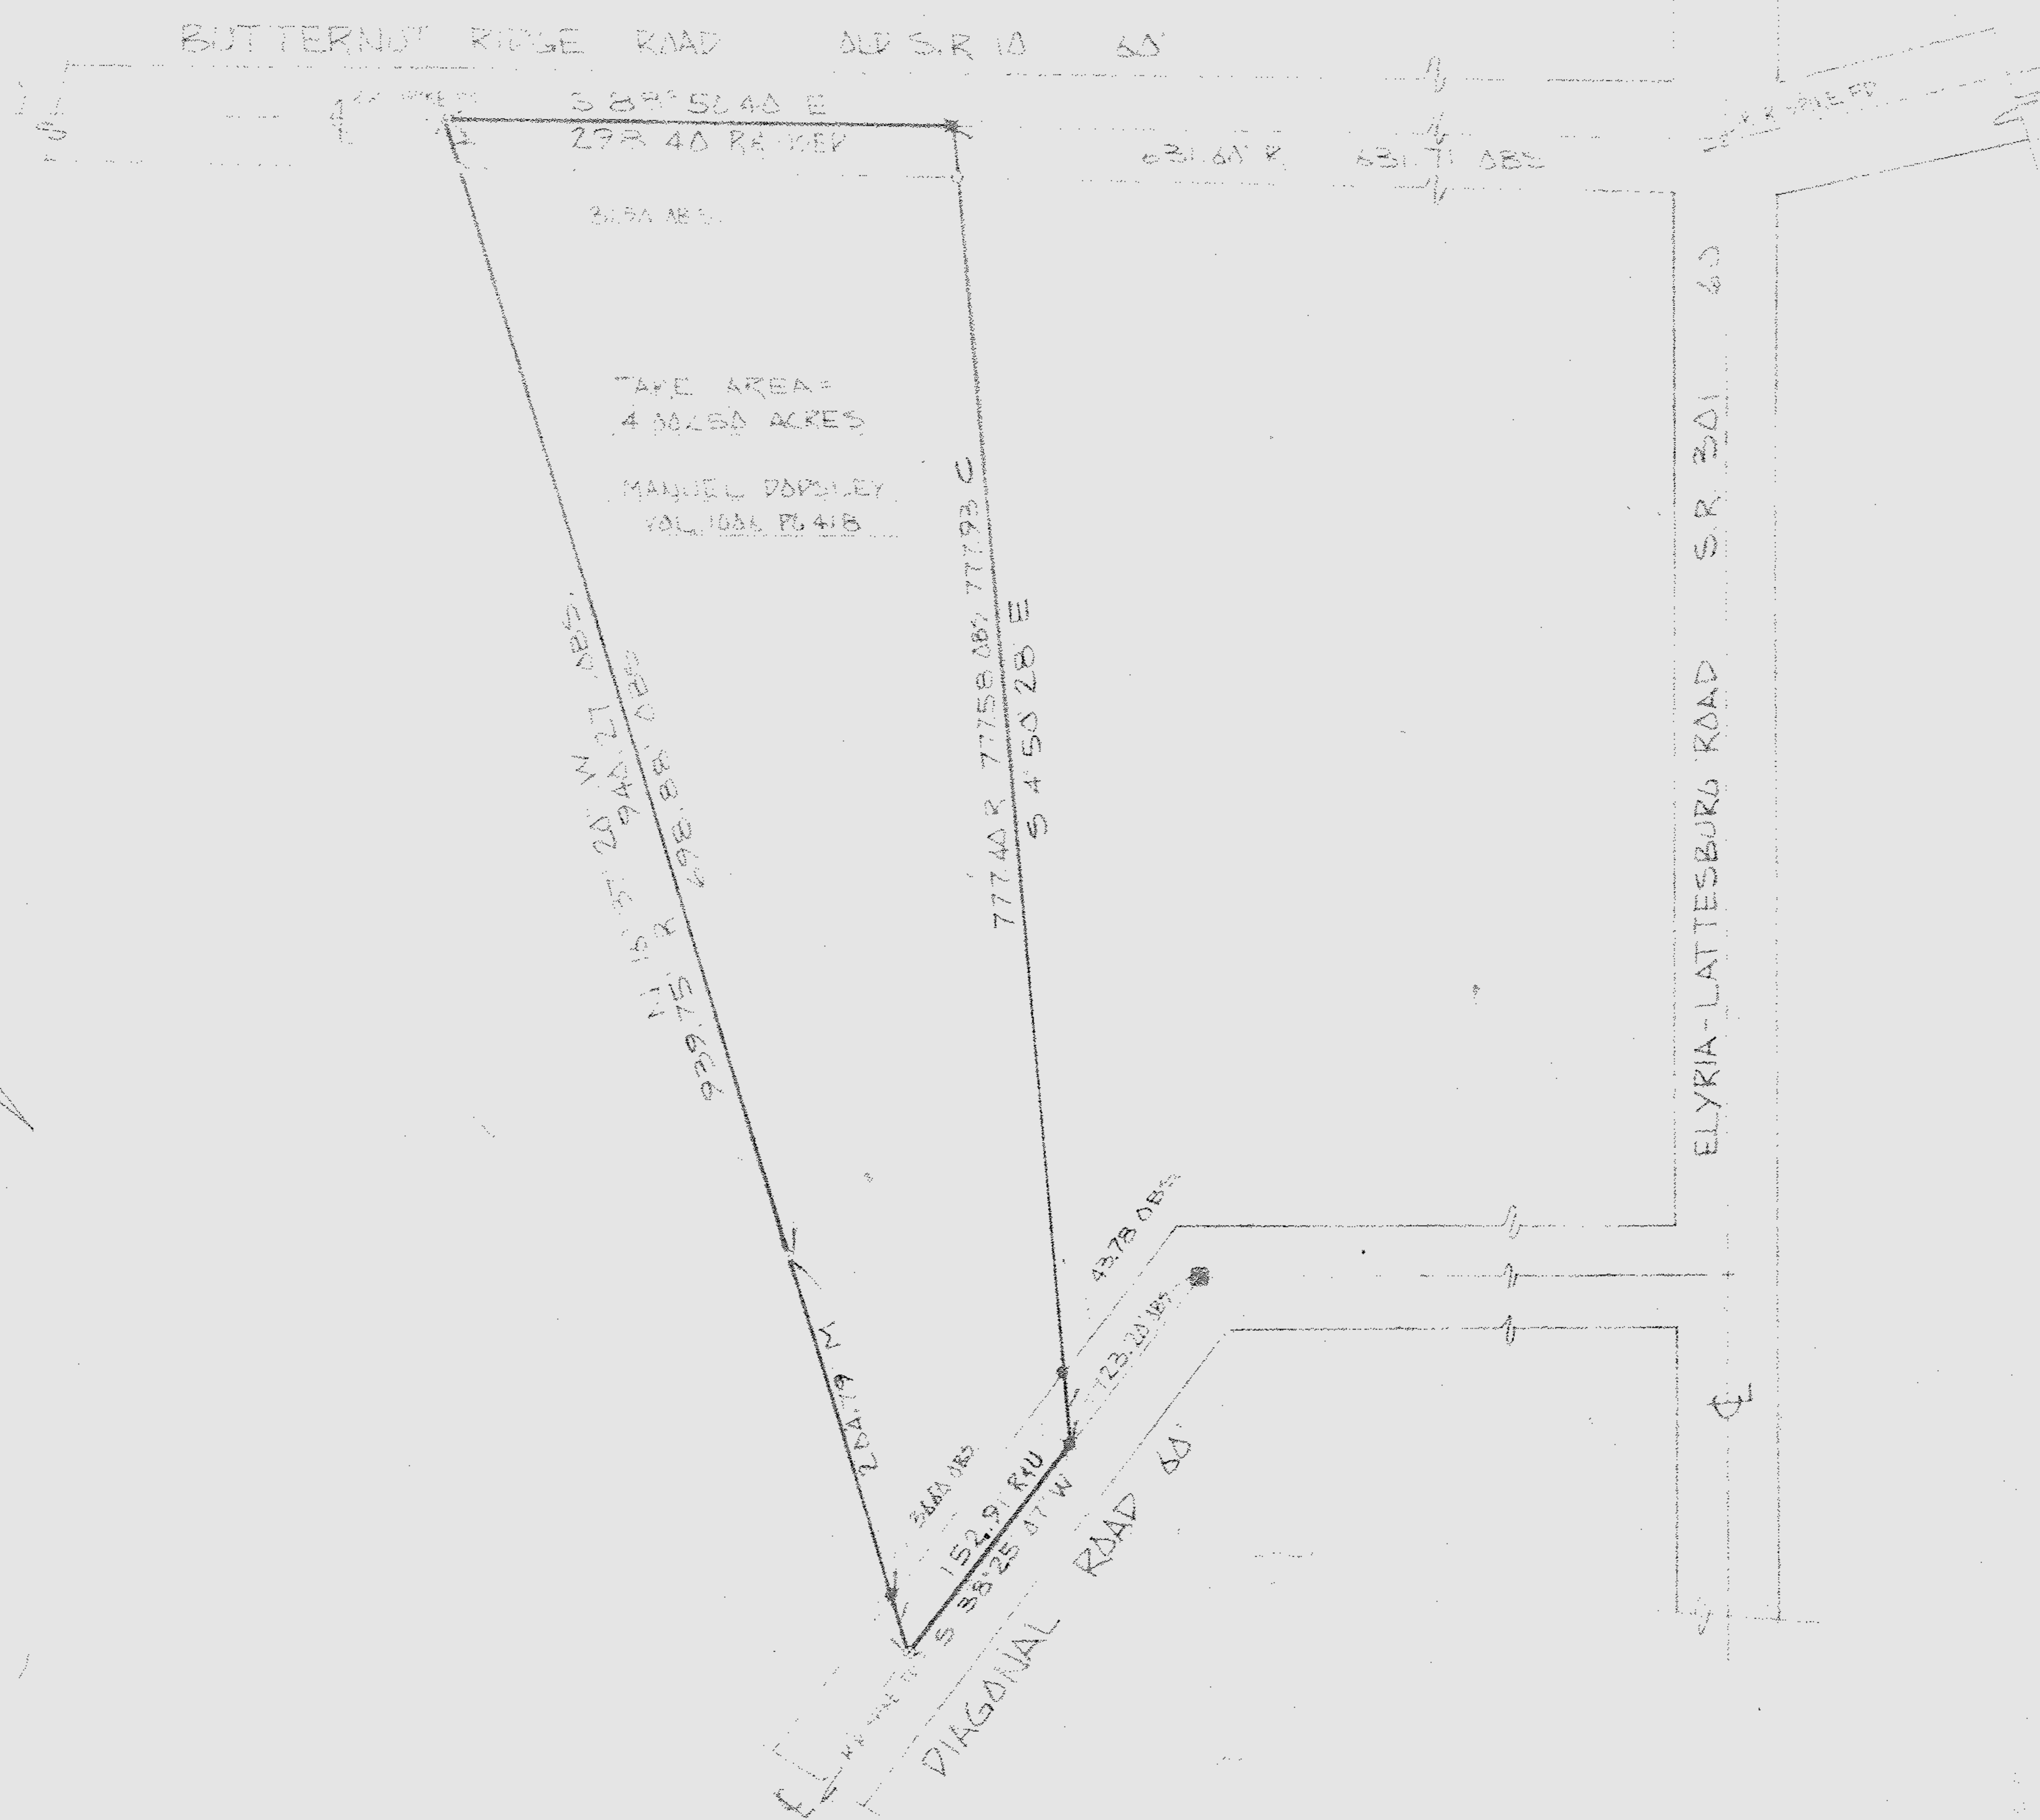



TOTAL AREA = 4.00250 AC  
 TAKE AREA = 4.00250 AC  
 REMAINDER = 0.0000 AC

PPN 10-00-013-000?

MAP PG 10-00-013-B

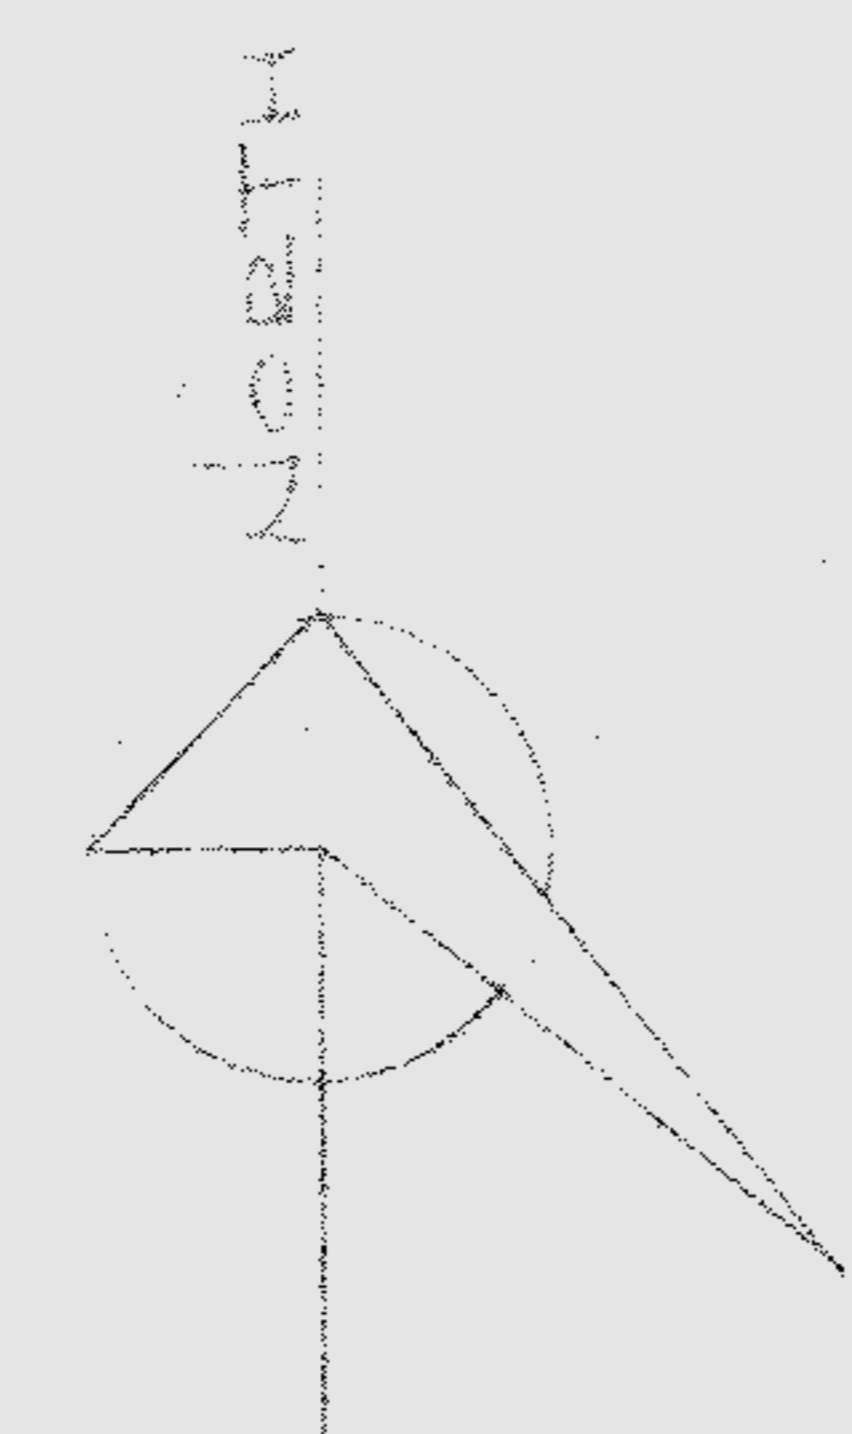

- LEGEND
- IRON PIN FOUND ---- O
  - IRON PIN SET ---- ●
  - MONUMENT ---- ■
  - NAIL SET ---- ✕
  - USED ---- U
  - OBSERVED ---- OBS
  - RECORDED ---- R
  - CALCULATED ---- C

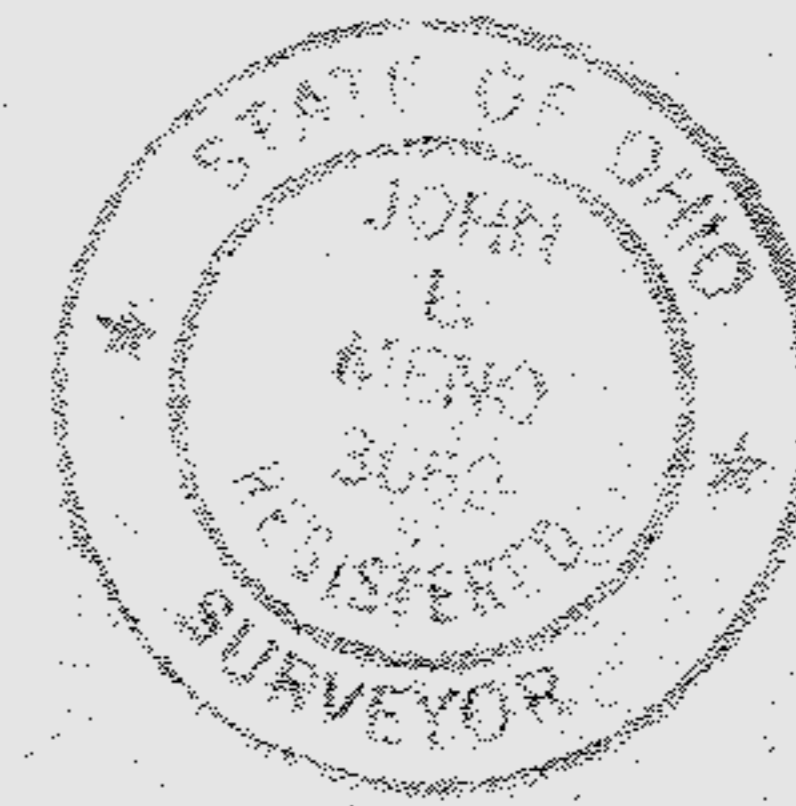

LORAIN COUNTY METROPOLITAN PARKS  
 LAND ACQUISITION SURVEY  
 MANUEL DODSLEY PROPERTY  
 CARLISLE TOWNSHIP

**SCHAFFER, HURA & ASSOCIATES, INC.**  
 ENGINEERS AND SURVEYORS  
 4370 OBERLIN AVE.  
 LORAIN, OHIO

CWB  
 85

ORIGINAL LOT 13 DATE 2-8-73  
 TOWNSHIP CARLISLE SCALE 1"=100'  
 CITY OF \_\_\_\_\_ FIELD BOOK 219 P. 123B  
 COUNTY OF LORAIN DRAWN BY JER  
 STATE OF OHIO CHECKED BY \_\_\_\_\_  
 W. O. 1685-52E FILE NO. 10-00-13

CHECKED 2/11/73