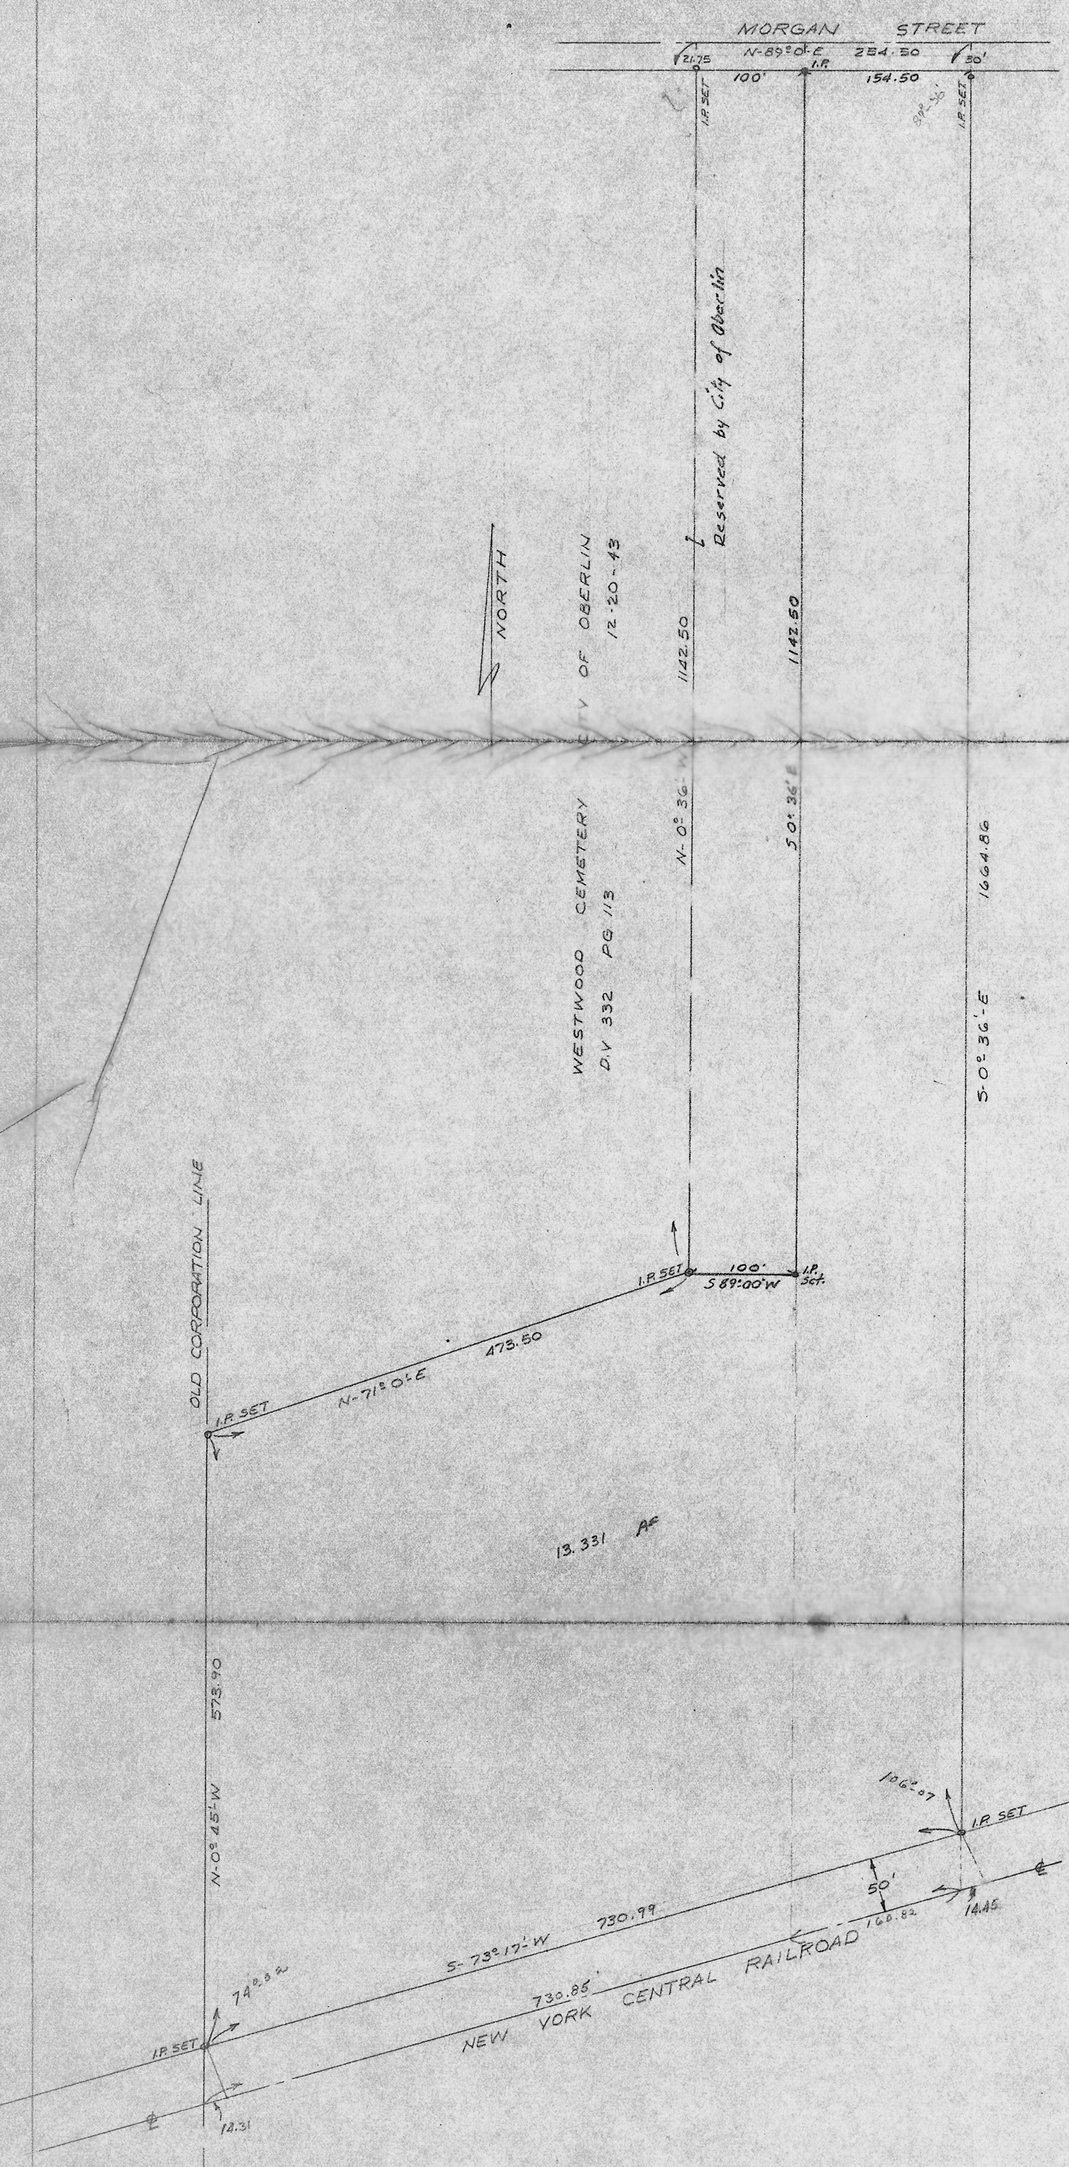

SURVEY FOR THE CITY OF OBERLIN

PART OF O.L. 94 RUSSIA TWP

OBERLIN CITY LORAIN COUNTY OHIO

SCALE: 1" = 100' JUNE 1966

LAUNDON-HUFFMAN & SIMON - REG. SURVEYORS

STATE OF OHIO
REGISTERED
SURVEYOR