

PPN 9-00-085-112.777

W. COLLEGE STREET

56.0

PLACE 495

COLLEGE

56.0

SOUTH MAIN ST

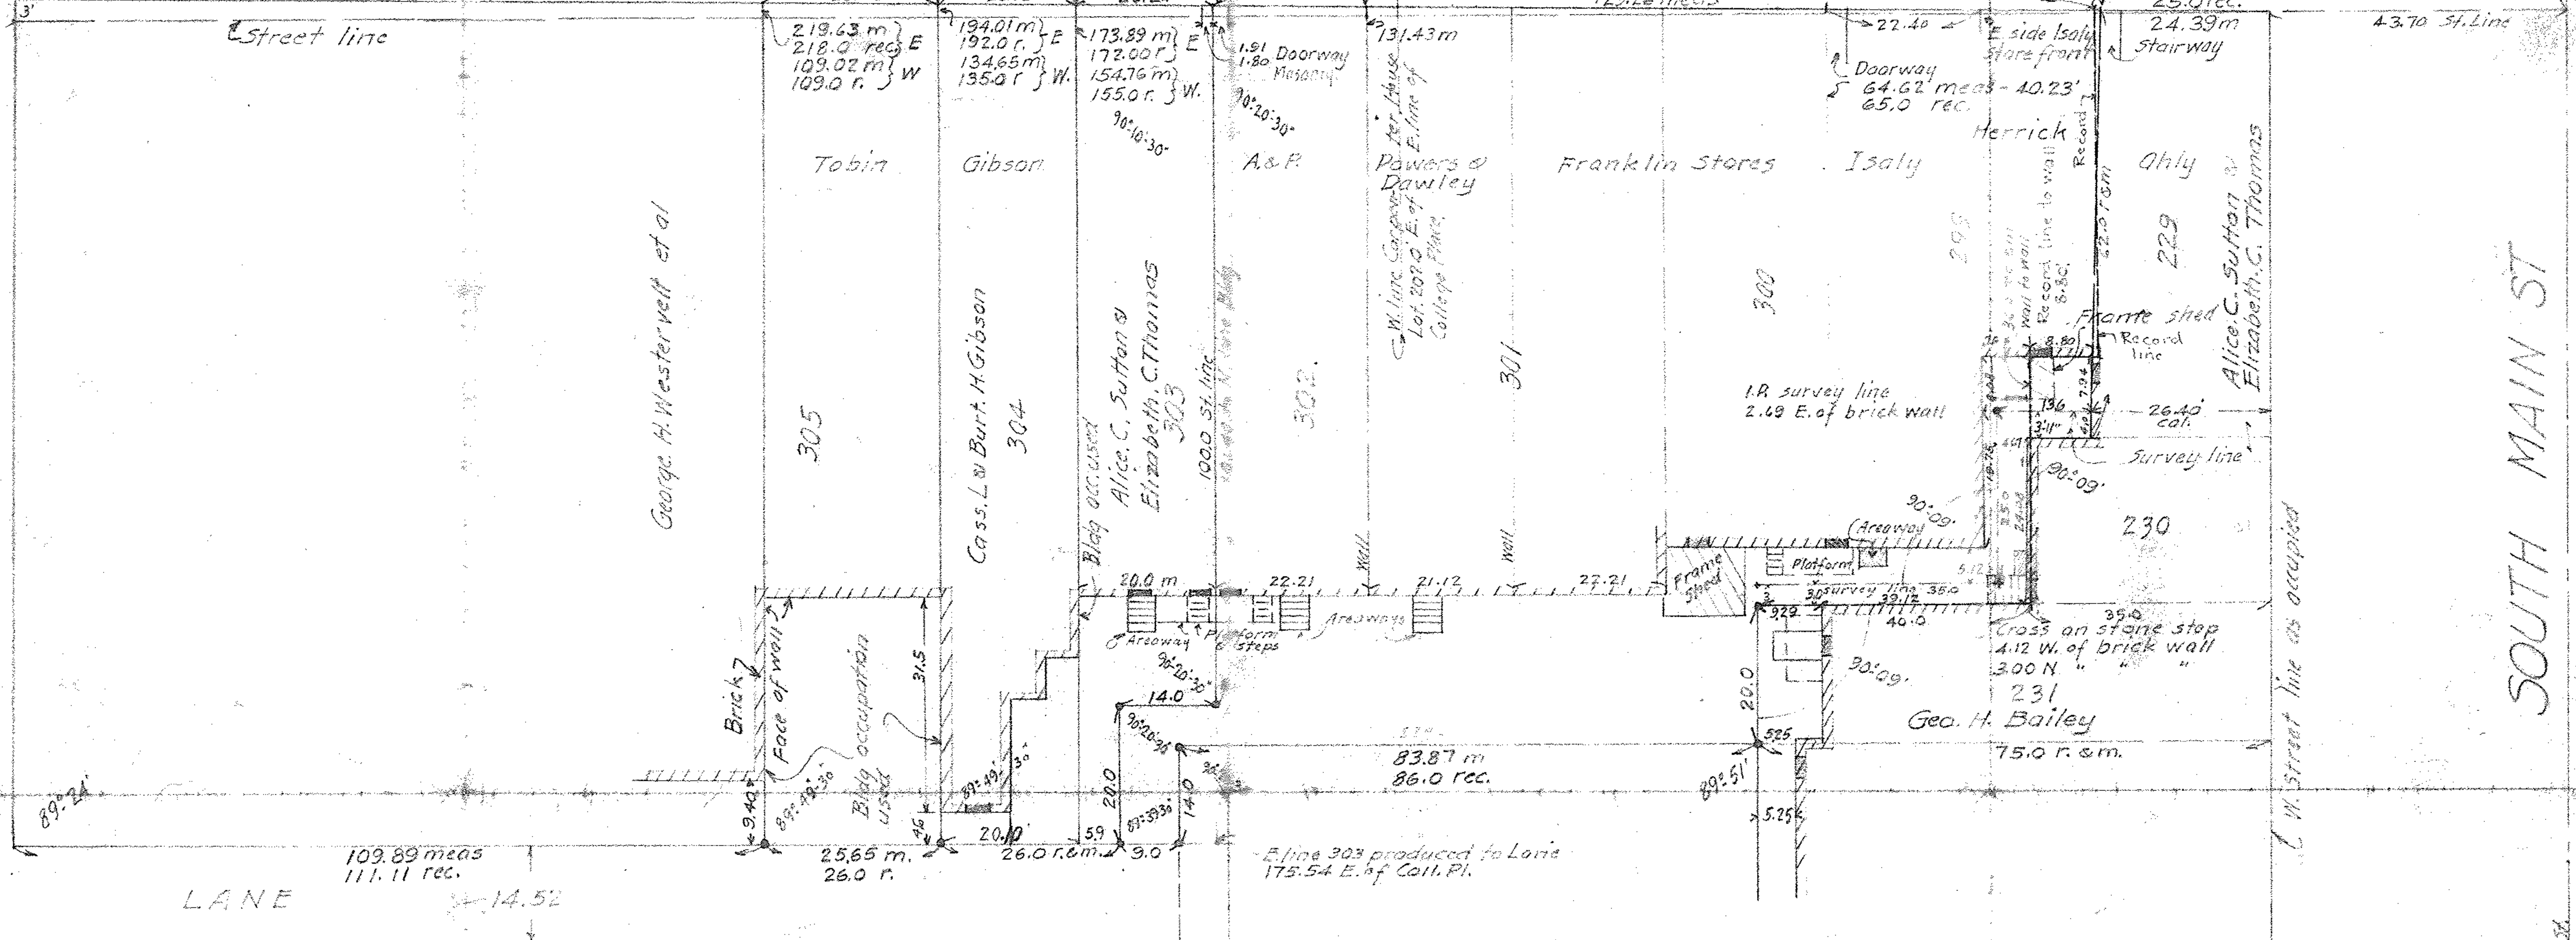
1/2 E. Vine St.

396.51 rec. & meas. N 89°30' E. rec.

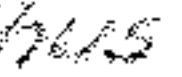
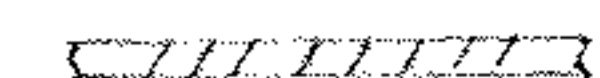
Note- Tobin, Gibson, Sutton, Carpenter lots are referenced to W. line of Carpenter house lot; D.V. 16-306 Begins 109.0 E. Coll. Place; D.V. 21-608-135.0 E.; D.V. 42-75-175.0 E.

Existing Bldg Line

Street line



SURVEY FOR
 CENTRAL NATIONAL BANK OF CLEVELAND TR.
 LOTS 299, 300, 301, 302, 305 ORIG. VILLAGE PLAT
 OBERLIN VILLAGE LORAIN CO. OHIO.
 SCALE 1" = 20' OCT. 1, 1945
 T.W. Laundon Registered Surveyor

Legend: Iron pins shown thus 
 Masonry Walls  W.T. Water table
 Doors 