


09-00-085-103-027
 09-00-085-103-028
 09-00-085-103-032
 09-00-085-103-033
 9-00-085-A

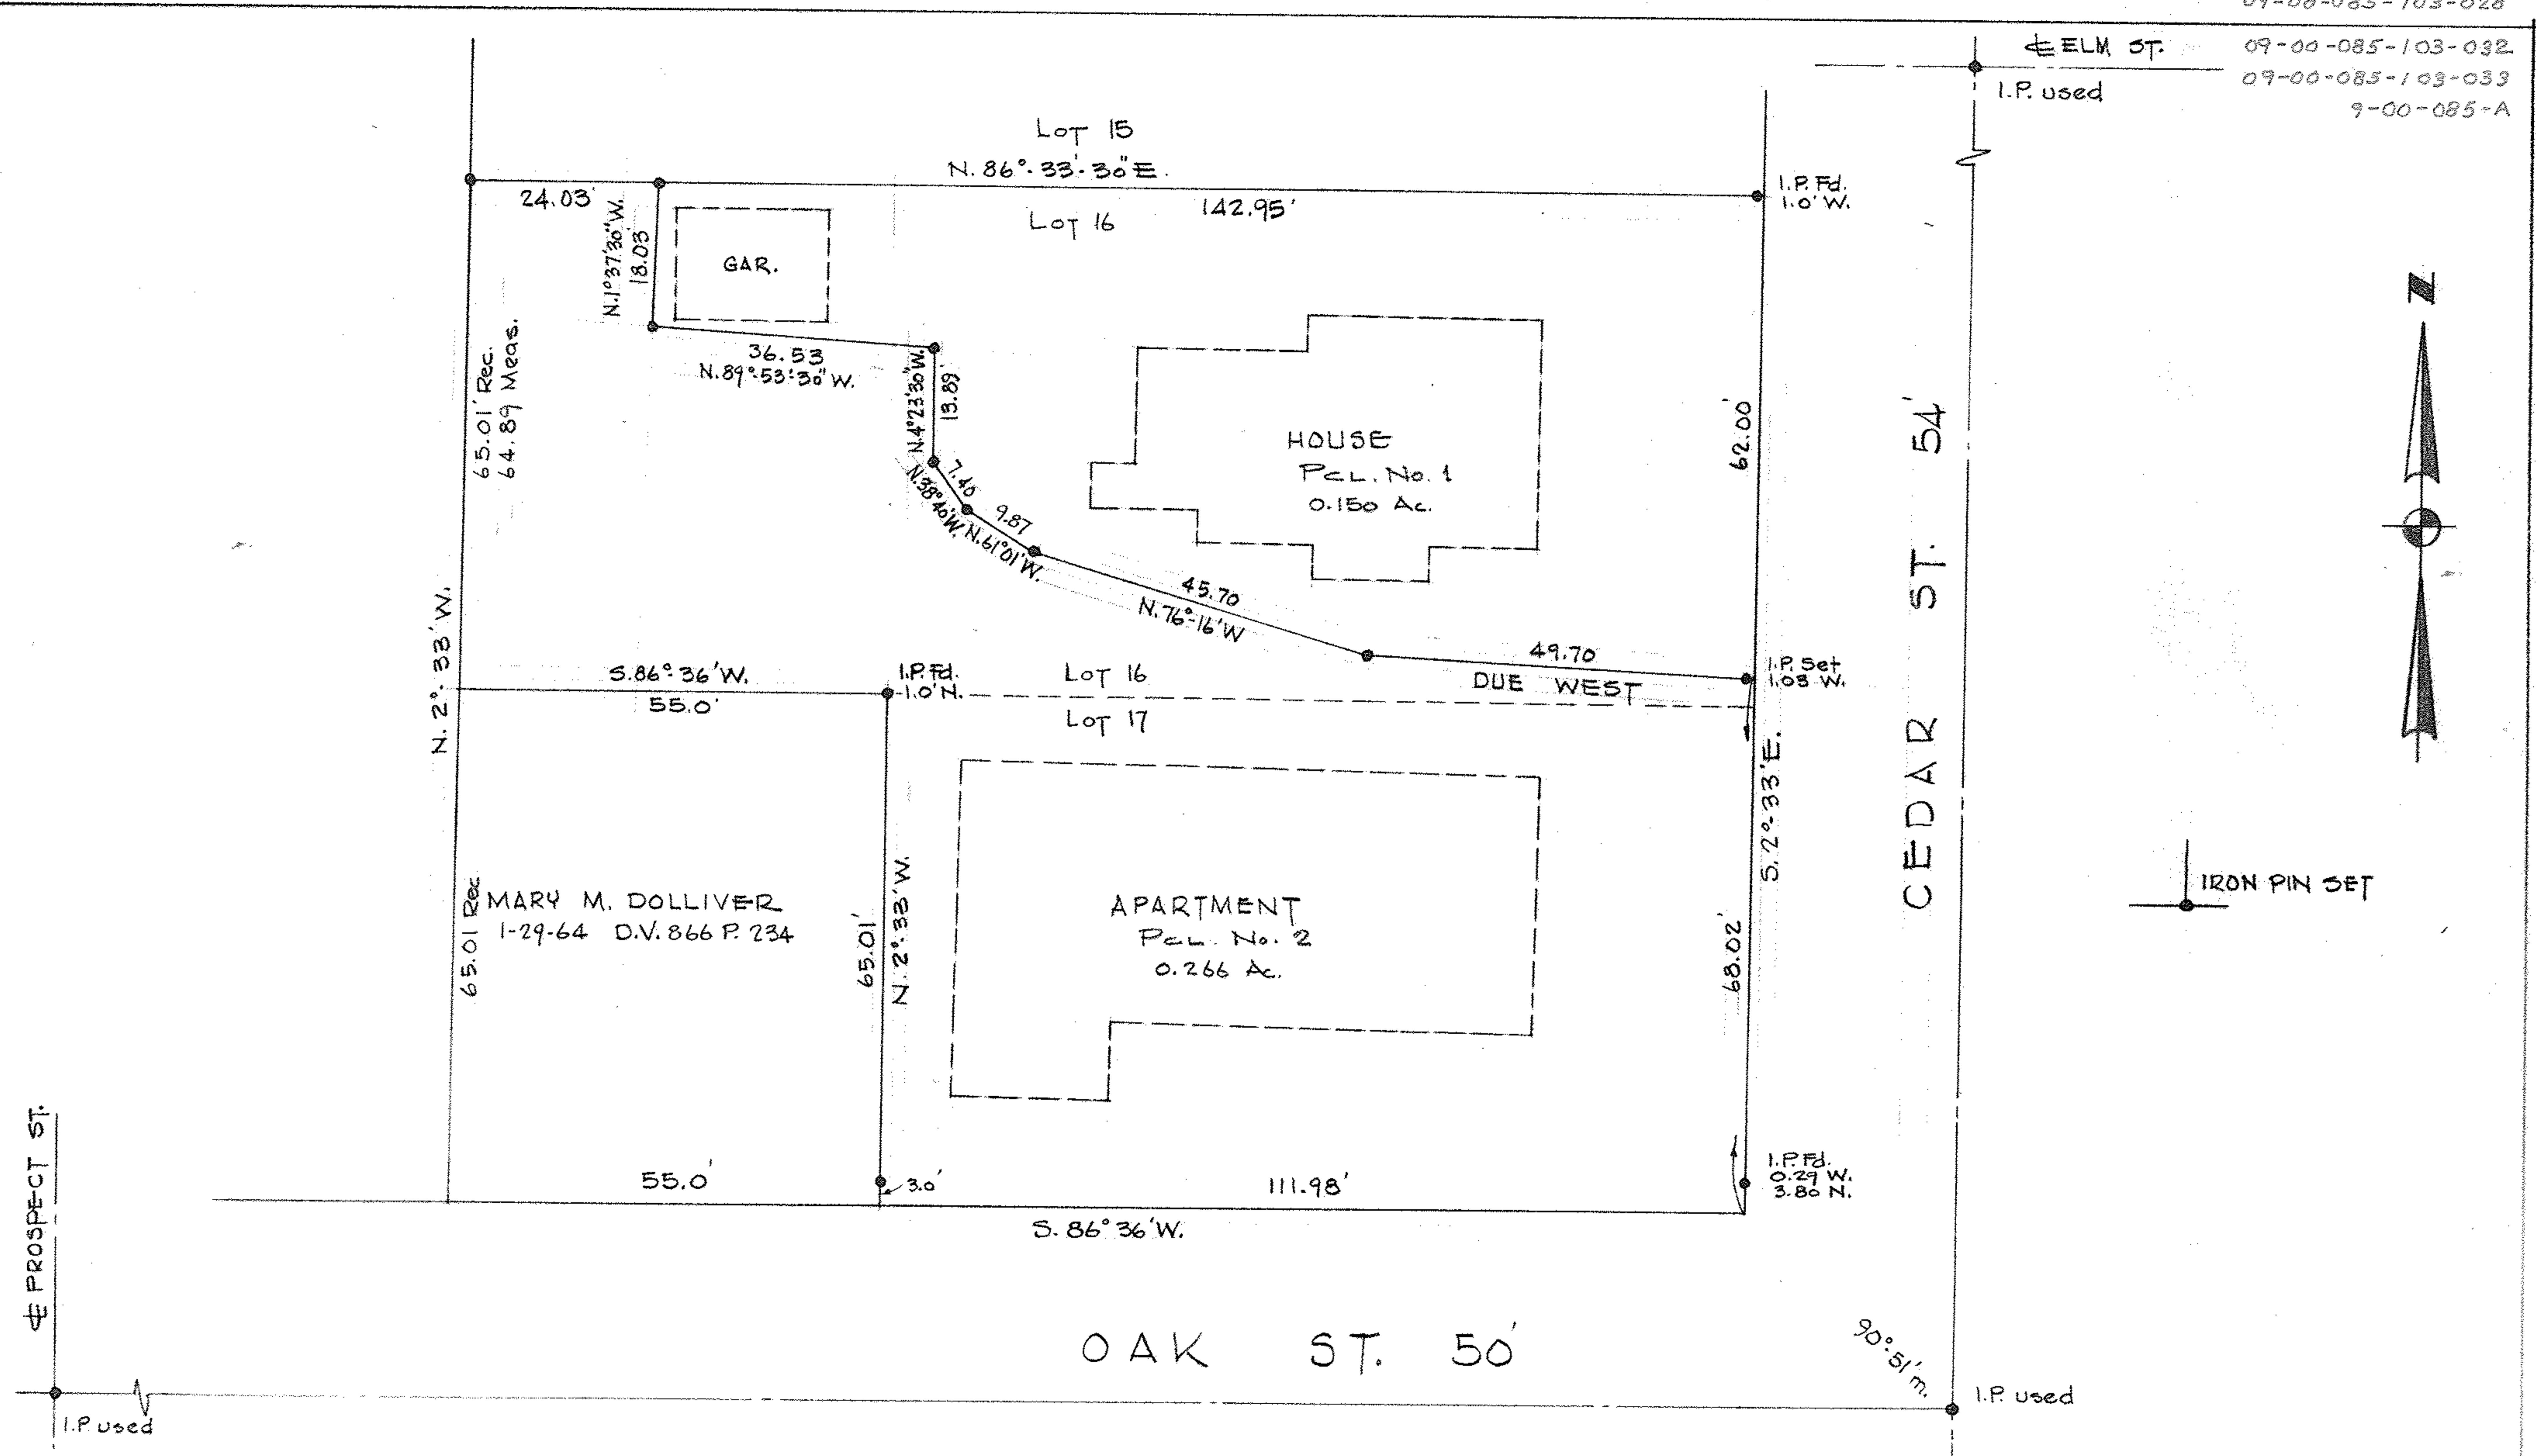

NOTE: BEARINGS SHOWN USED FOR DESCRIPTIVE PURPOSES ONLY.

SURVEY FOR MRS. J. B. TUCKER
 S/L16 PT. S/L17 of THOMPSON & WEBSTER SUB'DV. 2-24
 CITY OF OBERLIN LORAIN COUNTY OHIO
 SCALE 1"=20'
 NOV. 1977
 LAUNDON • SIMON • CAHL & ASSOC.
 ENGINEERS - SURVEYORS