9-00-076-104
9-00-076-B

PPN 09-00-076-104-???

MAP Pg 9-00-076-B

44316

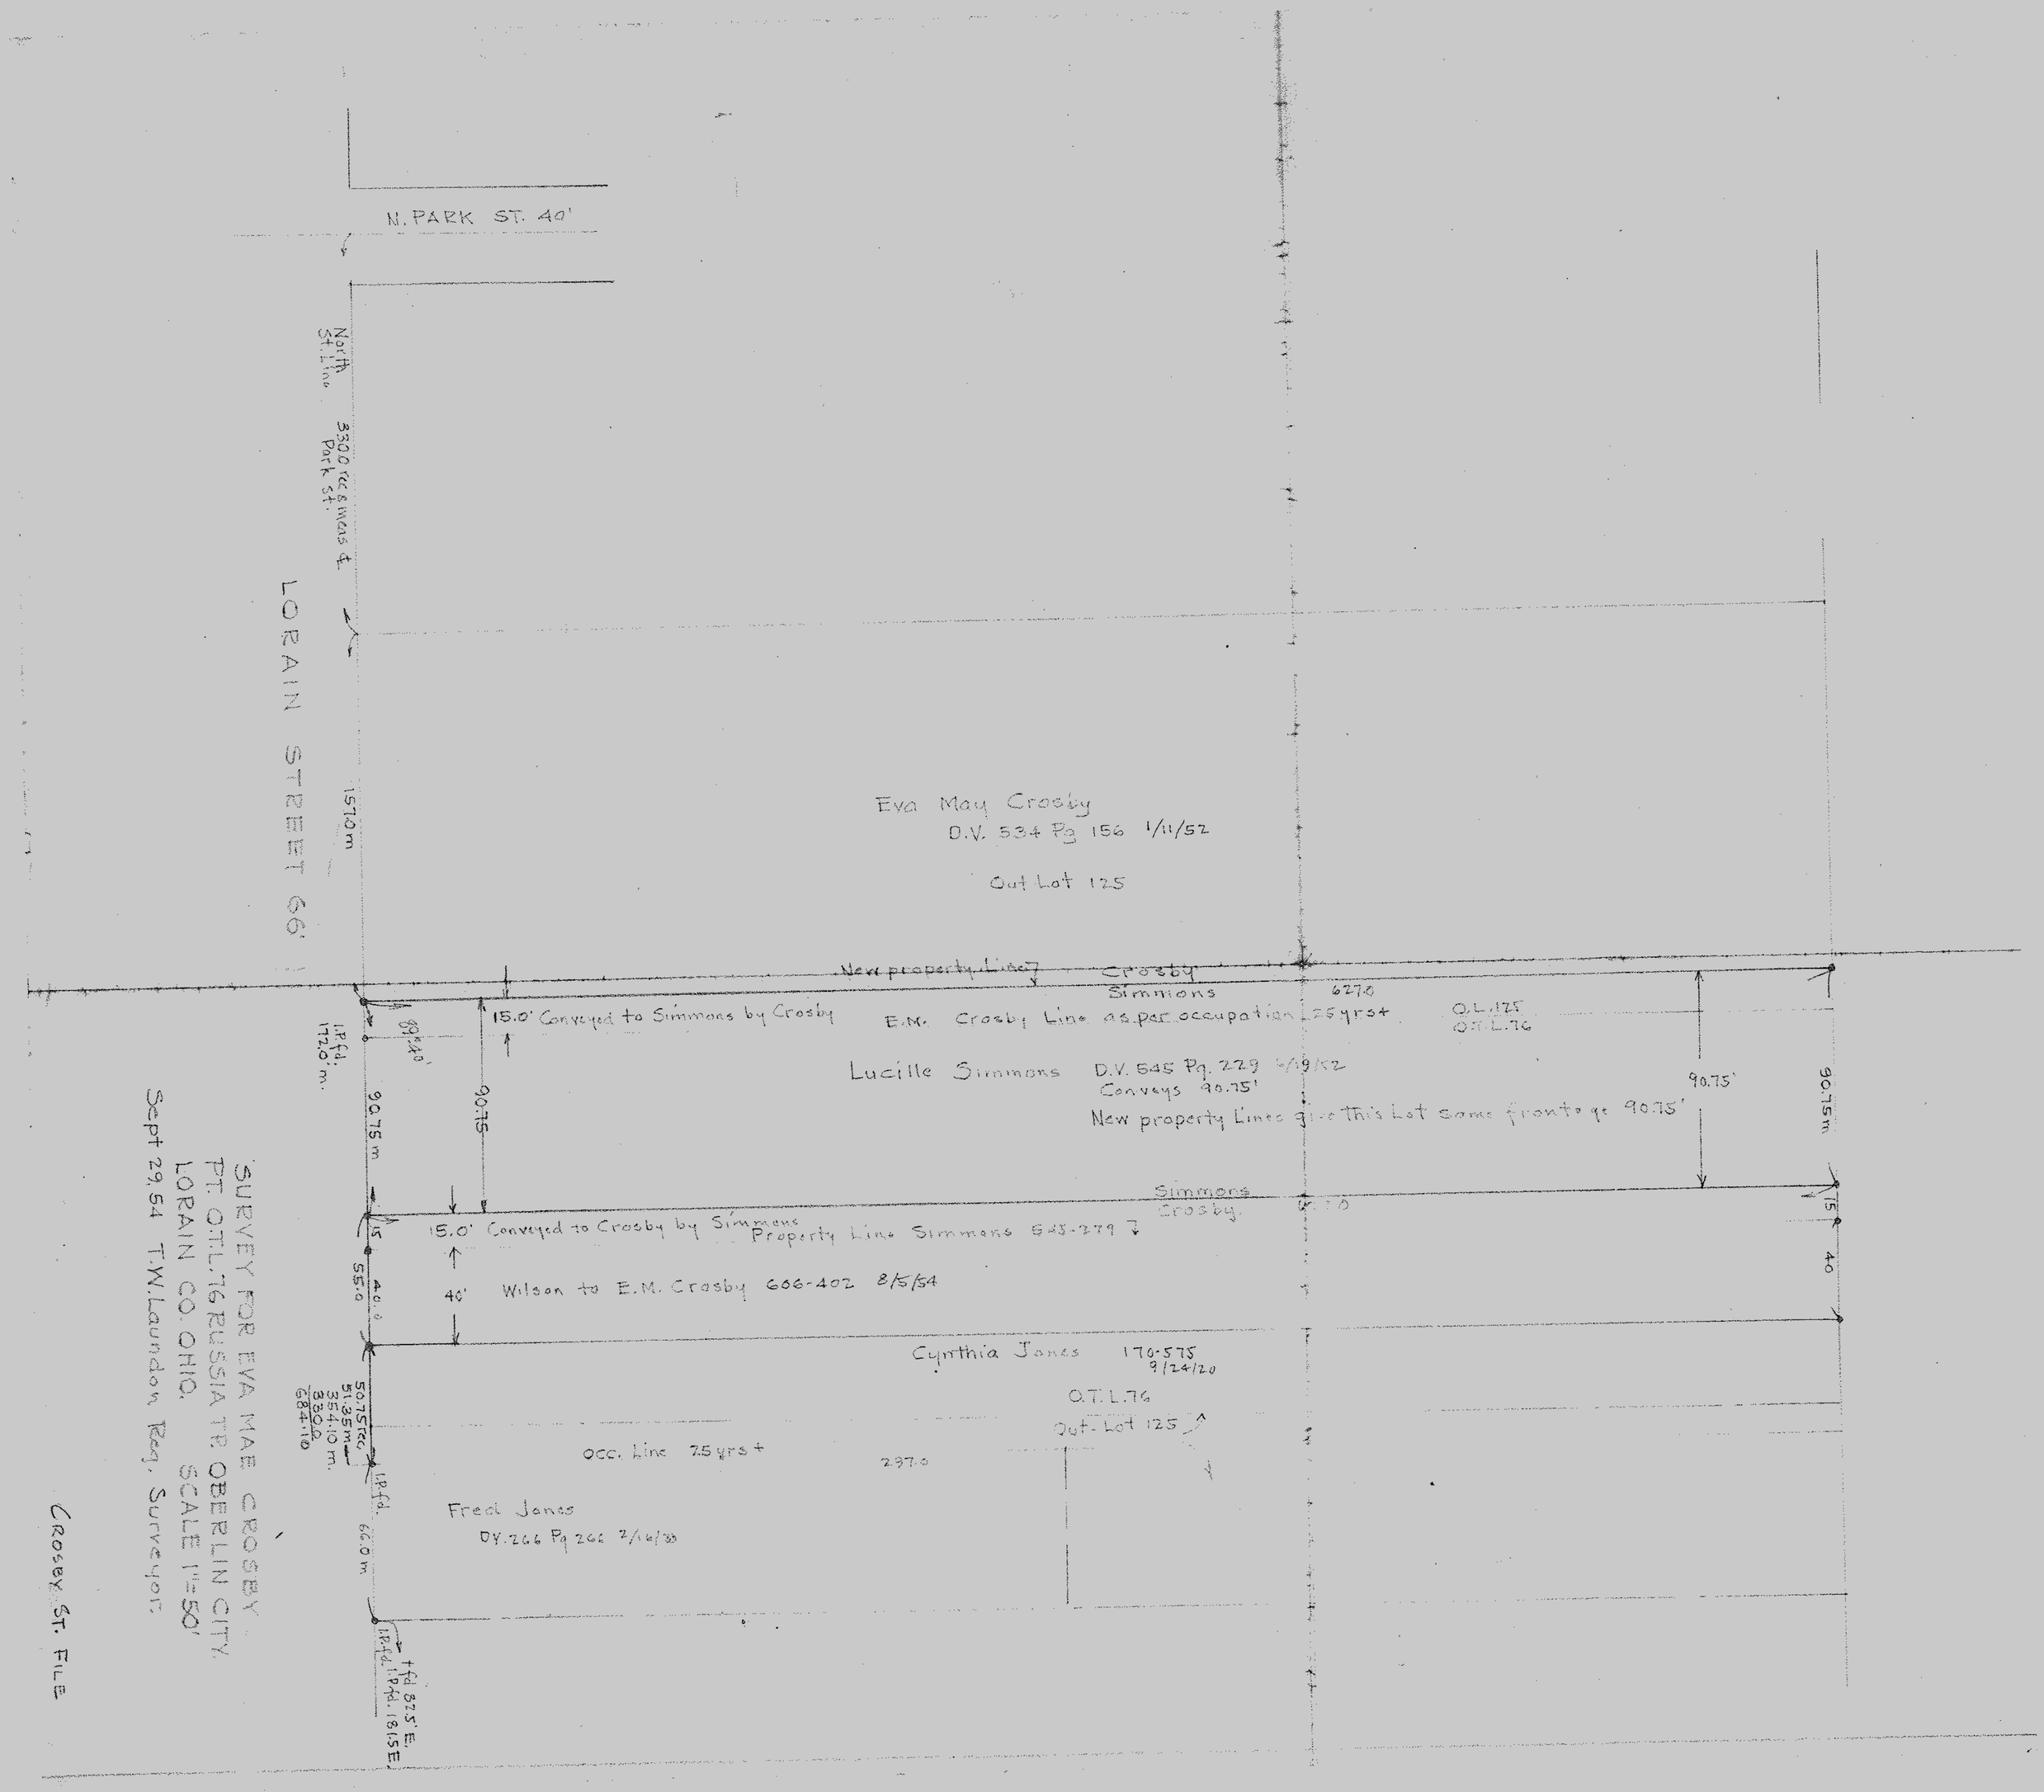

SURVEY FOR EVA MAE CROSBY
PT. O.T.L. 76 RUSSIA TP. OBERLIN CITY.
LORAIN CO. OHIO. SCALE 1"=50'
Sept 29, 54 T.W. Laundon Reg. Surveyor.

CROSBY ST. FILE