10-00-013-B
10-00-013-__
NW CORNER OF PAGE

PPN 10-00-013.000-???

MAP 10-00-013-B

44343

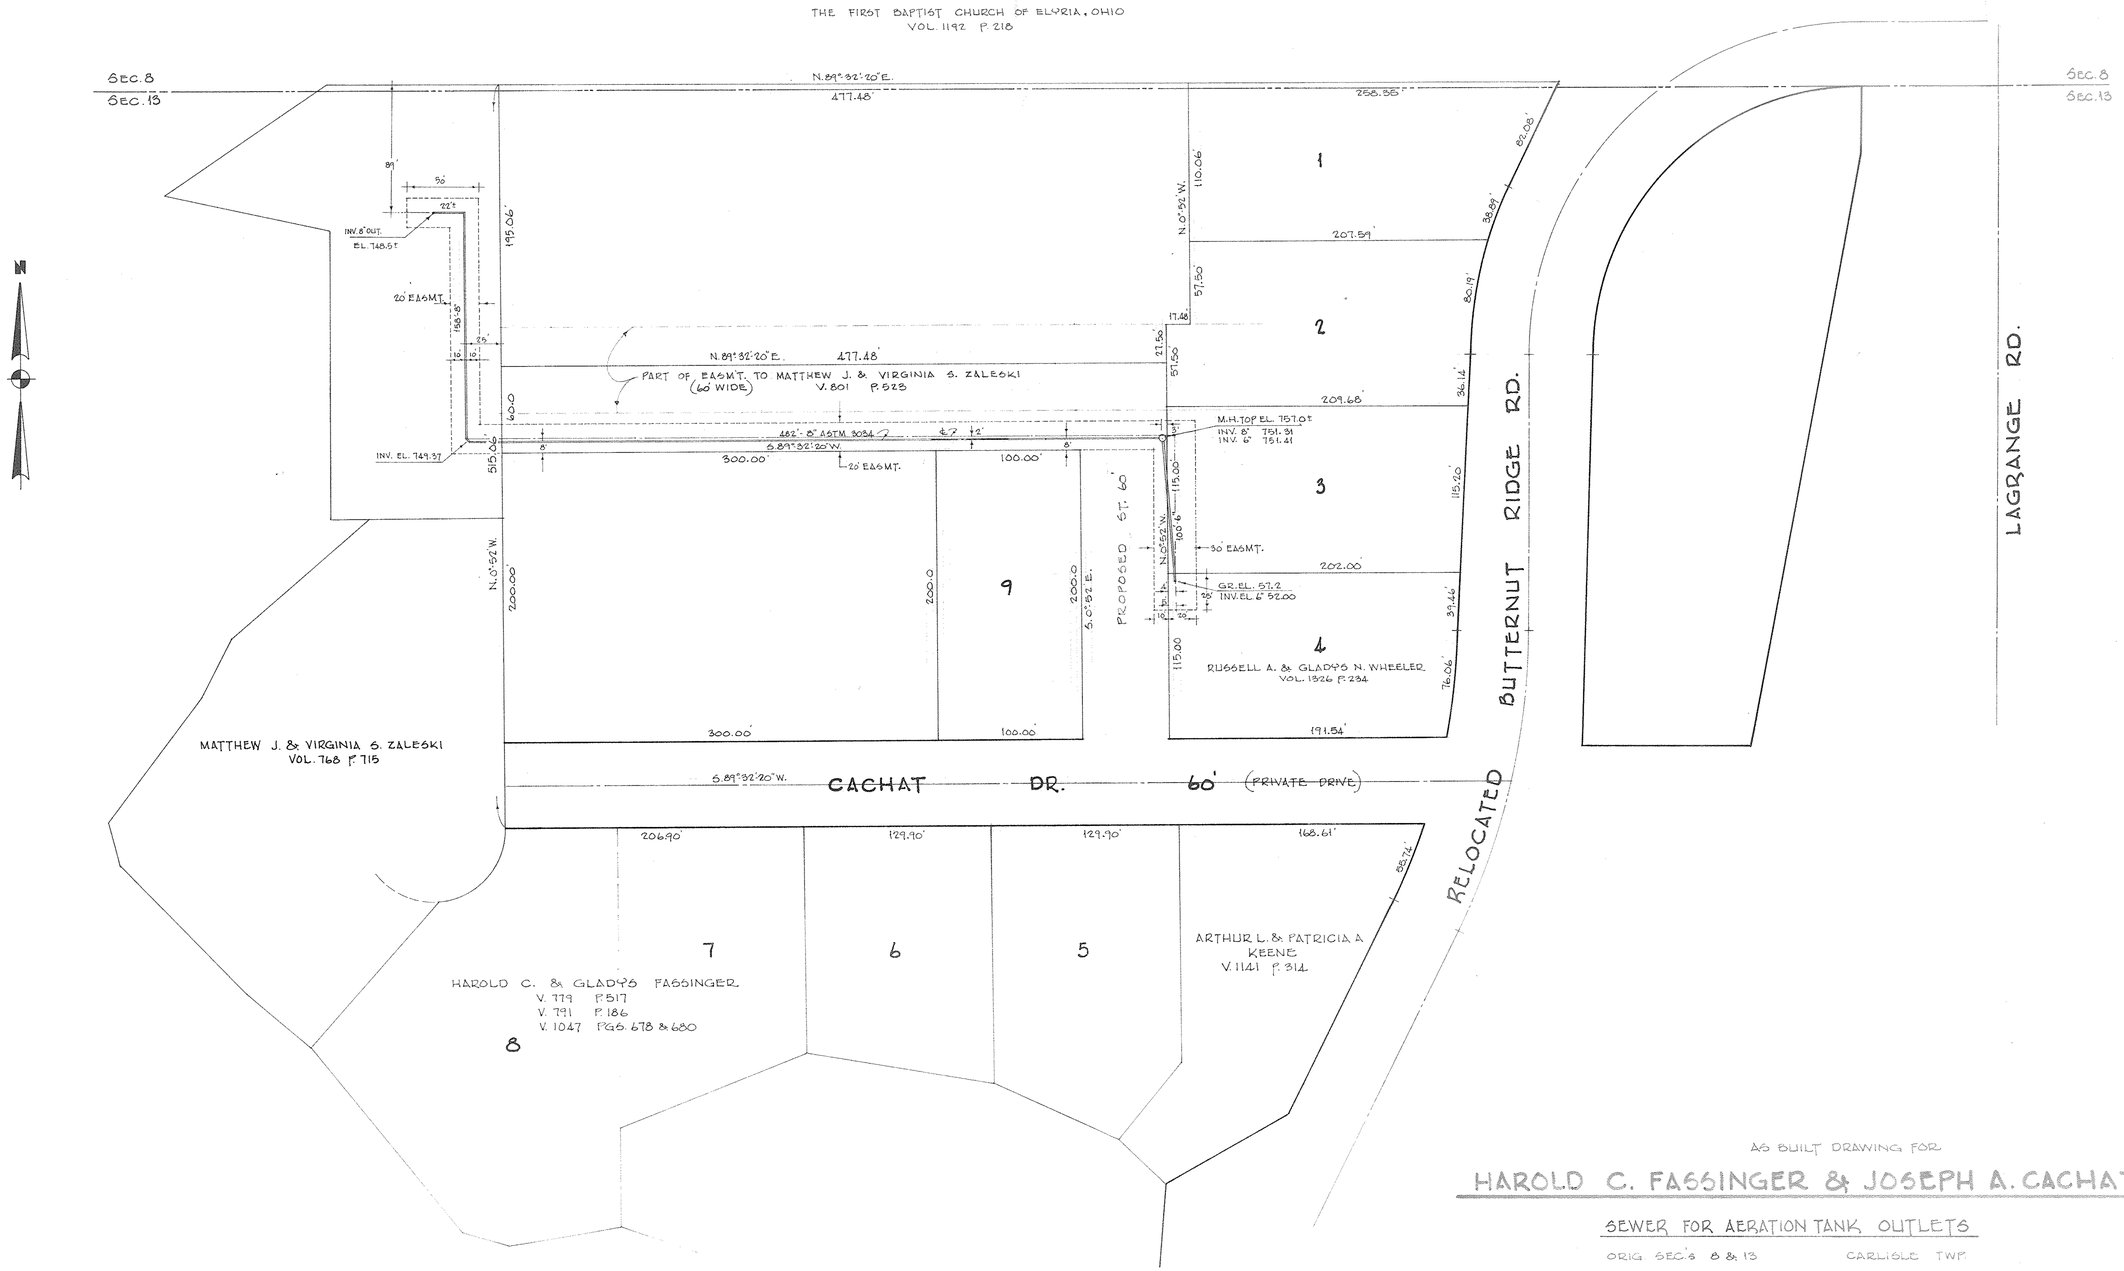

AS BUILT DRAWING FOR

HAROLD C. FASSINGER & JOSEPH A. CACHAT JR.

SEWER FOR AERATION TANK OUTLETS

ORIG. SEC'S 8 & 13 — CARLISLE TWP.
LORAIN COUNTY — OHIO
SCALE 1" = 50' — SEPT. 28, 1983

LAUNDON • SIMON • CAHL & ASSOC.
ENGINEERS — SURVEYORS
JOB No. 83-1209

NOTE:
SURVEY INFORMATION SHOWN AND USED HEREON TAKEN FROM SURVEY BY GARY E. FENFOUND REG. SURVEYOR No. 4457

FB 140 195 56-57

165