10-G
10-00-018-102-001,-006,-007,-027
-024
-025

PPN 10-00-018 102 001
006
007
027
024
025

Map Pg 10-G

44345

BOUNDARY SURVEY
FOR
TOM & KAREN GRAS

ORIGINAL CARLISLE TOWNSHIP
COUNTY OF LORAIN, STATE OF

MAY 25, 1987
SCALE: 1" = 100'

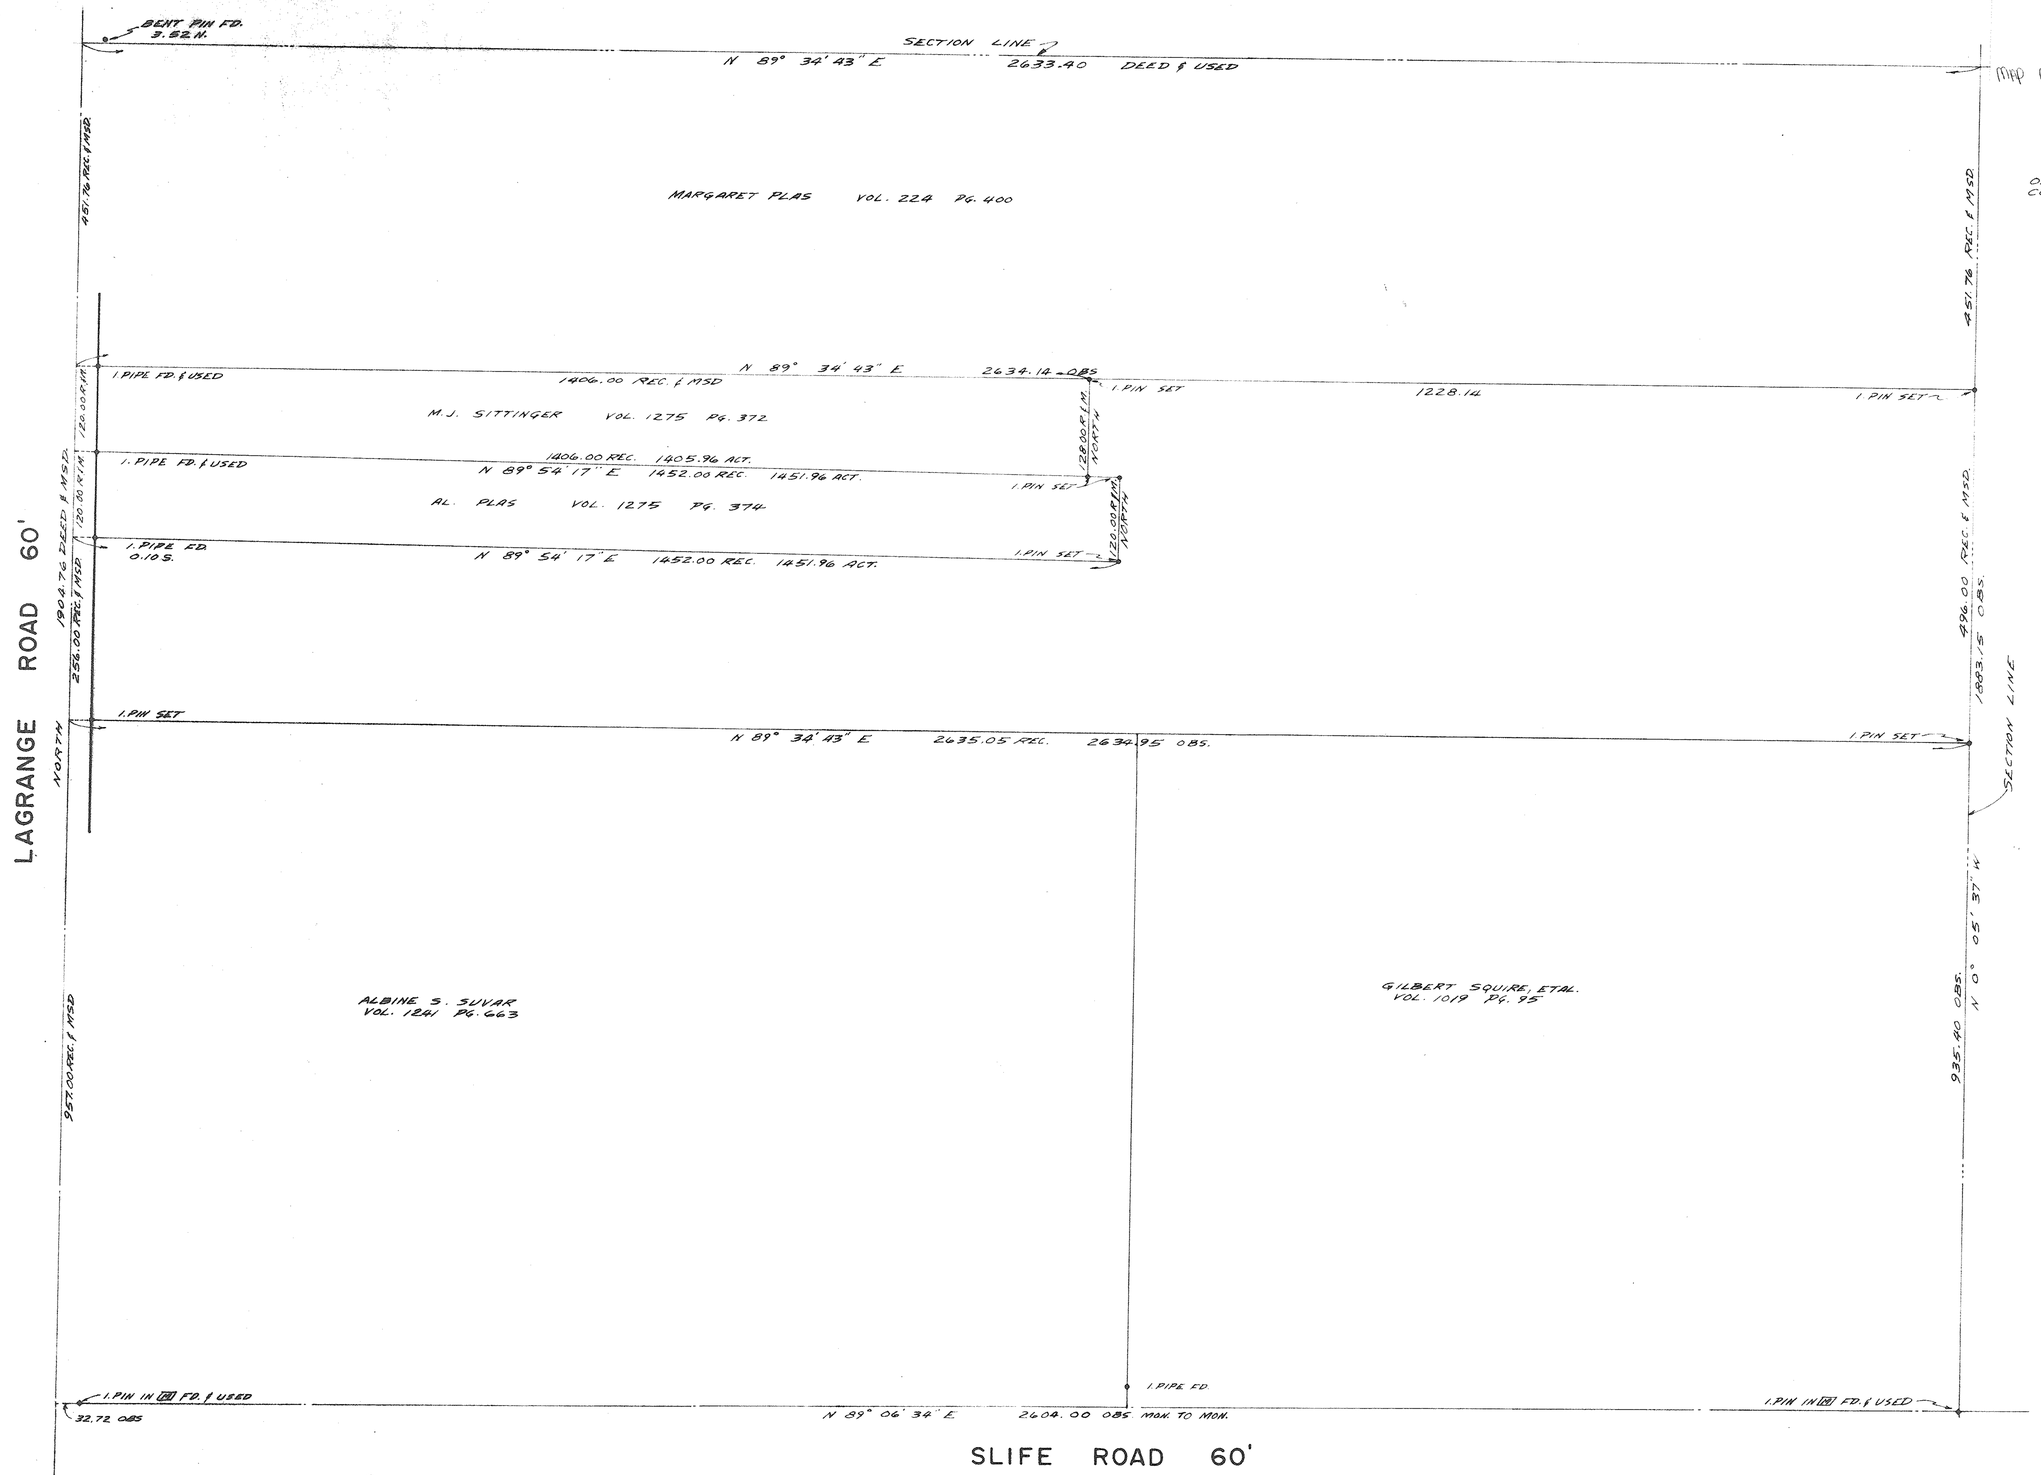

GILBERT SQUIRE, ETAL. VOL. 1019 PG. 95

JAMES A. RESAR, P.E.
REG. OHIO SURVEYOR #63