PPN 10-00-018-000-004
005
024
025

MAP PG 10-G 44349

BOUNDARY SURVEY
FOR
TOM & KAREN GRASSE

ORIGINAL CARLISLE TOWNSHIP SECTION
COUNTY OF LORAIN, STATE OF OHIO

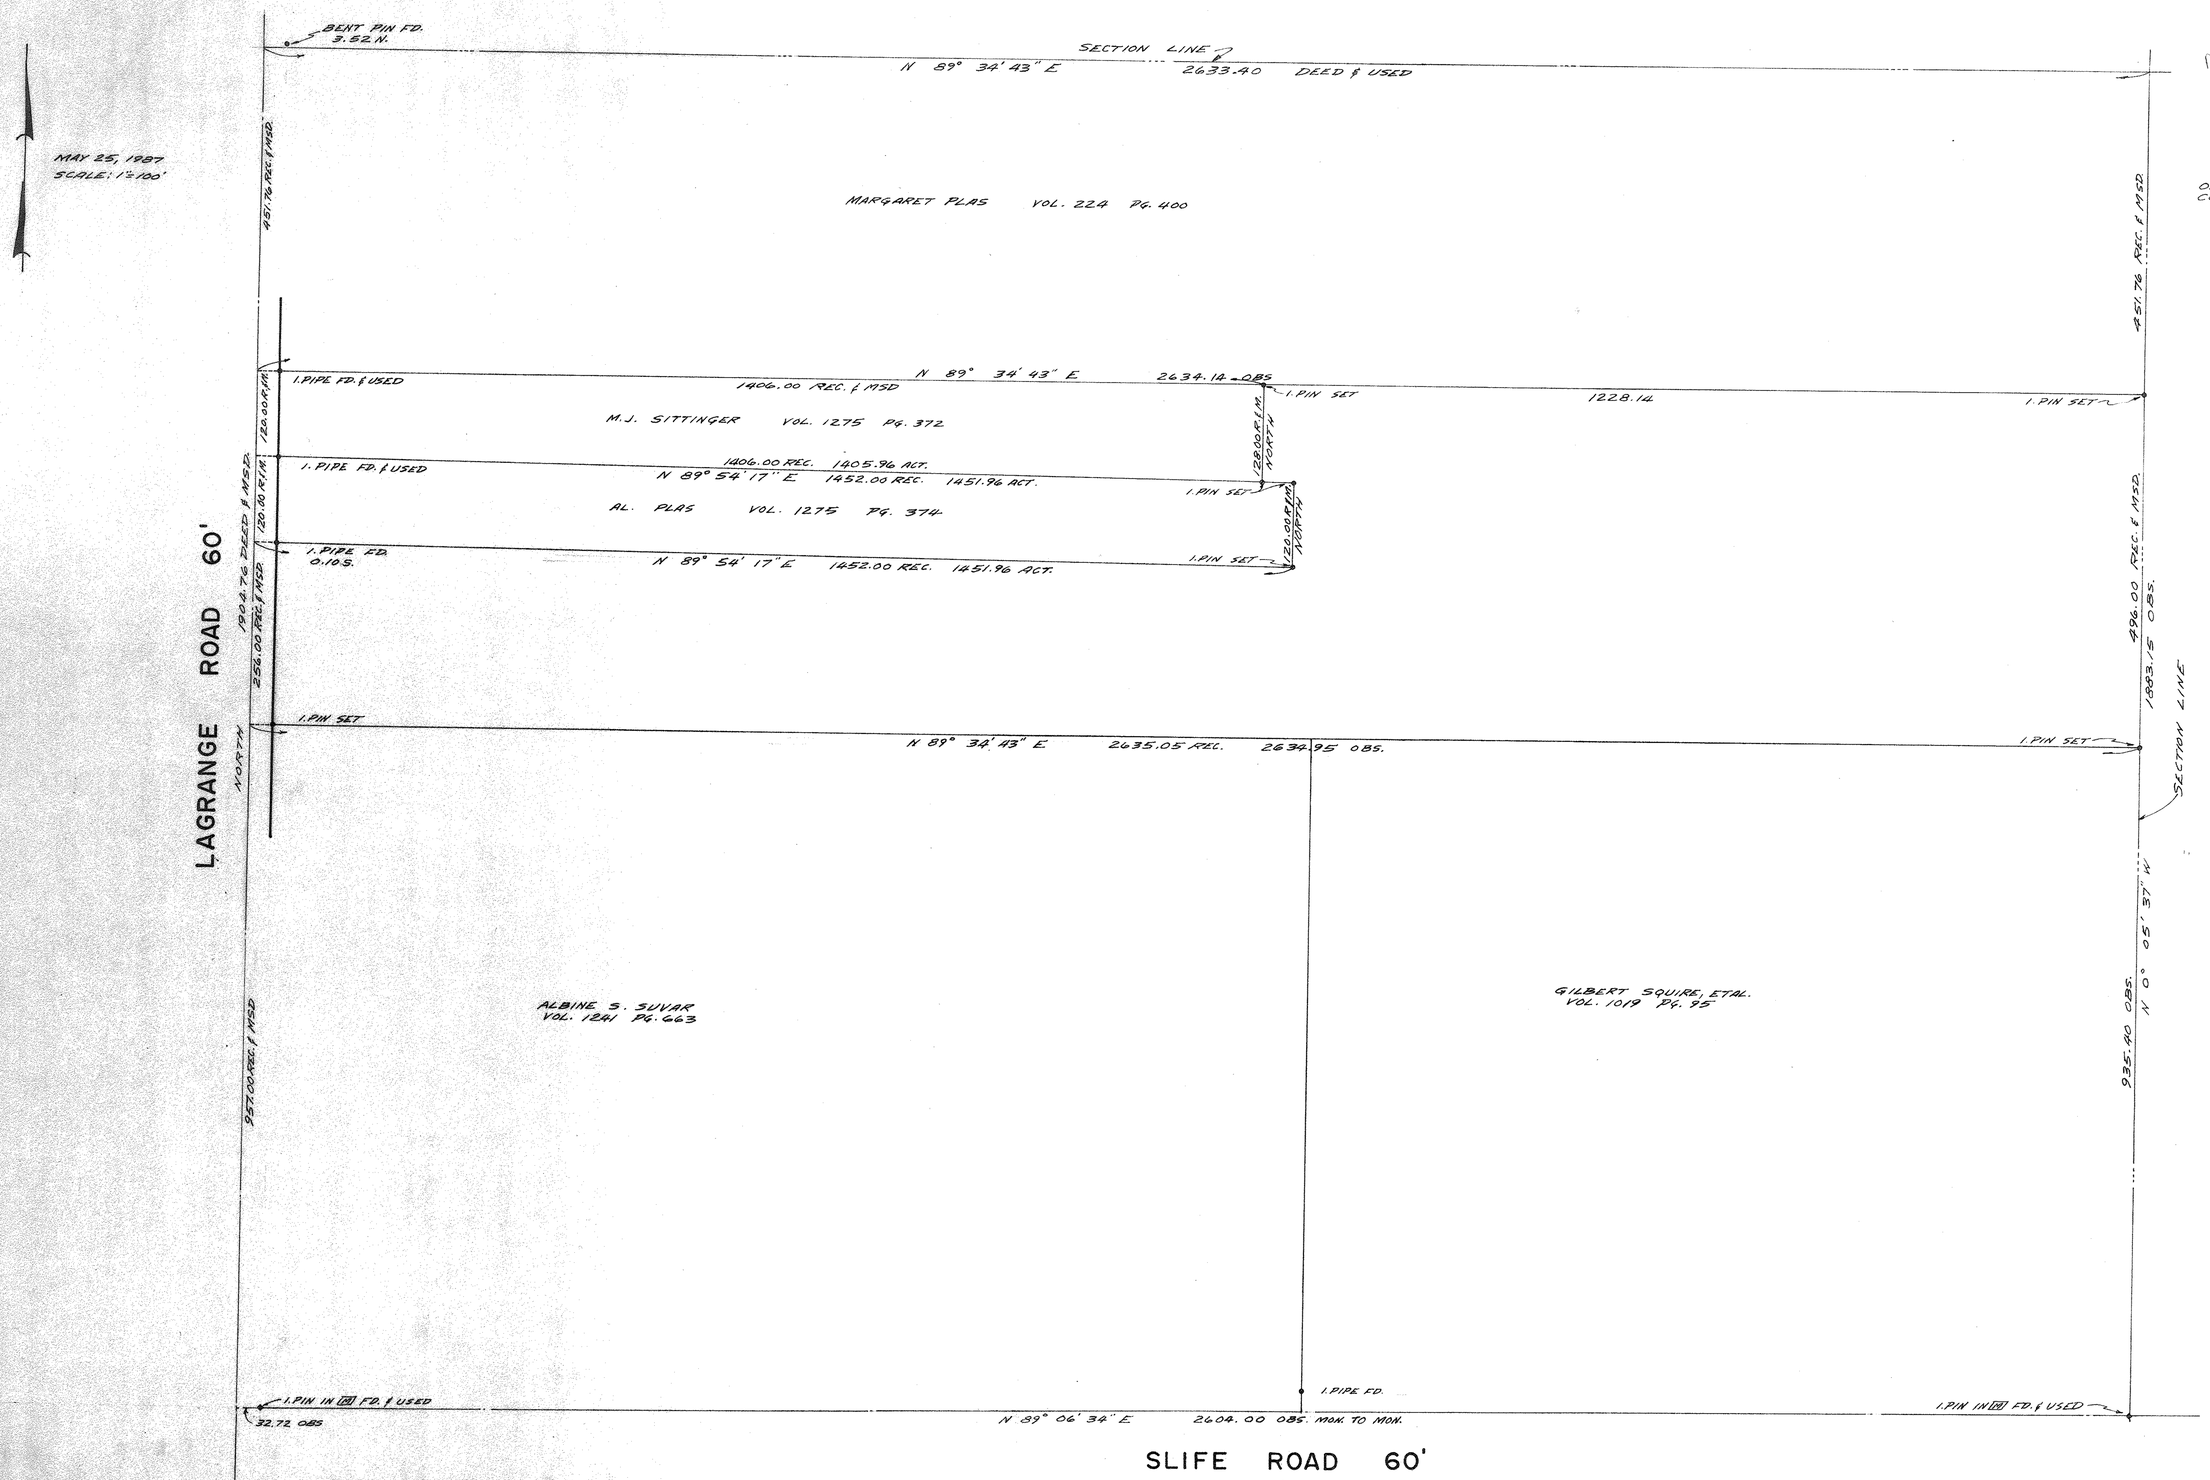

JAMES A. RESAR, P.E.
REG. OHIO SURVEYOR #6361