LORAIN COUNTY
SURVEY BOOK

10-E
10-00-021-000-052

PPN 10-00-021-000-032

MAP Pg 10-E 44362

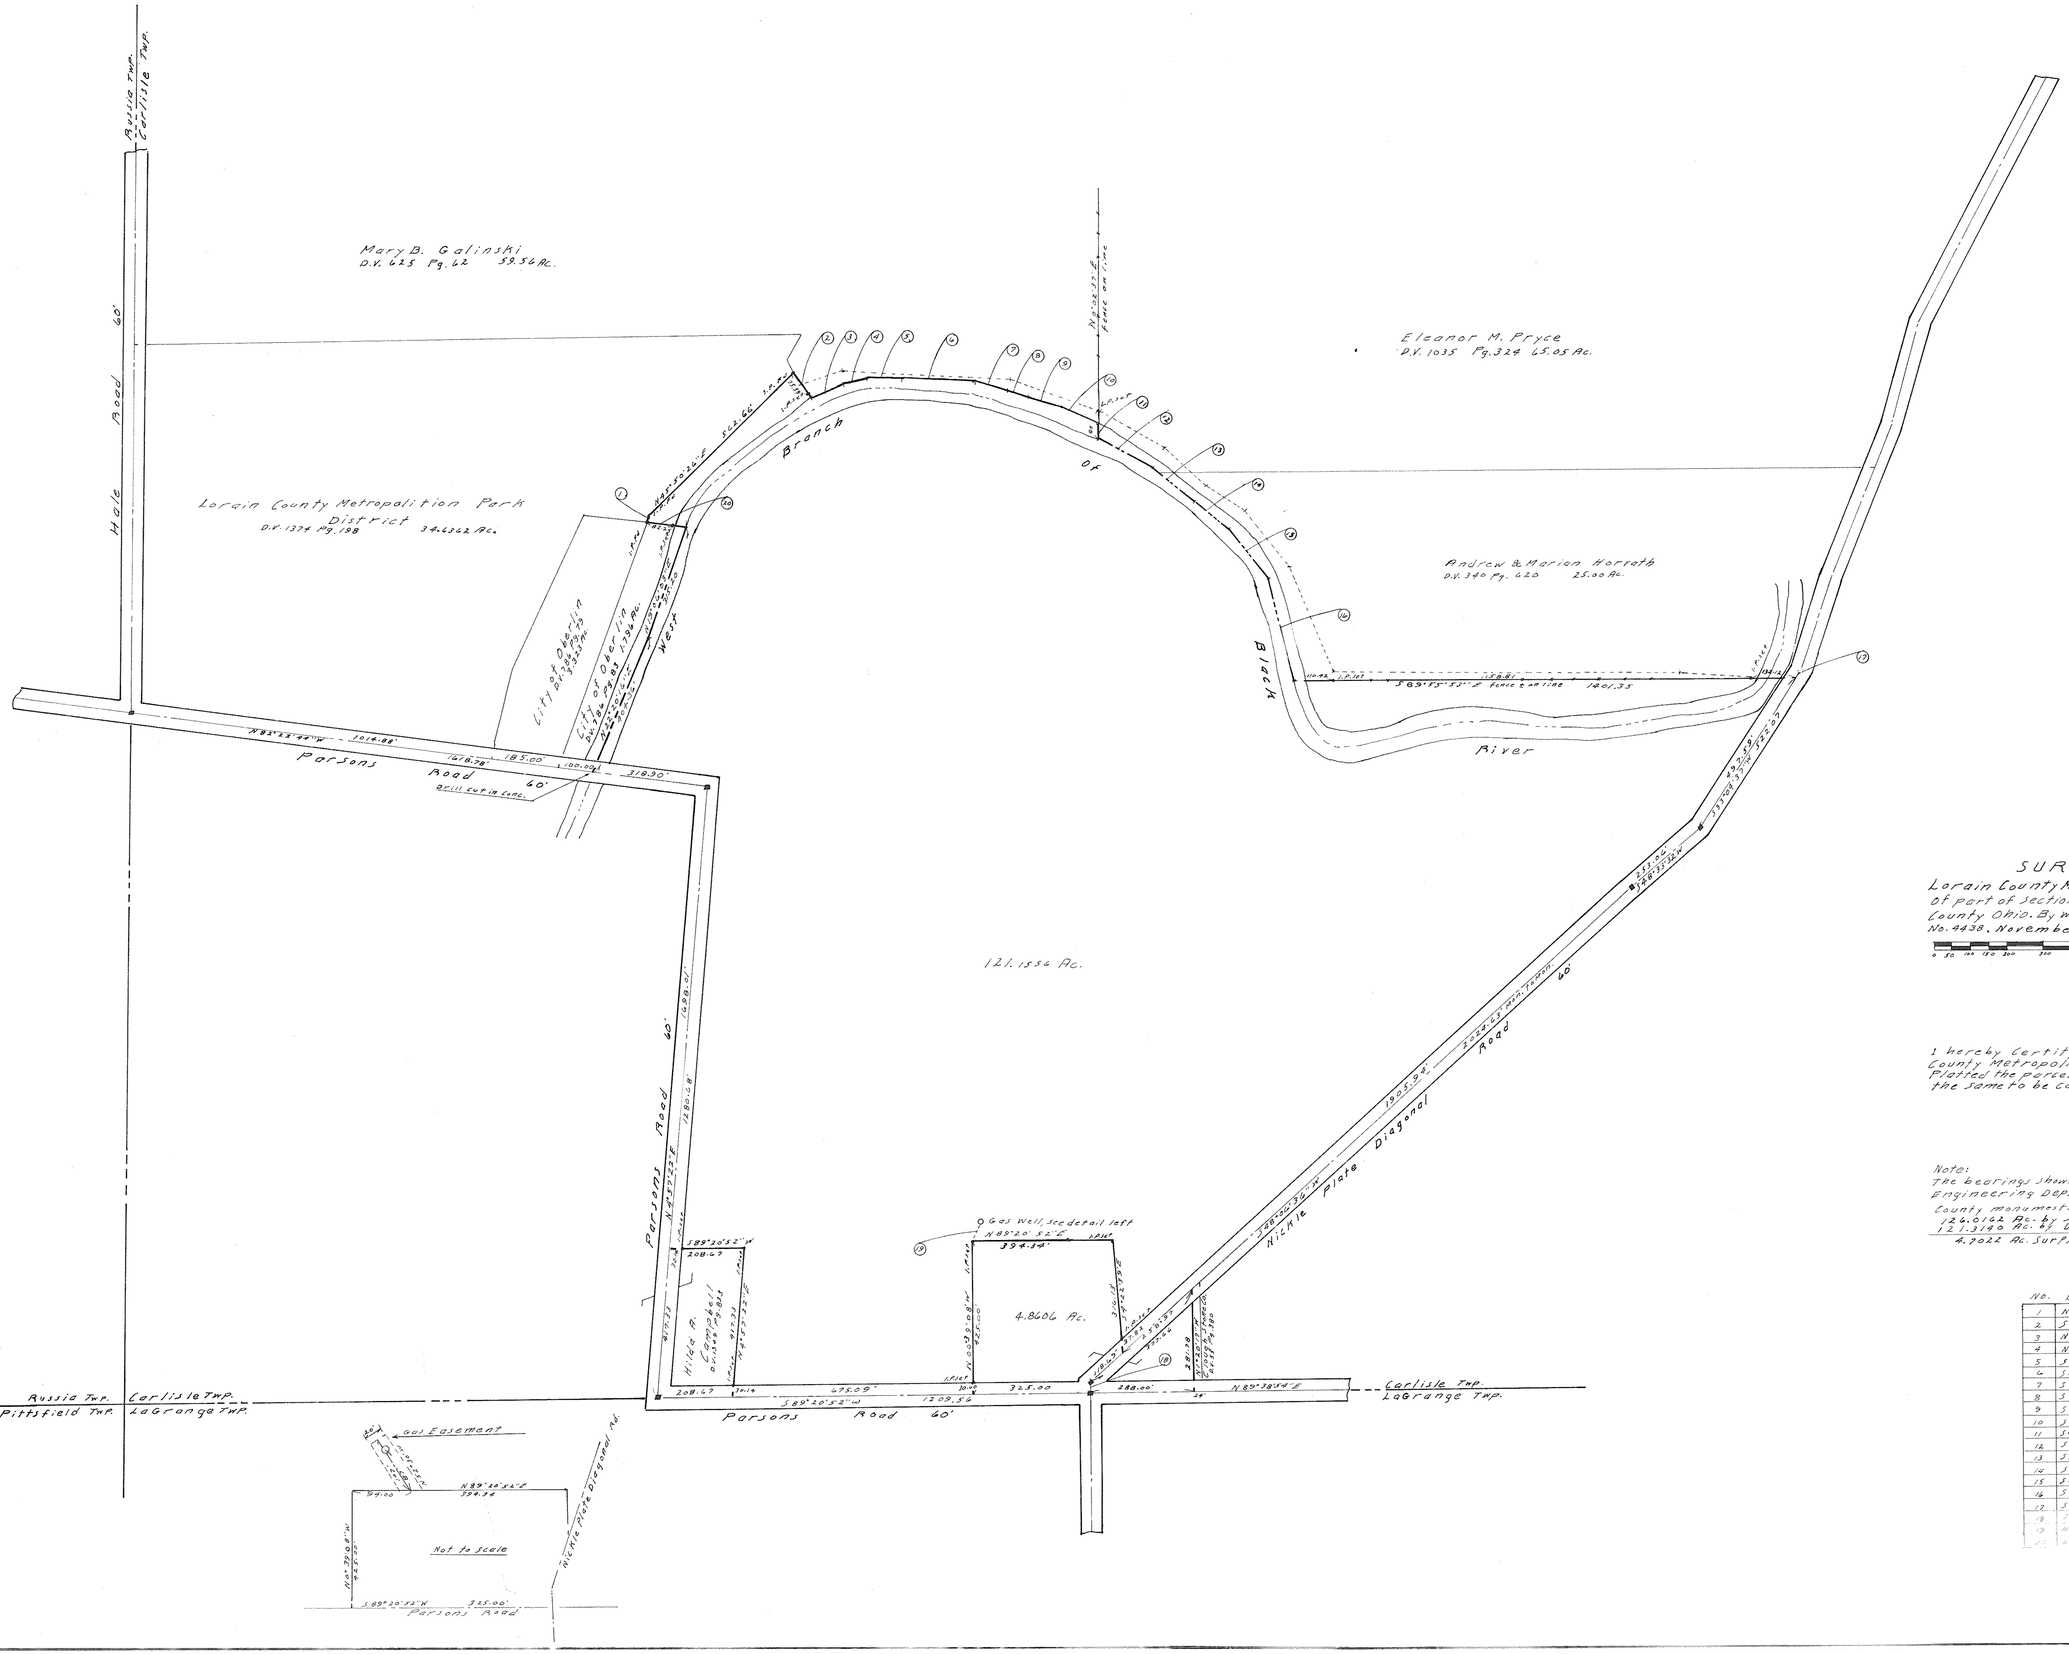

SURVEY FOR
Lorain County Metropolitan Park District of part of section No. 21 Carlisle Township, Lorain County Ohio. By William B. Barton Reg. Surveyor No. 4438. November ,1985. Scale 1" = 200'

0 50 100 150 200 300 400 600 800 1000

I hereby Certify that at the request of the Lorain County Metropolitan Park District I have Surveyed and Plotted the parcel of land as shown hereon and do certify the same to be correct. William B. Barton Reg. Surveyor No. 4438
188 Fern Wood Ave. Avon Lake, Ohio.

Note:
The bearings shown hereon are based on the Lorain County Engineering Dept. Monumenting Program, 1969.
County monuments found & used shown thus
126.0142 Ac. by survey
121.3140 Ac. per Deed Vol. 1242 Pg. 329
4.7022 Ac. Surplus.

No.	Bearing	Distance
1	N 18°53'16" E	29.21'
2	S 39°52'30" E	81.00'
3	N 66°49'10" E	99.92'
4	N 80°15'00" E	62.93'
5	S 89°23'27" E	100.13'
6	S 86°35'53" E	200.00'
7	S 34°53'16" E	95.21'
8	S 75°46'37" E	85.83'
9	S 33°50'09" E	100.13'
10	S 64°36'09" E	110.12'
11	S 00°02'32" W	85.00'
12	S 60°18'26" E	163.30'
13	S 59°59'04" E	158.06'
14	S 51°53'40" E	121.48'
15	S 16°55'49" E	138.39'
16	S 14°13'21" E	285.59'
17	S 33°08'52" W	24.48
18	S 00°30'00" W	31.51'
19	N 29°49'55" E	59.52
20	N 88°22'44" W	113.26

156

STATE OF OHIO
WILLIAM B. BARTON
4438
REGISTERED SURVEYOR

2-058