14-00-003-000-002
14-C

PPN 14-00-003-000-002

MAP Pg 14-C

44364

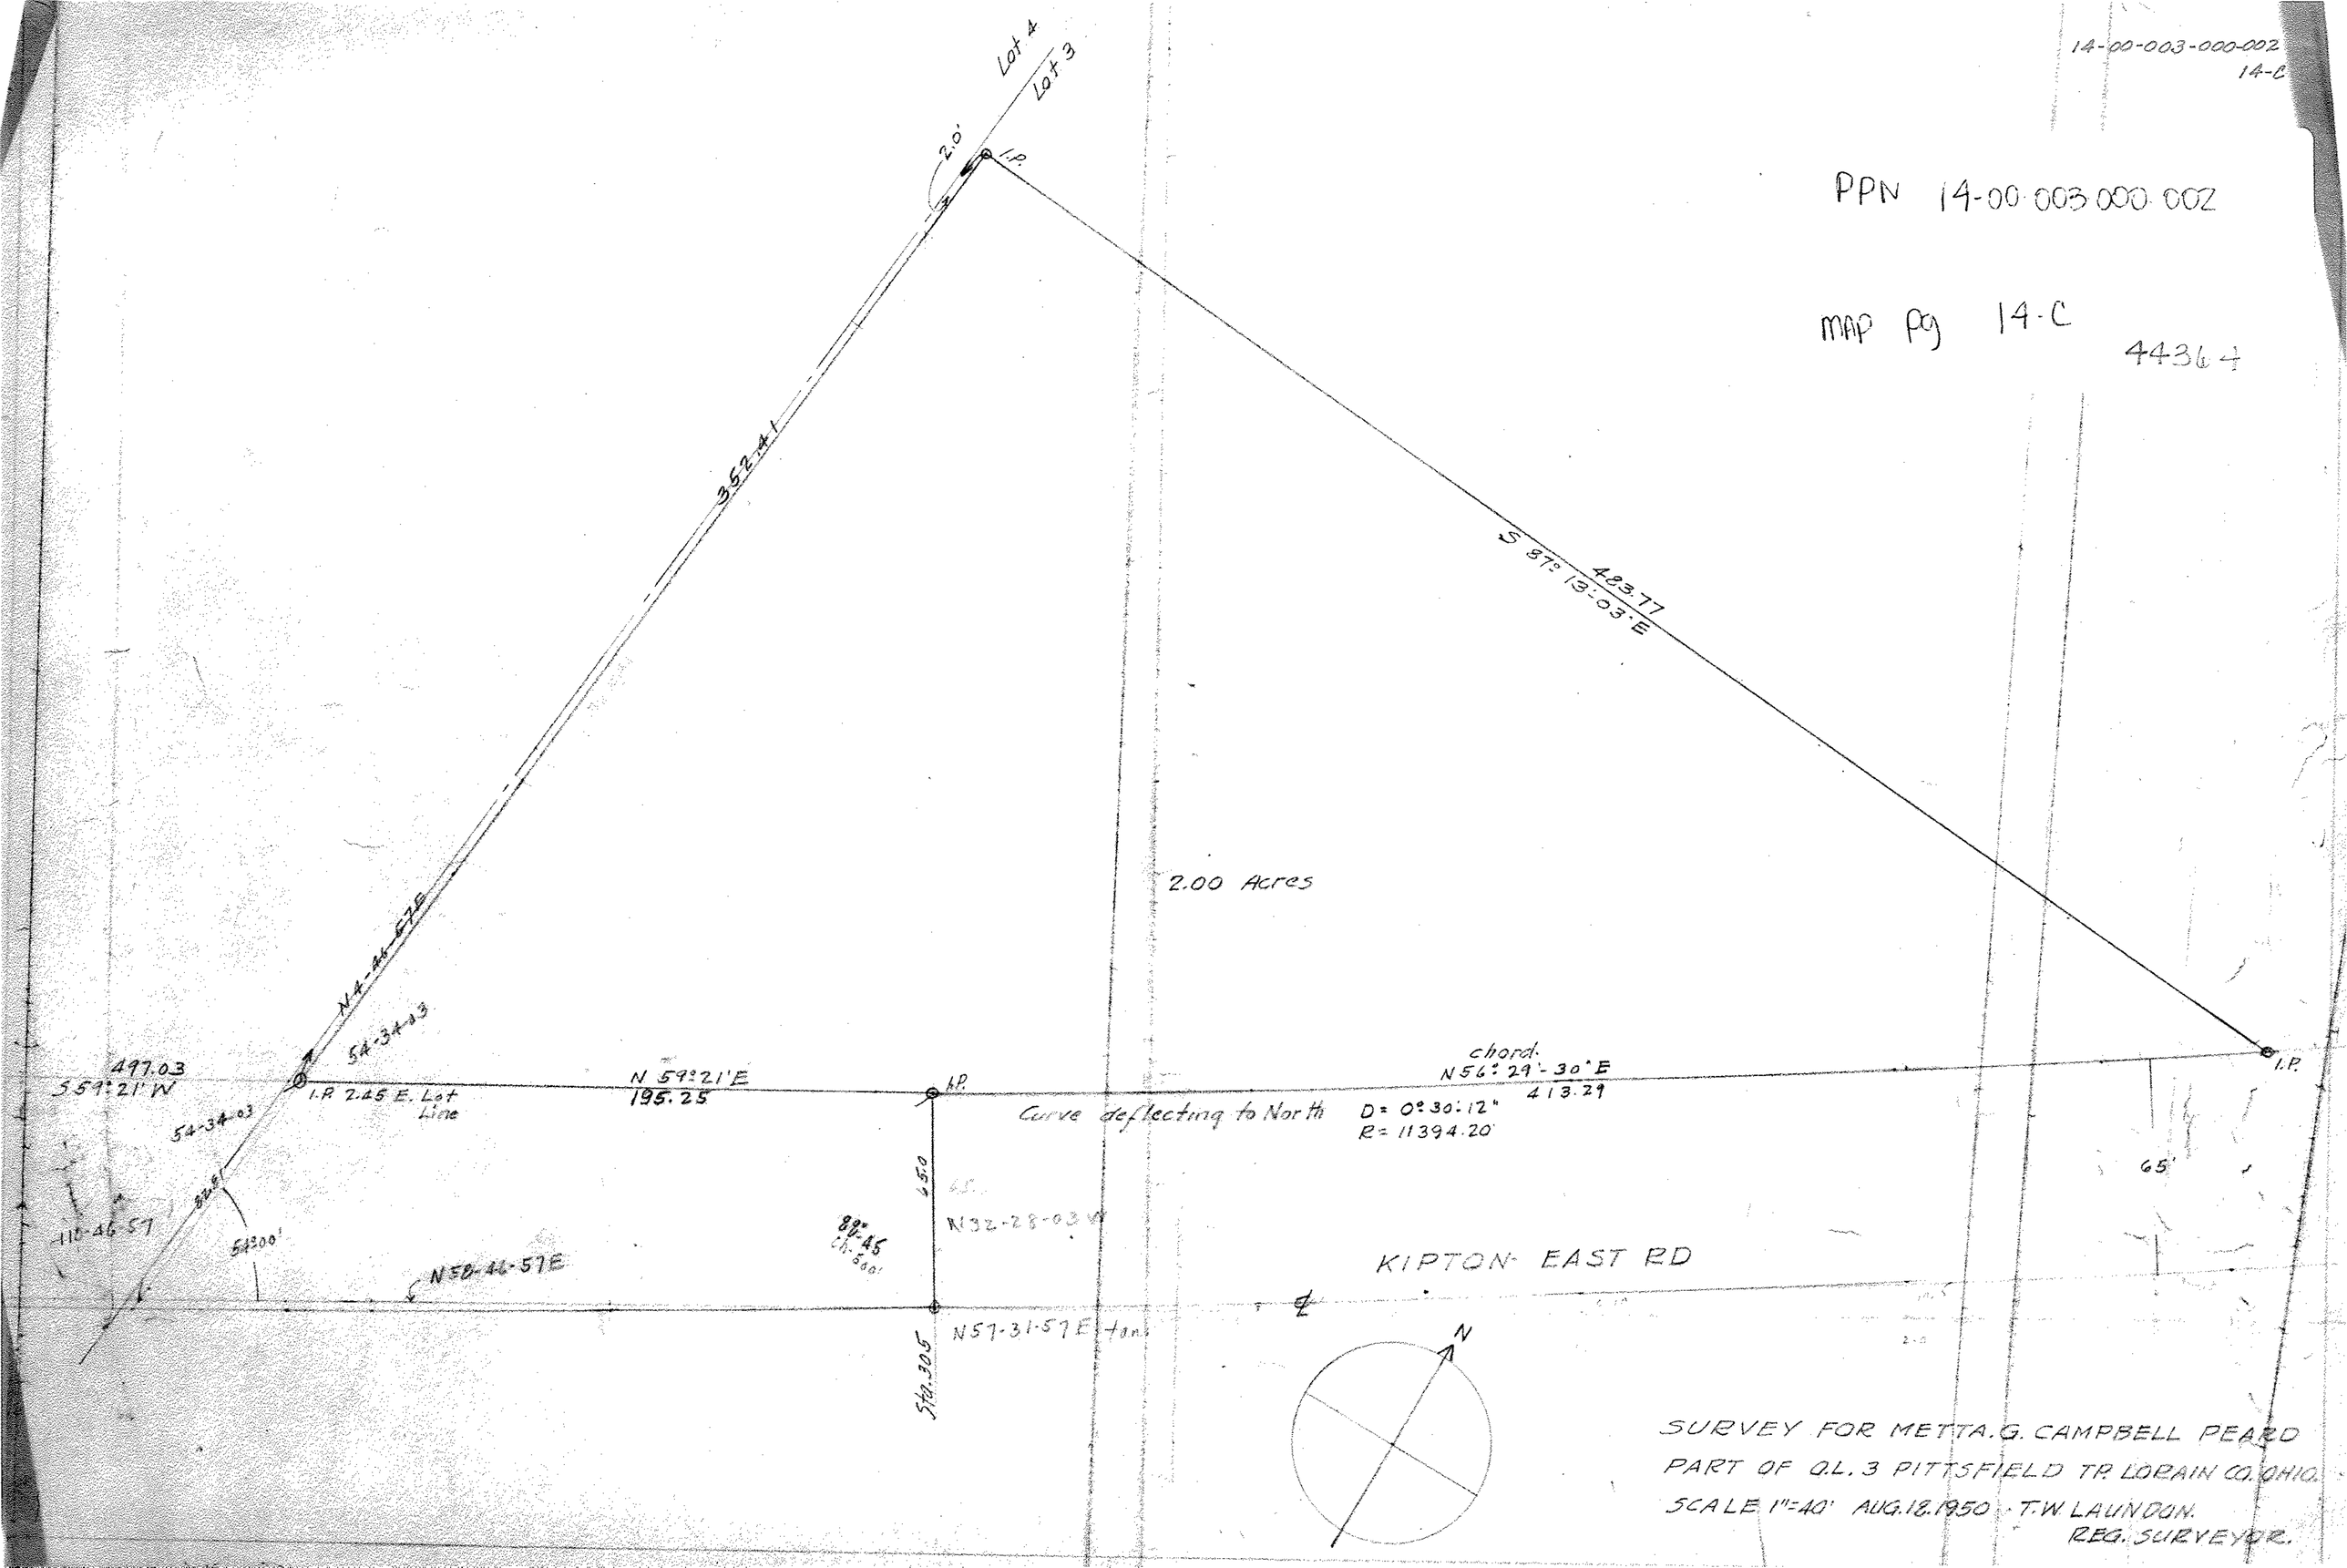

SURVEY FOR METTA. G. CAMPBELL PEARD
PART OF O.L. 3 PITTSFIELD TP. LORAIN CO. OHIO.
SCALE 1"=40' AUG. 18. 1950 T.W. LAUNDON.
REG. SURVEYOR.