PPN 14-00-149-000-004
004

MAP Pg 14-E 44378

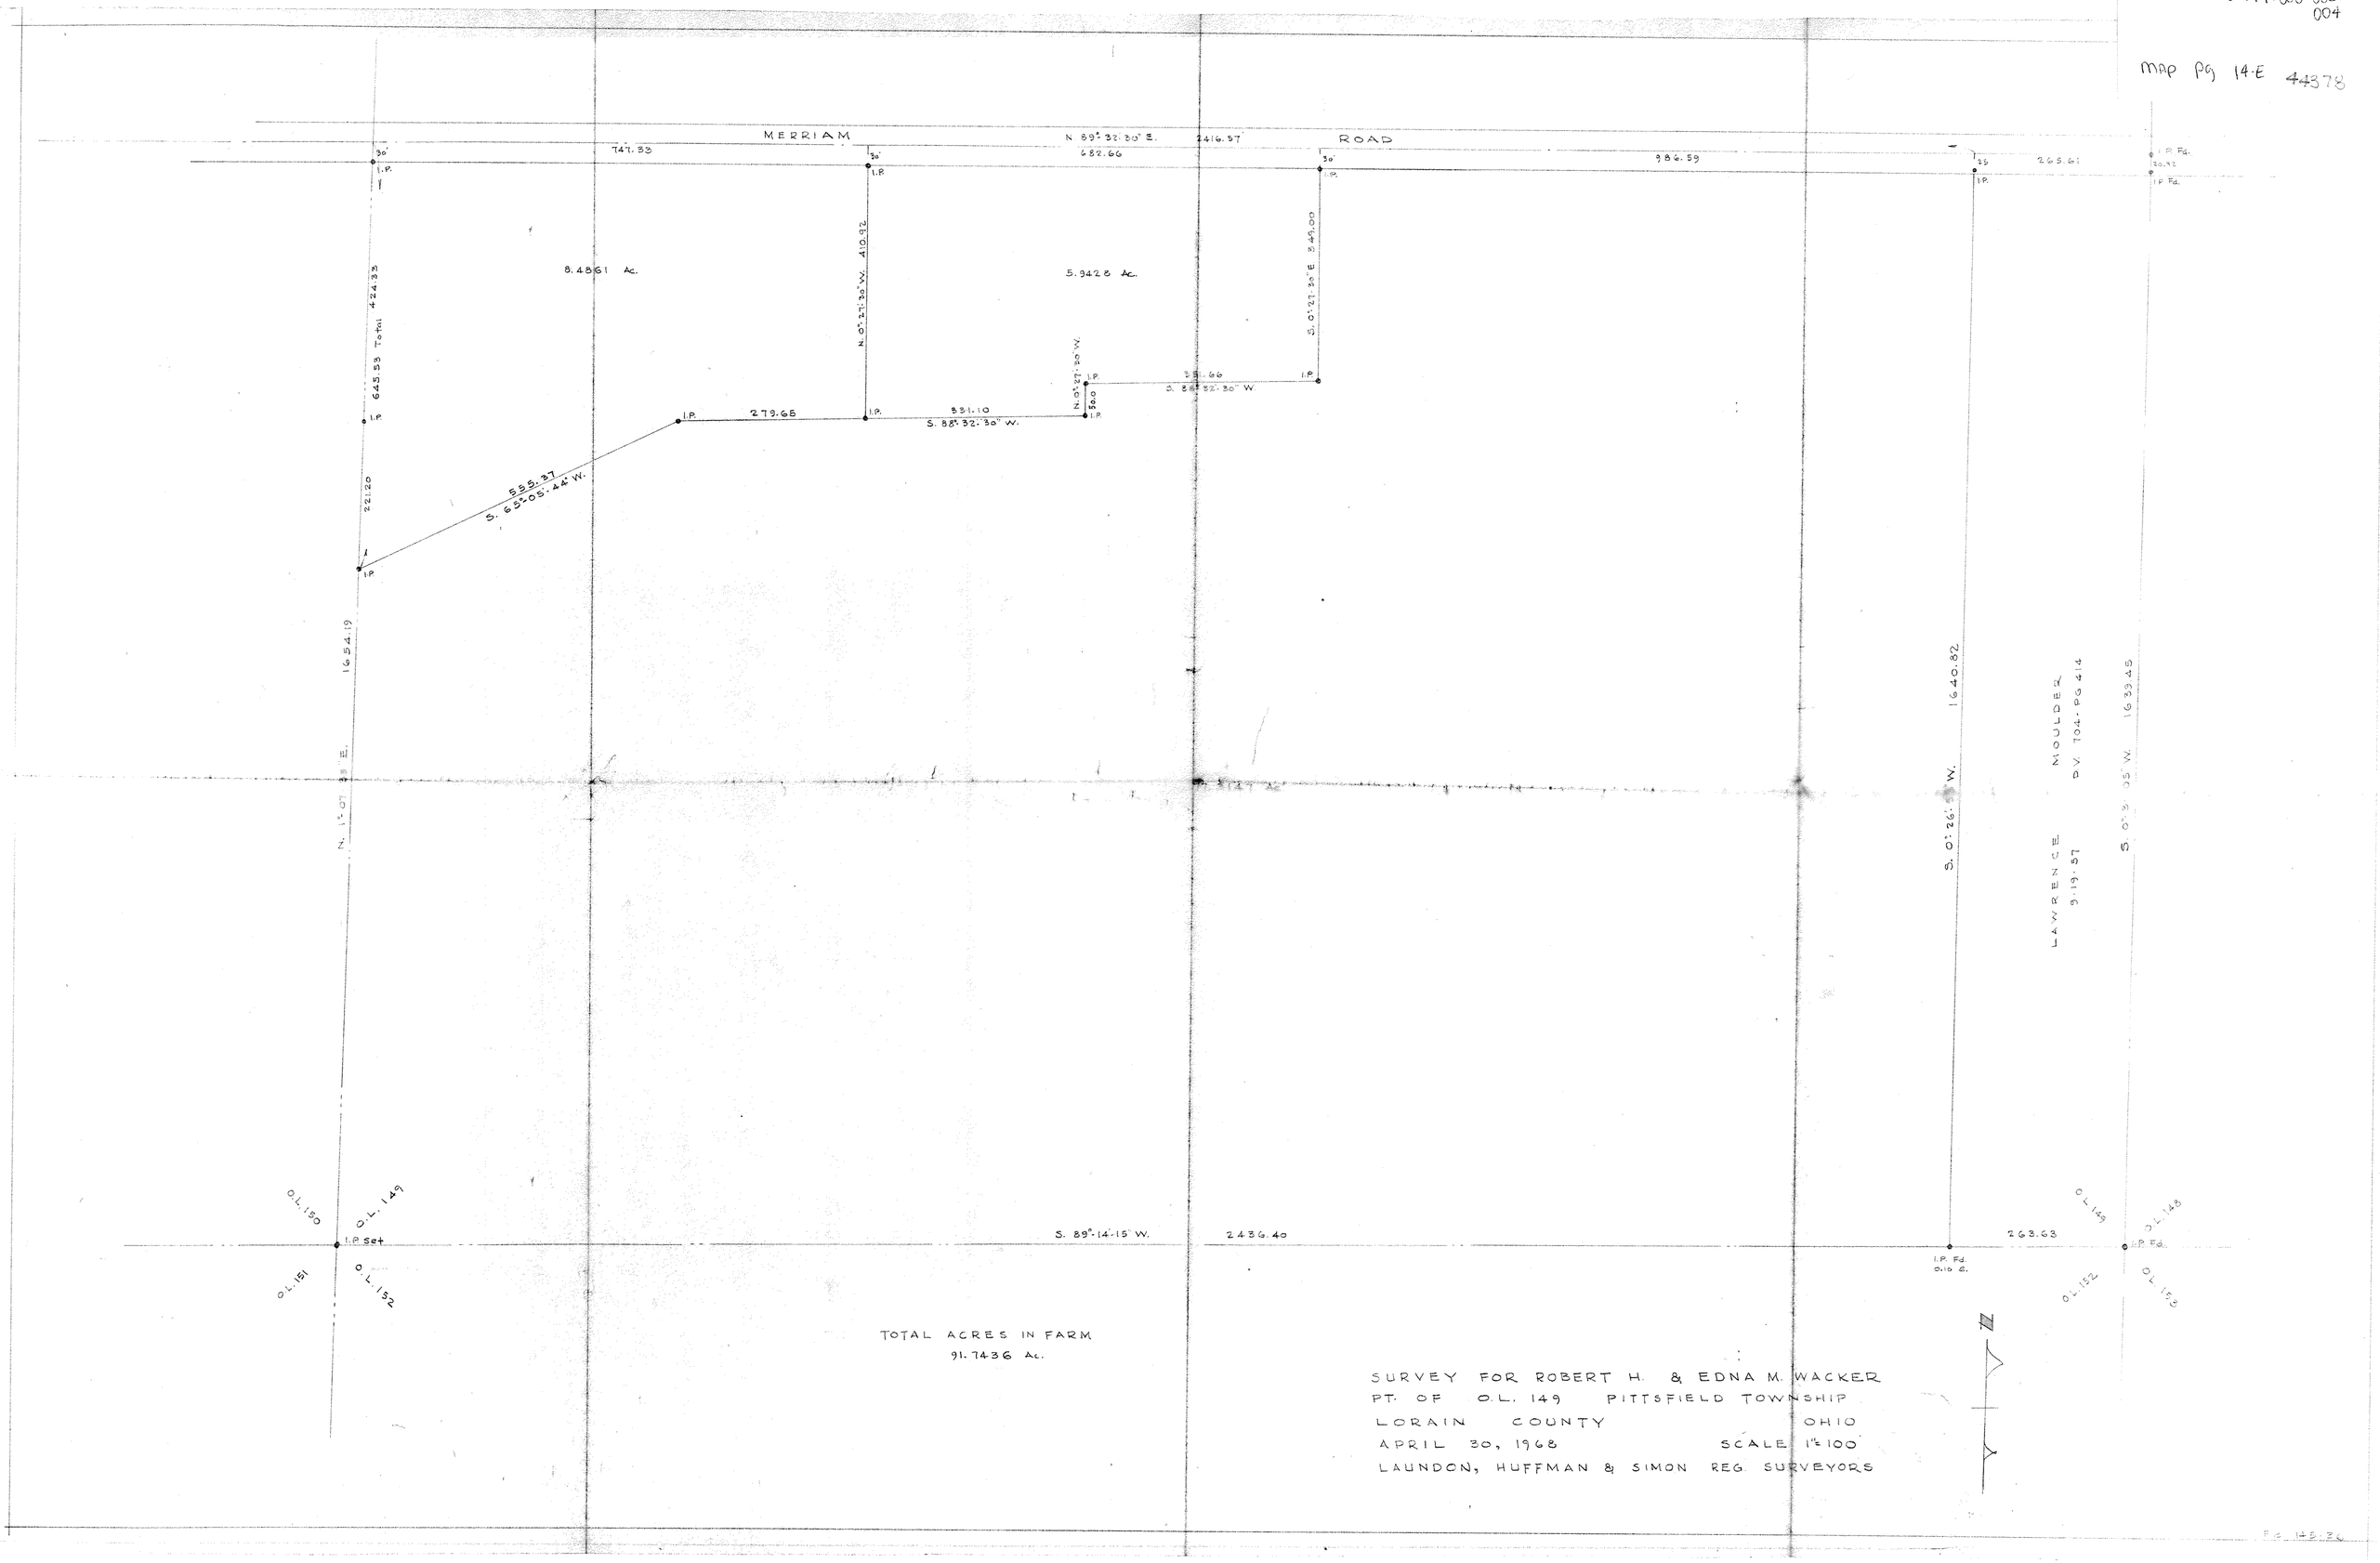

TOTAL ACRES IN FARM
91.7436 Ac.

SURVEY FOR ROBERT H. & EDNA M. WACKER
PT. OF O.L. 149 PITTSFIELD TOWNSHIP
LORAIN COUNTY OHIO
APRIL 30, 1968 SCALE 1" = 100'
LAUNDON, HUFFMAN & SIMON REG. SURVEYORS