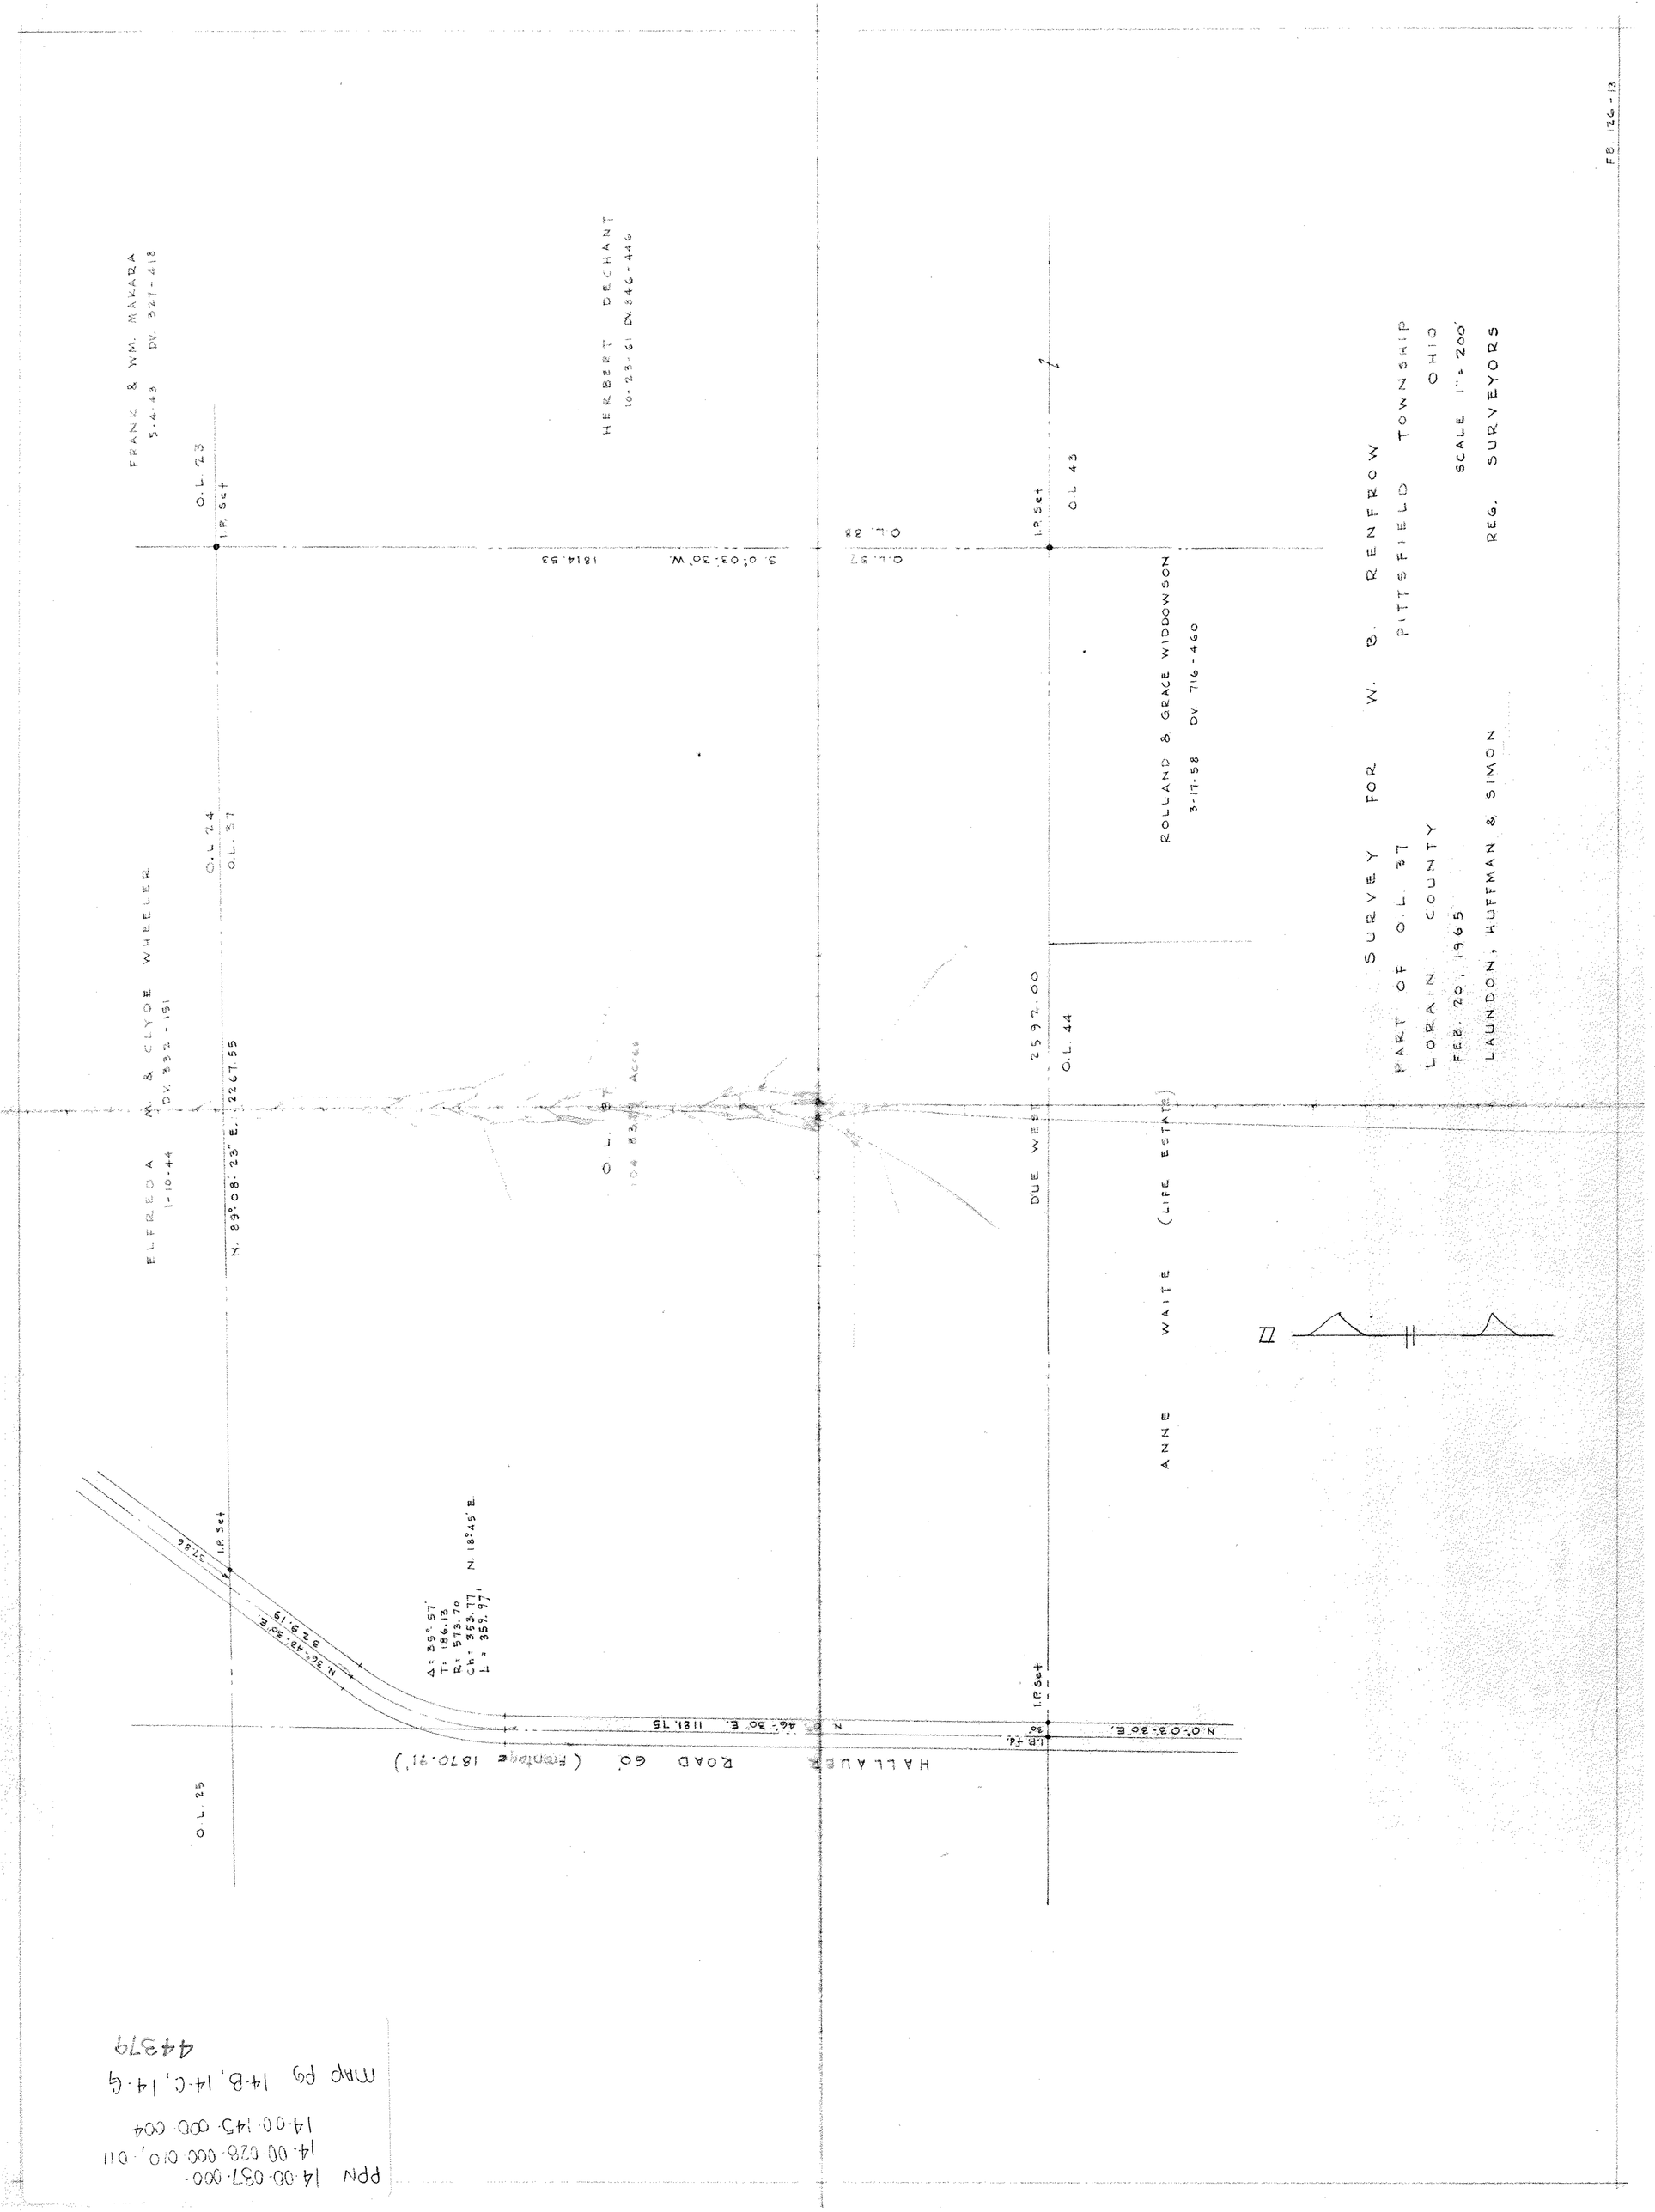

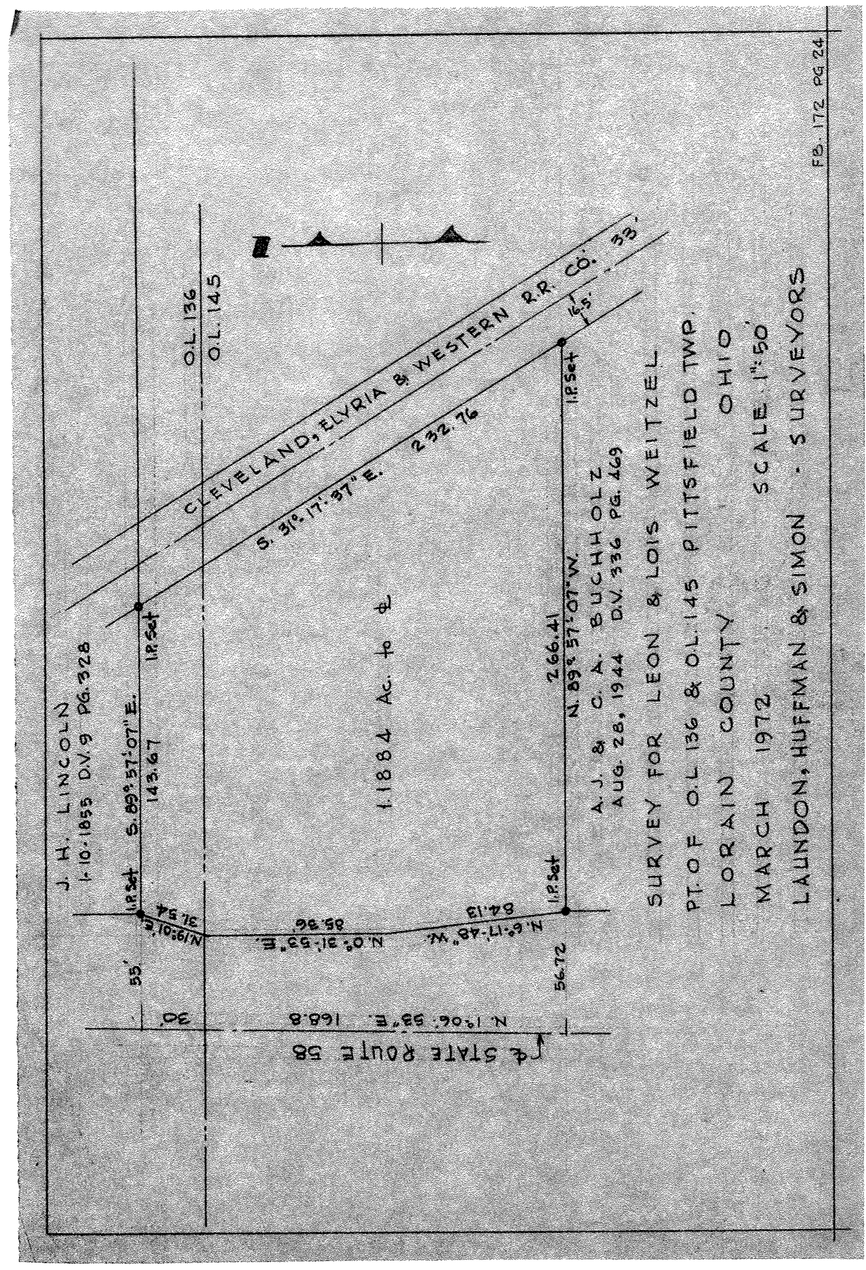

PPN 14-00-037-000-
14-00-028-000 010, 011
14-00-145-000 004

MAP PG 14-B, 14-C, 14-G

44379