16-00-080-000
16-00-087-000
16-00-086-A,B
16-00-087-A

PPN 16-00-080-000-???
16-00-087-000 ???

MAP pg 16-00-086-A,B
16-00-087-A 44393

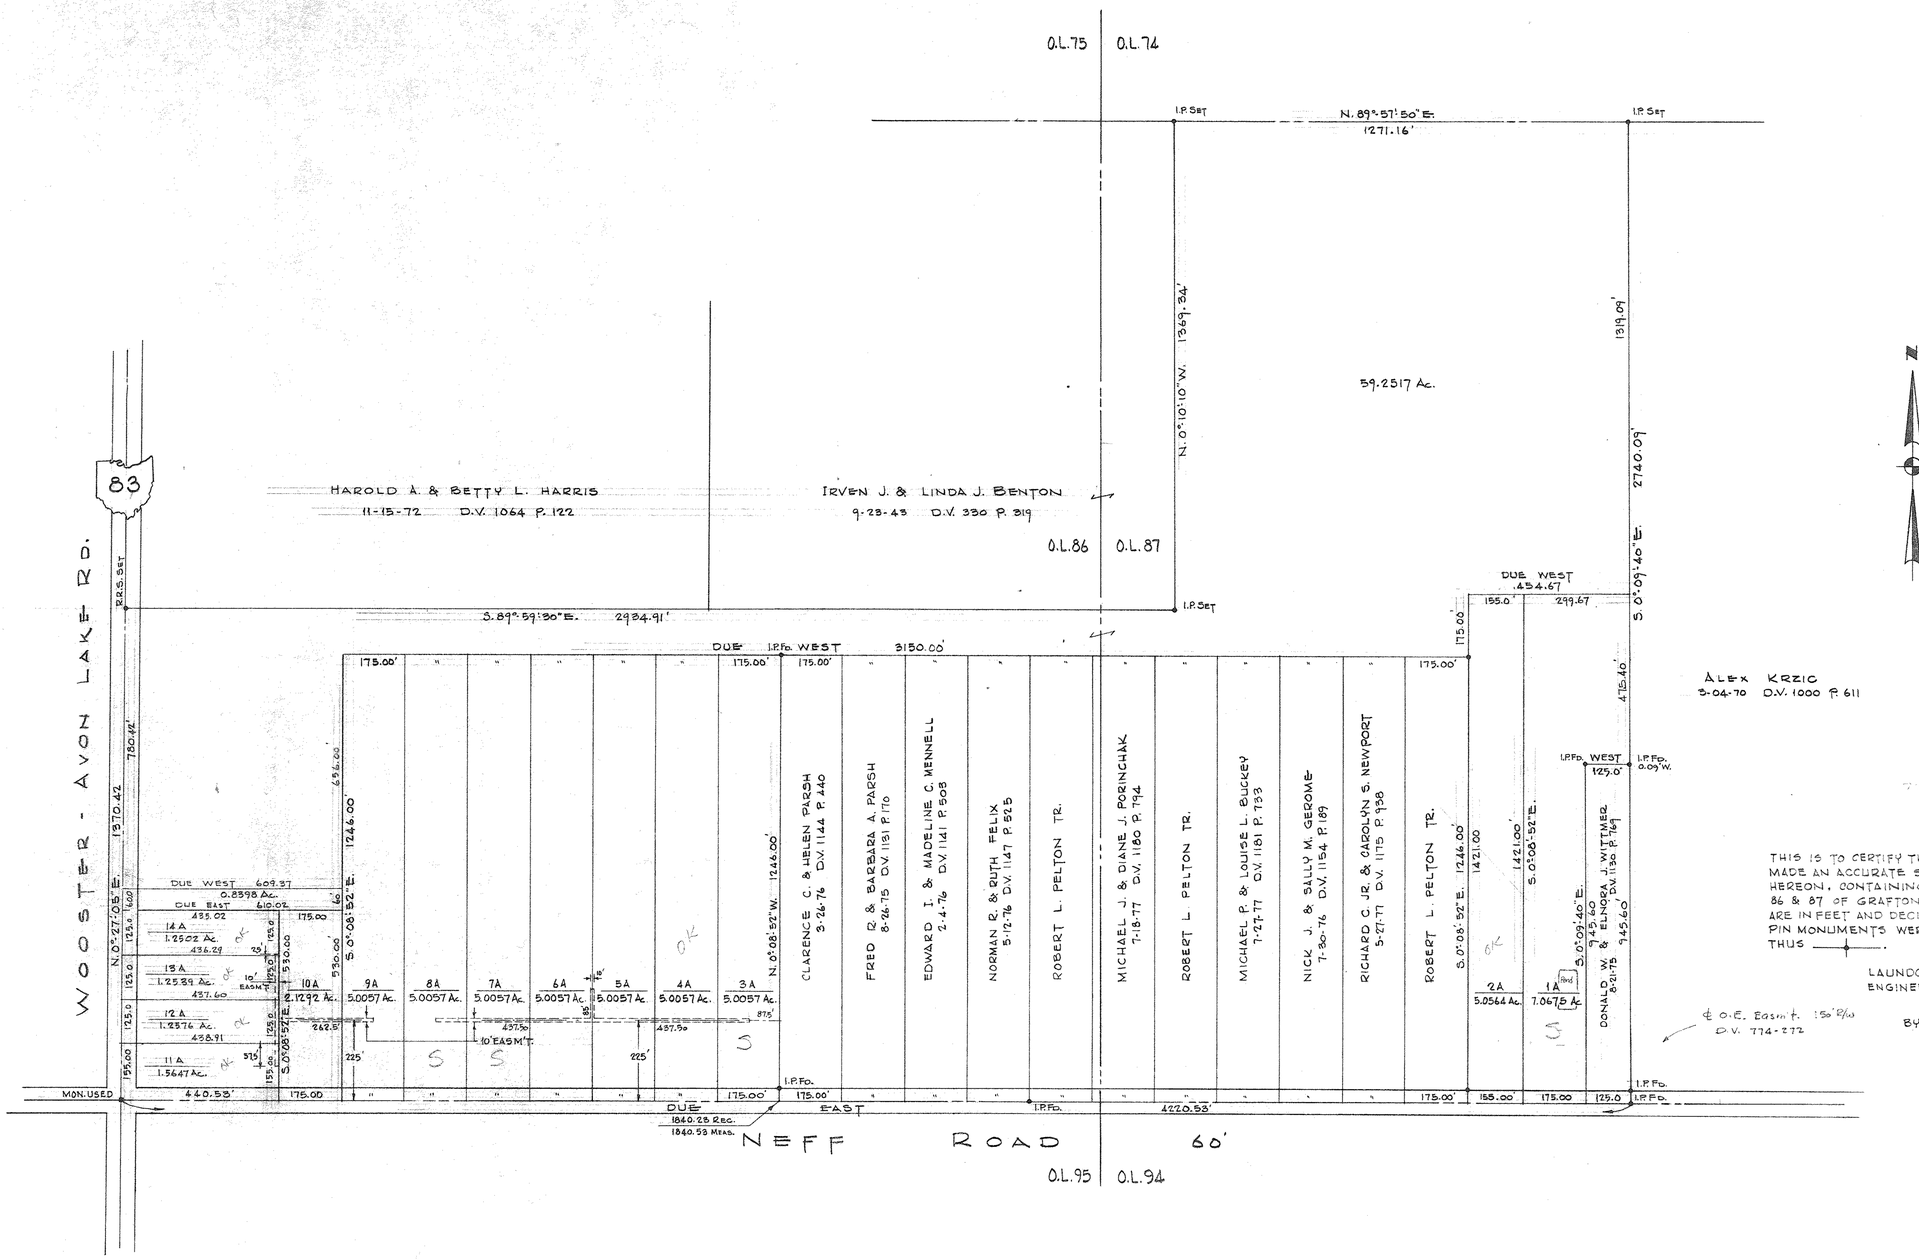

THIS IS TO CERTIFY THAT IN NOVEMBER OF 1977, WE MADE AN ACCURATE SURVEY OF THE LANDS SHOWN HEREON, CONTAINING 114.7109 ACRES IN O.L.'s 86 & 87 OF GRAFTON TOWNSHIP. MEASUREMENTS ARE IN FEET AND DECIMAL PARTS THEREOF. IRON PIN MONUMENTS WERE FOUND OR SET SHOWN THUS ——+——.

LAUNDON · SIMON · CAHL & ASSOC.
ENGINEERS SURVEYORS
BY Rodger Simon
REG. SURVEYOR Nº 5101

ACREAGE BREAKDOWN	
O.L. 86	60.22 Ac.
O.L. 87	54.49 Ac.

SURVEY OF LANDS OF RUTH Y. MOHR ET AL
FOR
BIREX DEVELOPMENT CO. INC.

PART OF O.L.s 86 & 87 — GRAFTON TOWNSHIP
LORAIN COUNTY — OHIO
SCALE 1"=200' — OCTOBER, 1977

LAUNDON · SIMON · CAHL & ASSOC.
ENGINEERS SURVEYORS
JOB No. 77-677 FB. 174-52

Revised 6-16-78 Pels. 10A thru 14A R.G.S.
Revised 12-23-77 Addition of easements R.G.S.
Revised 12-06-77 Pels. 1A & 2A R.G.S.
Revised 11-15-77 Pel. 10A R.G.S.