


P. 130

MAP PG 15-H 44390

PPN 15-00-091-000-727

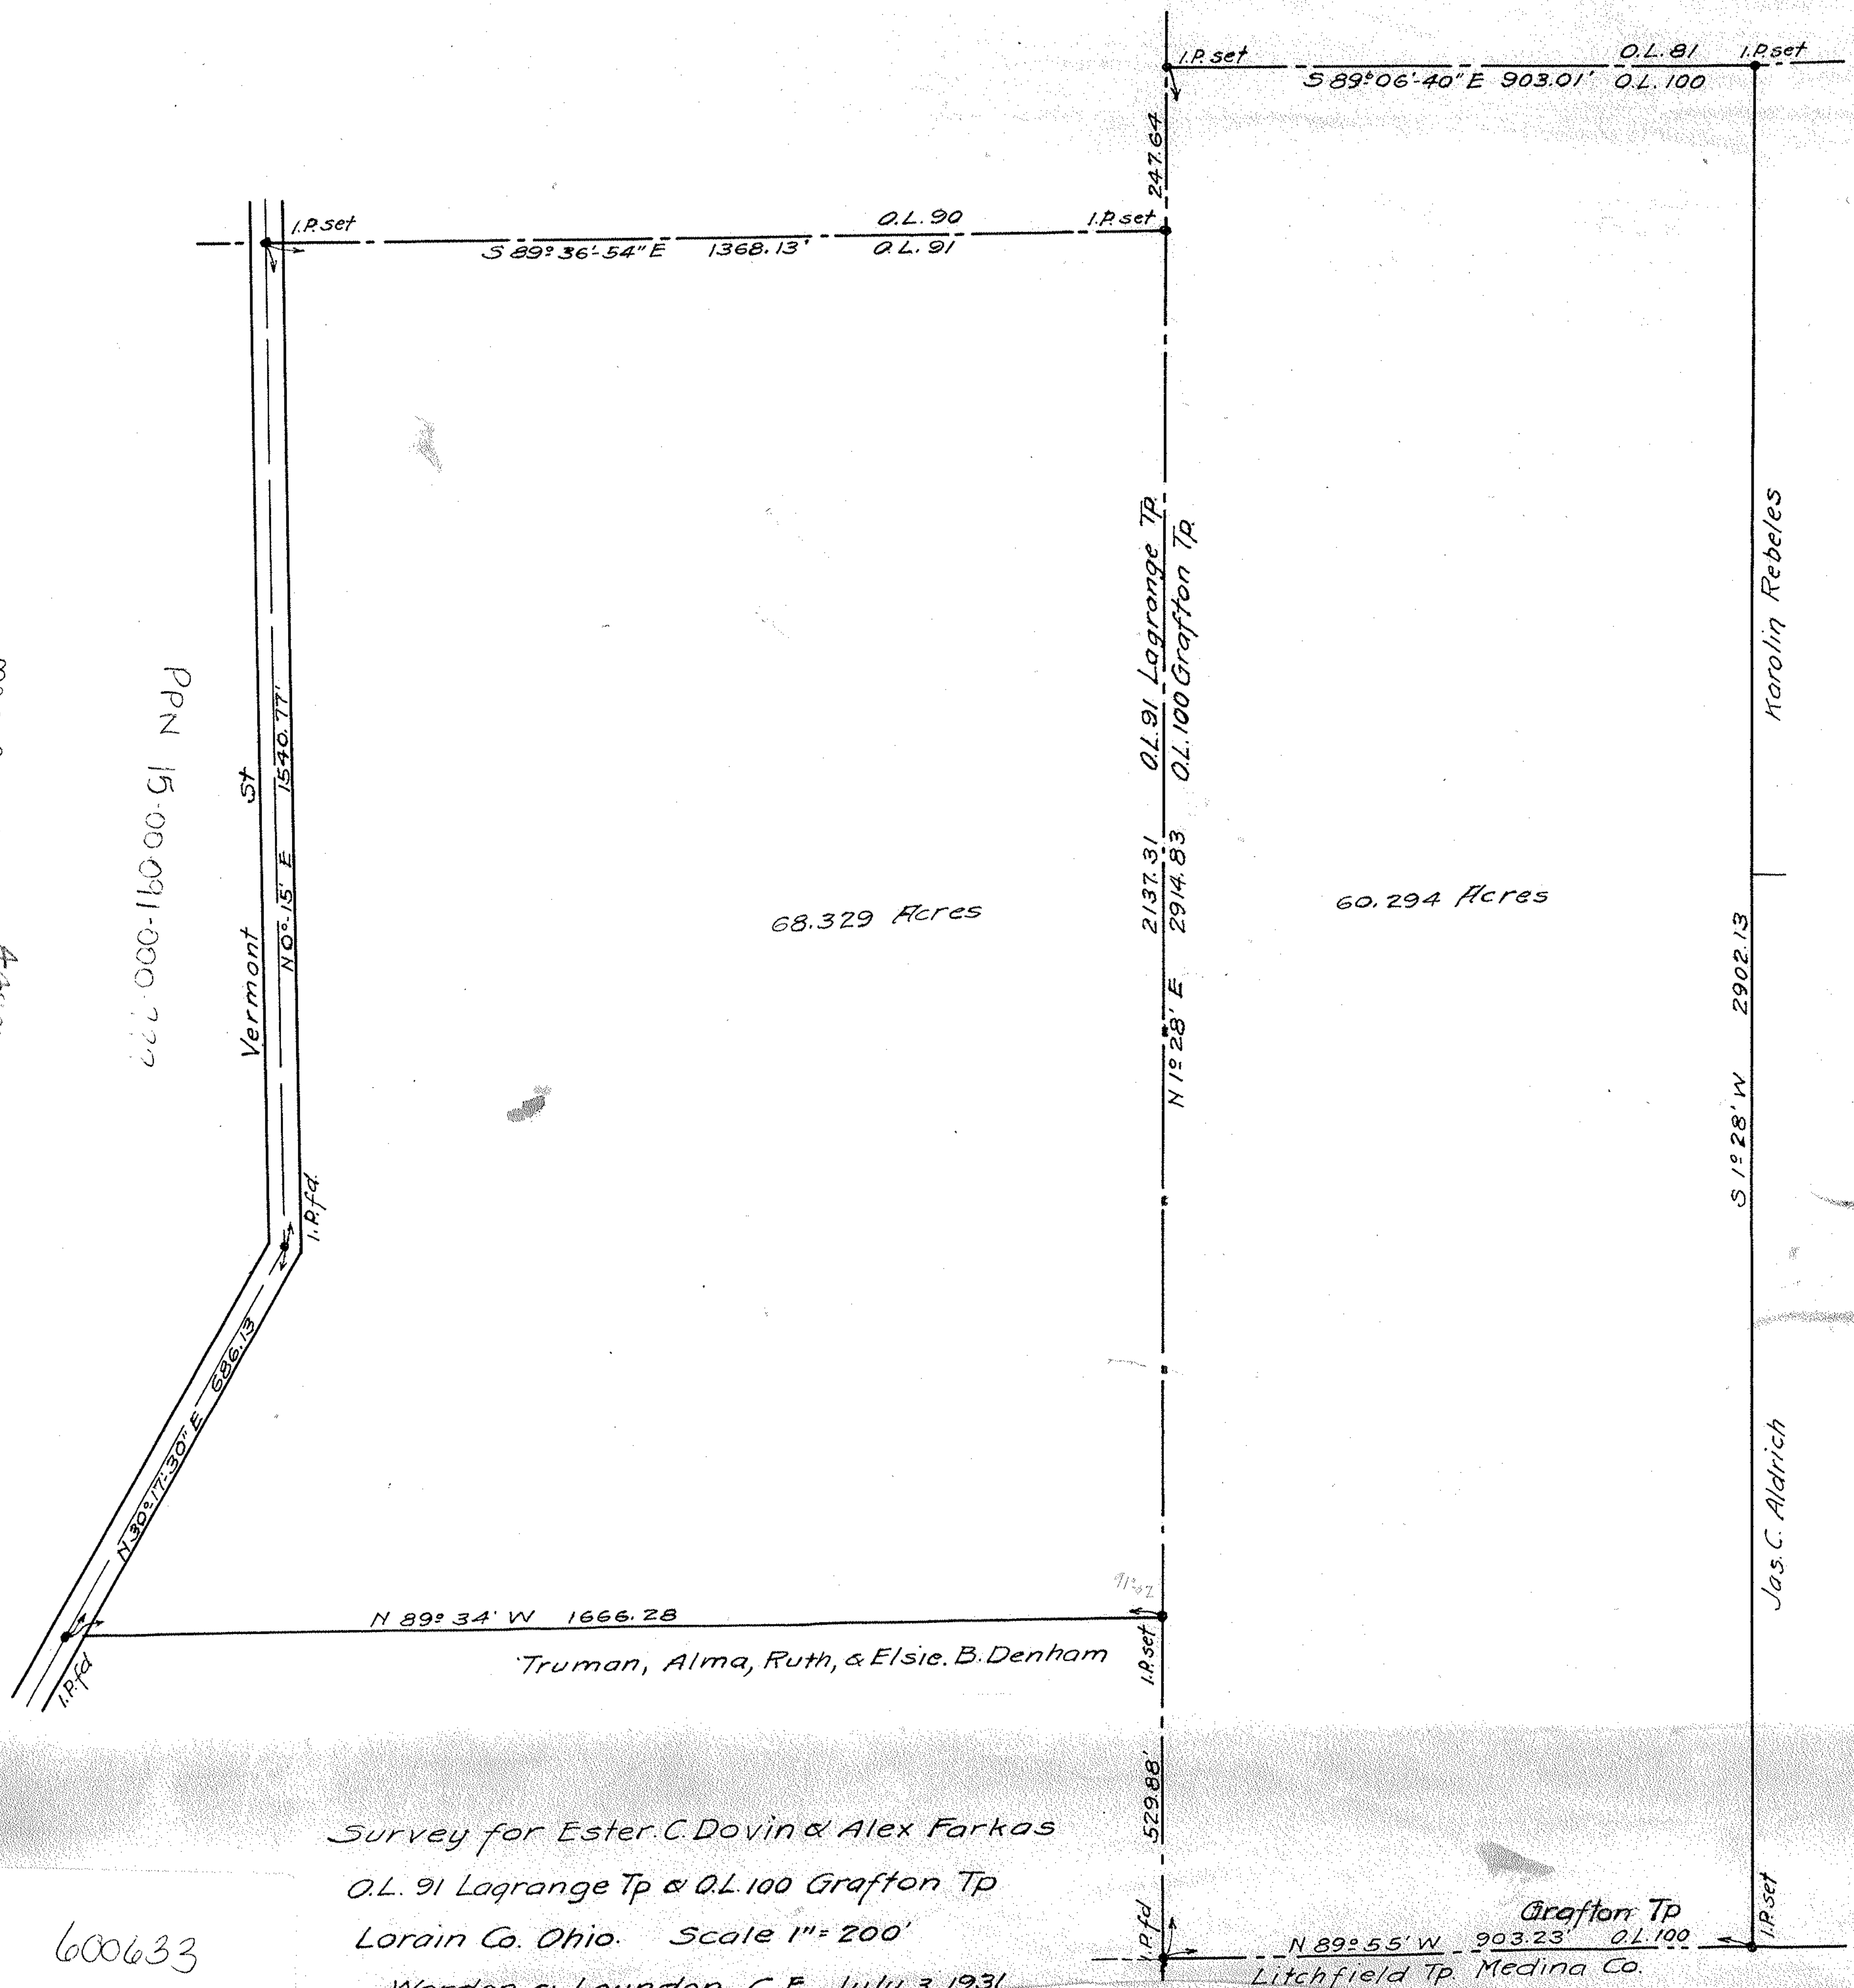

Survey for Ester C. Dovin & Alex Farkas

O.L. 91 Lagrange Tp & O.L. 100 Grafton Tp

Lorain Co. Ohio. Scale 1" = 200'

Warden & Laundon. C. E. July, 3, 1931

600633

Grafton Tp
Litchfield Tp Medina Co.