


P-28d

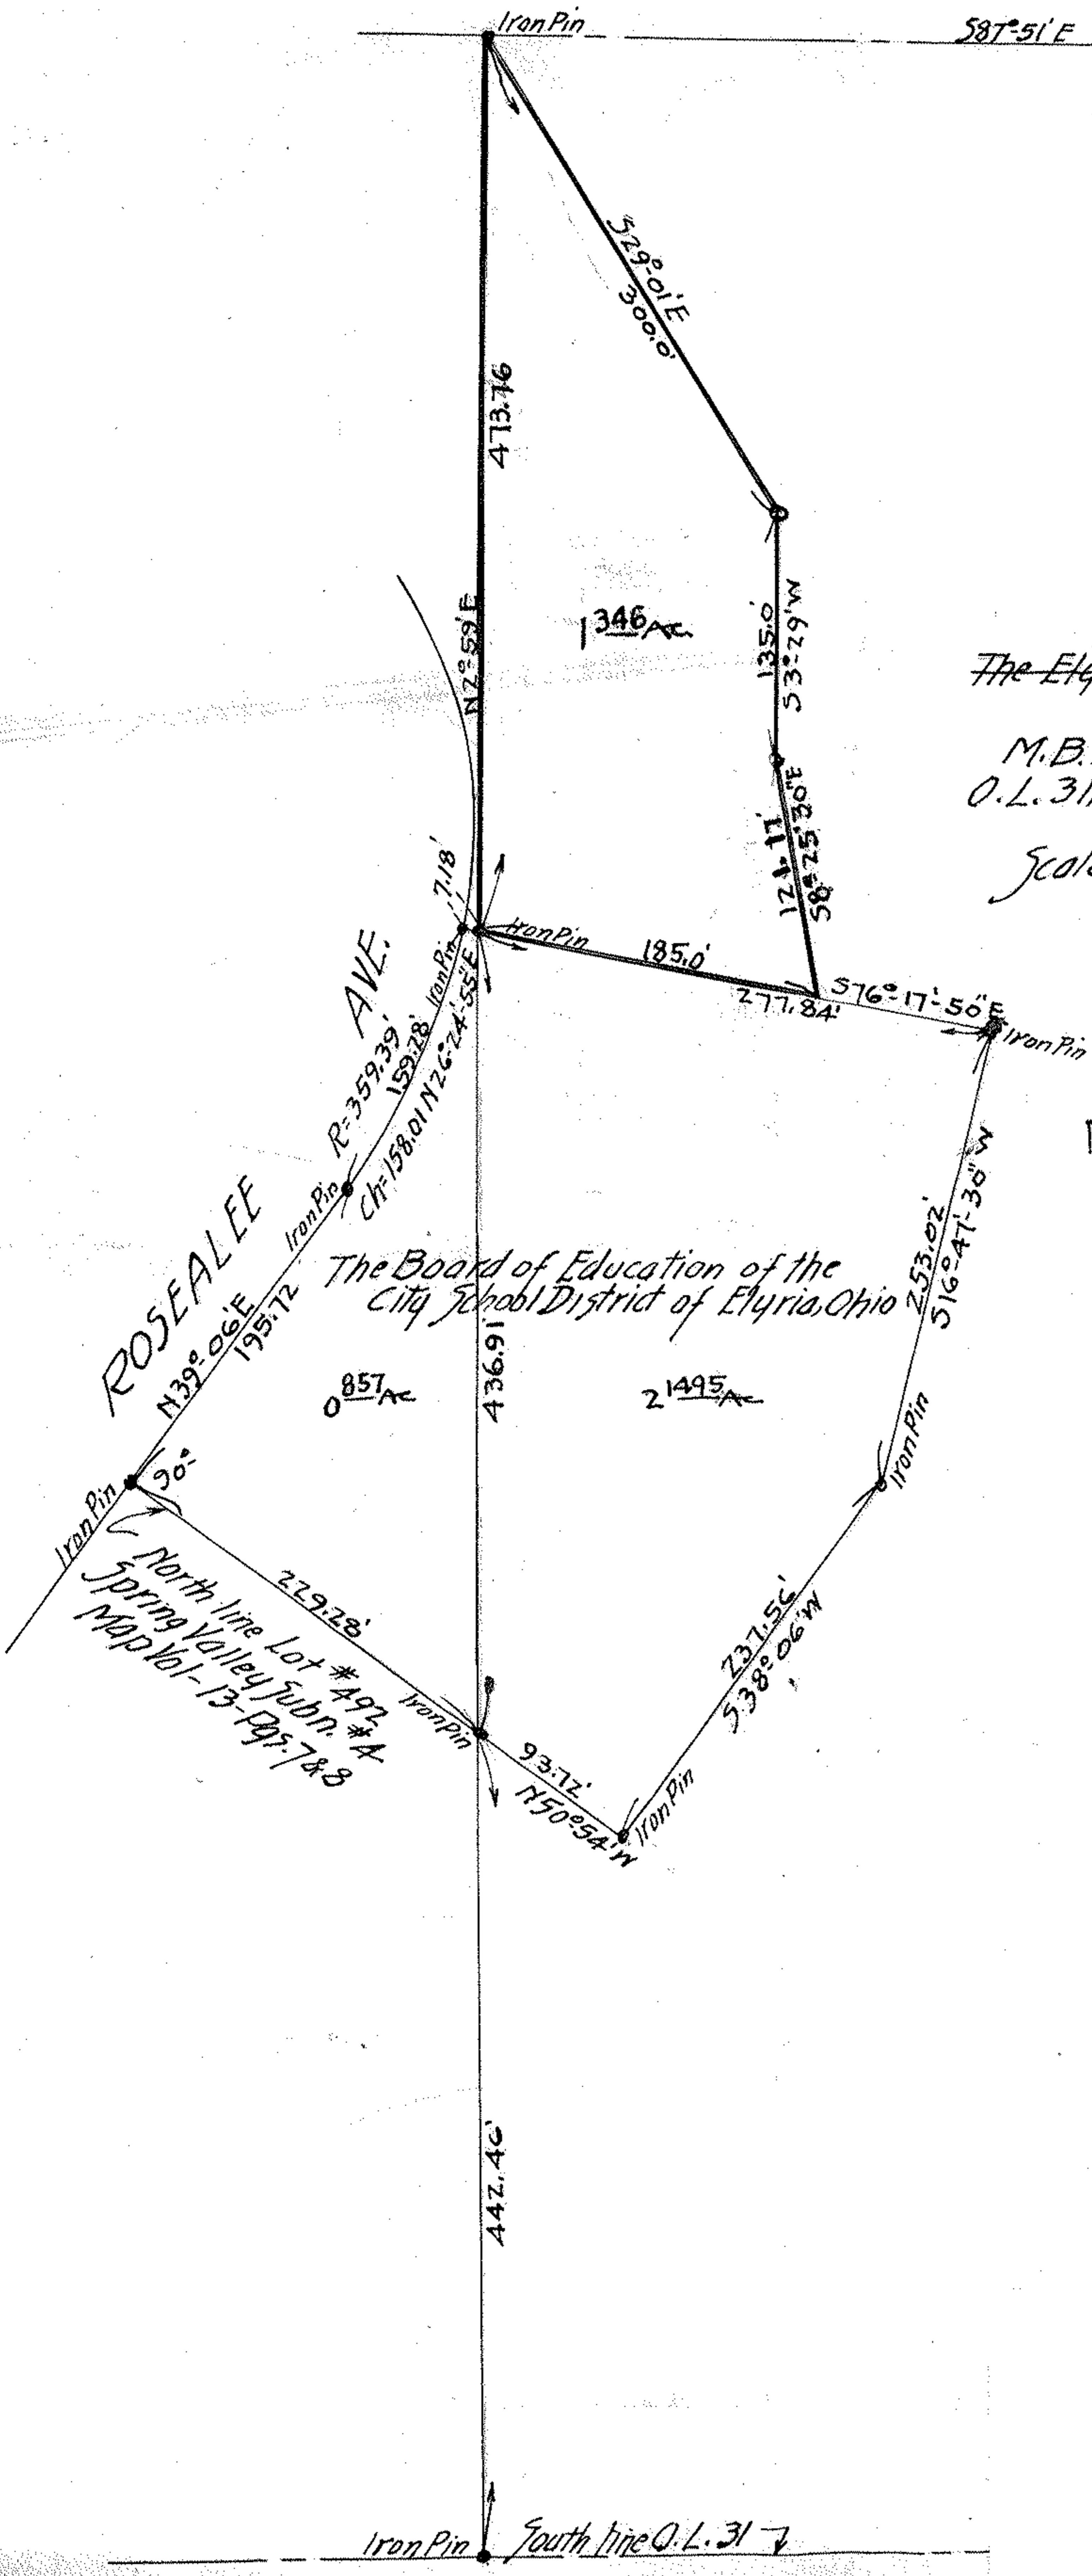

Land to be deeded by The Homeland Co.,
 The Elyria Savings & Trust Company
 to
 M.B. Vilas & Leonard Brooker.
 O.L. 31, East of Black River, Elyria, Twp.,
 Lorain Co., Ohio.
 Scale 1 inch = 100 ft. Jan. 30, 1931.
 Warden & Laundon,
 Civil Engineers.
 Revised April 20, 1931.



map pg 6-70 44407

PPN 06-25-031-114-222