SURVEY FOR
JAMES S. AND MARIAN PADLEY
SUB LOTS 3-4-5 BLOCK 3
BARBARA A. PADLEY
SUB LOTS 9-10-11-32-33 BLOCK 3
RIDGEVILL HEIGHTS ALLOT NO. 2
O. L. 9 RIDGEVILLE TOWNSHIP
N. RIDGEVILLE CITY LORAIN CO. OHIO
SCALE 1" = 20' OCT 26, 1965
D. D. ANDRUS AND ASSOCIATES REG SURVEYORS

Iron stakes set at all points indicated thus •

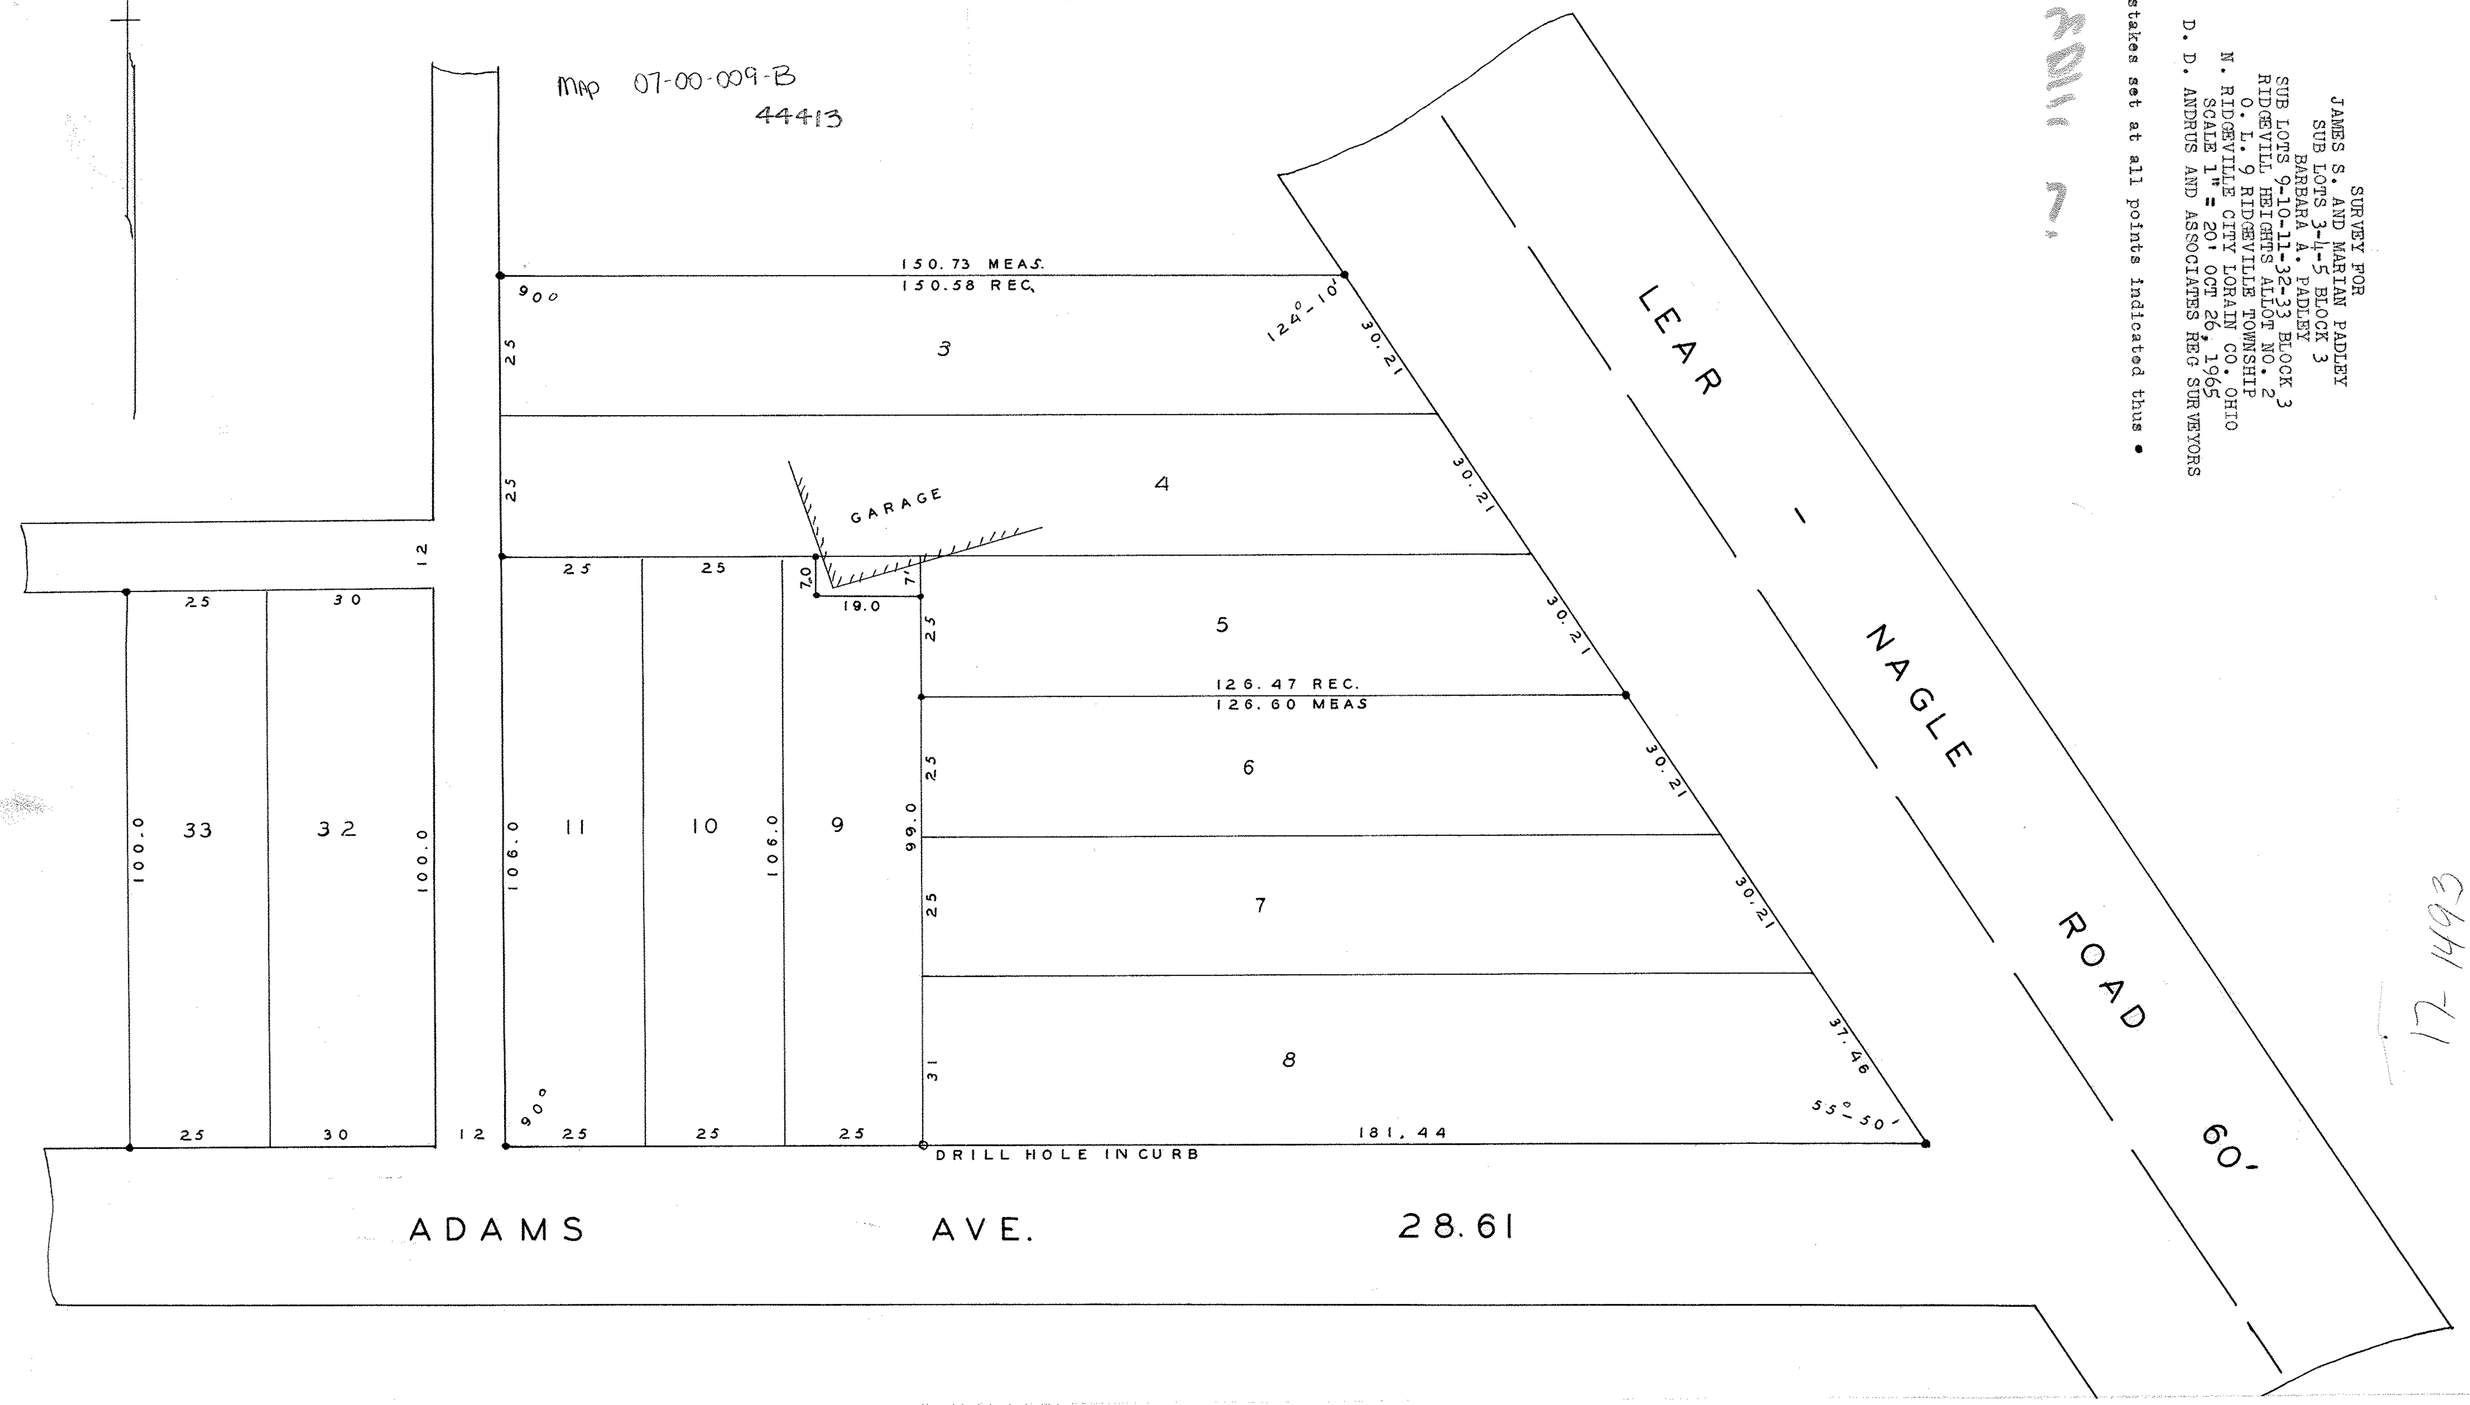
MAP 07-00-009-B
44413