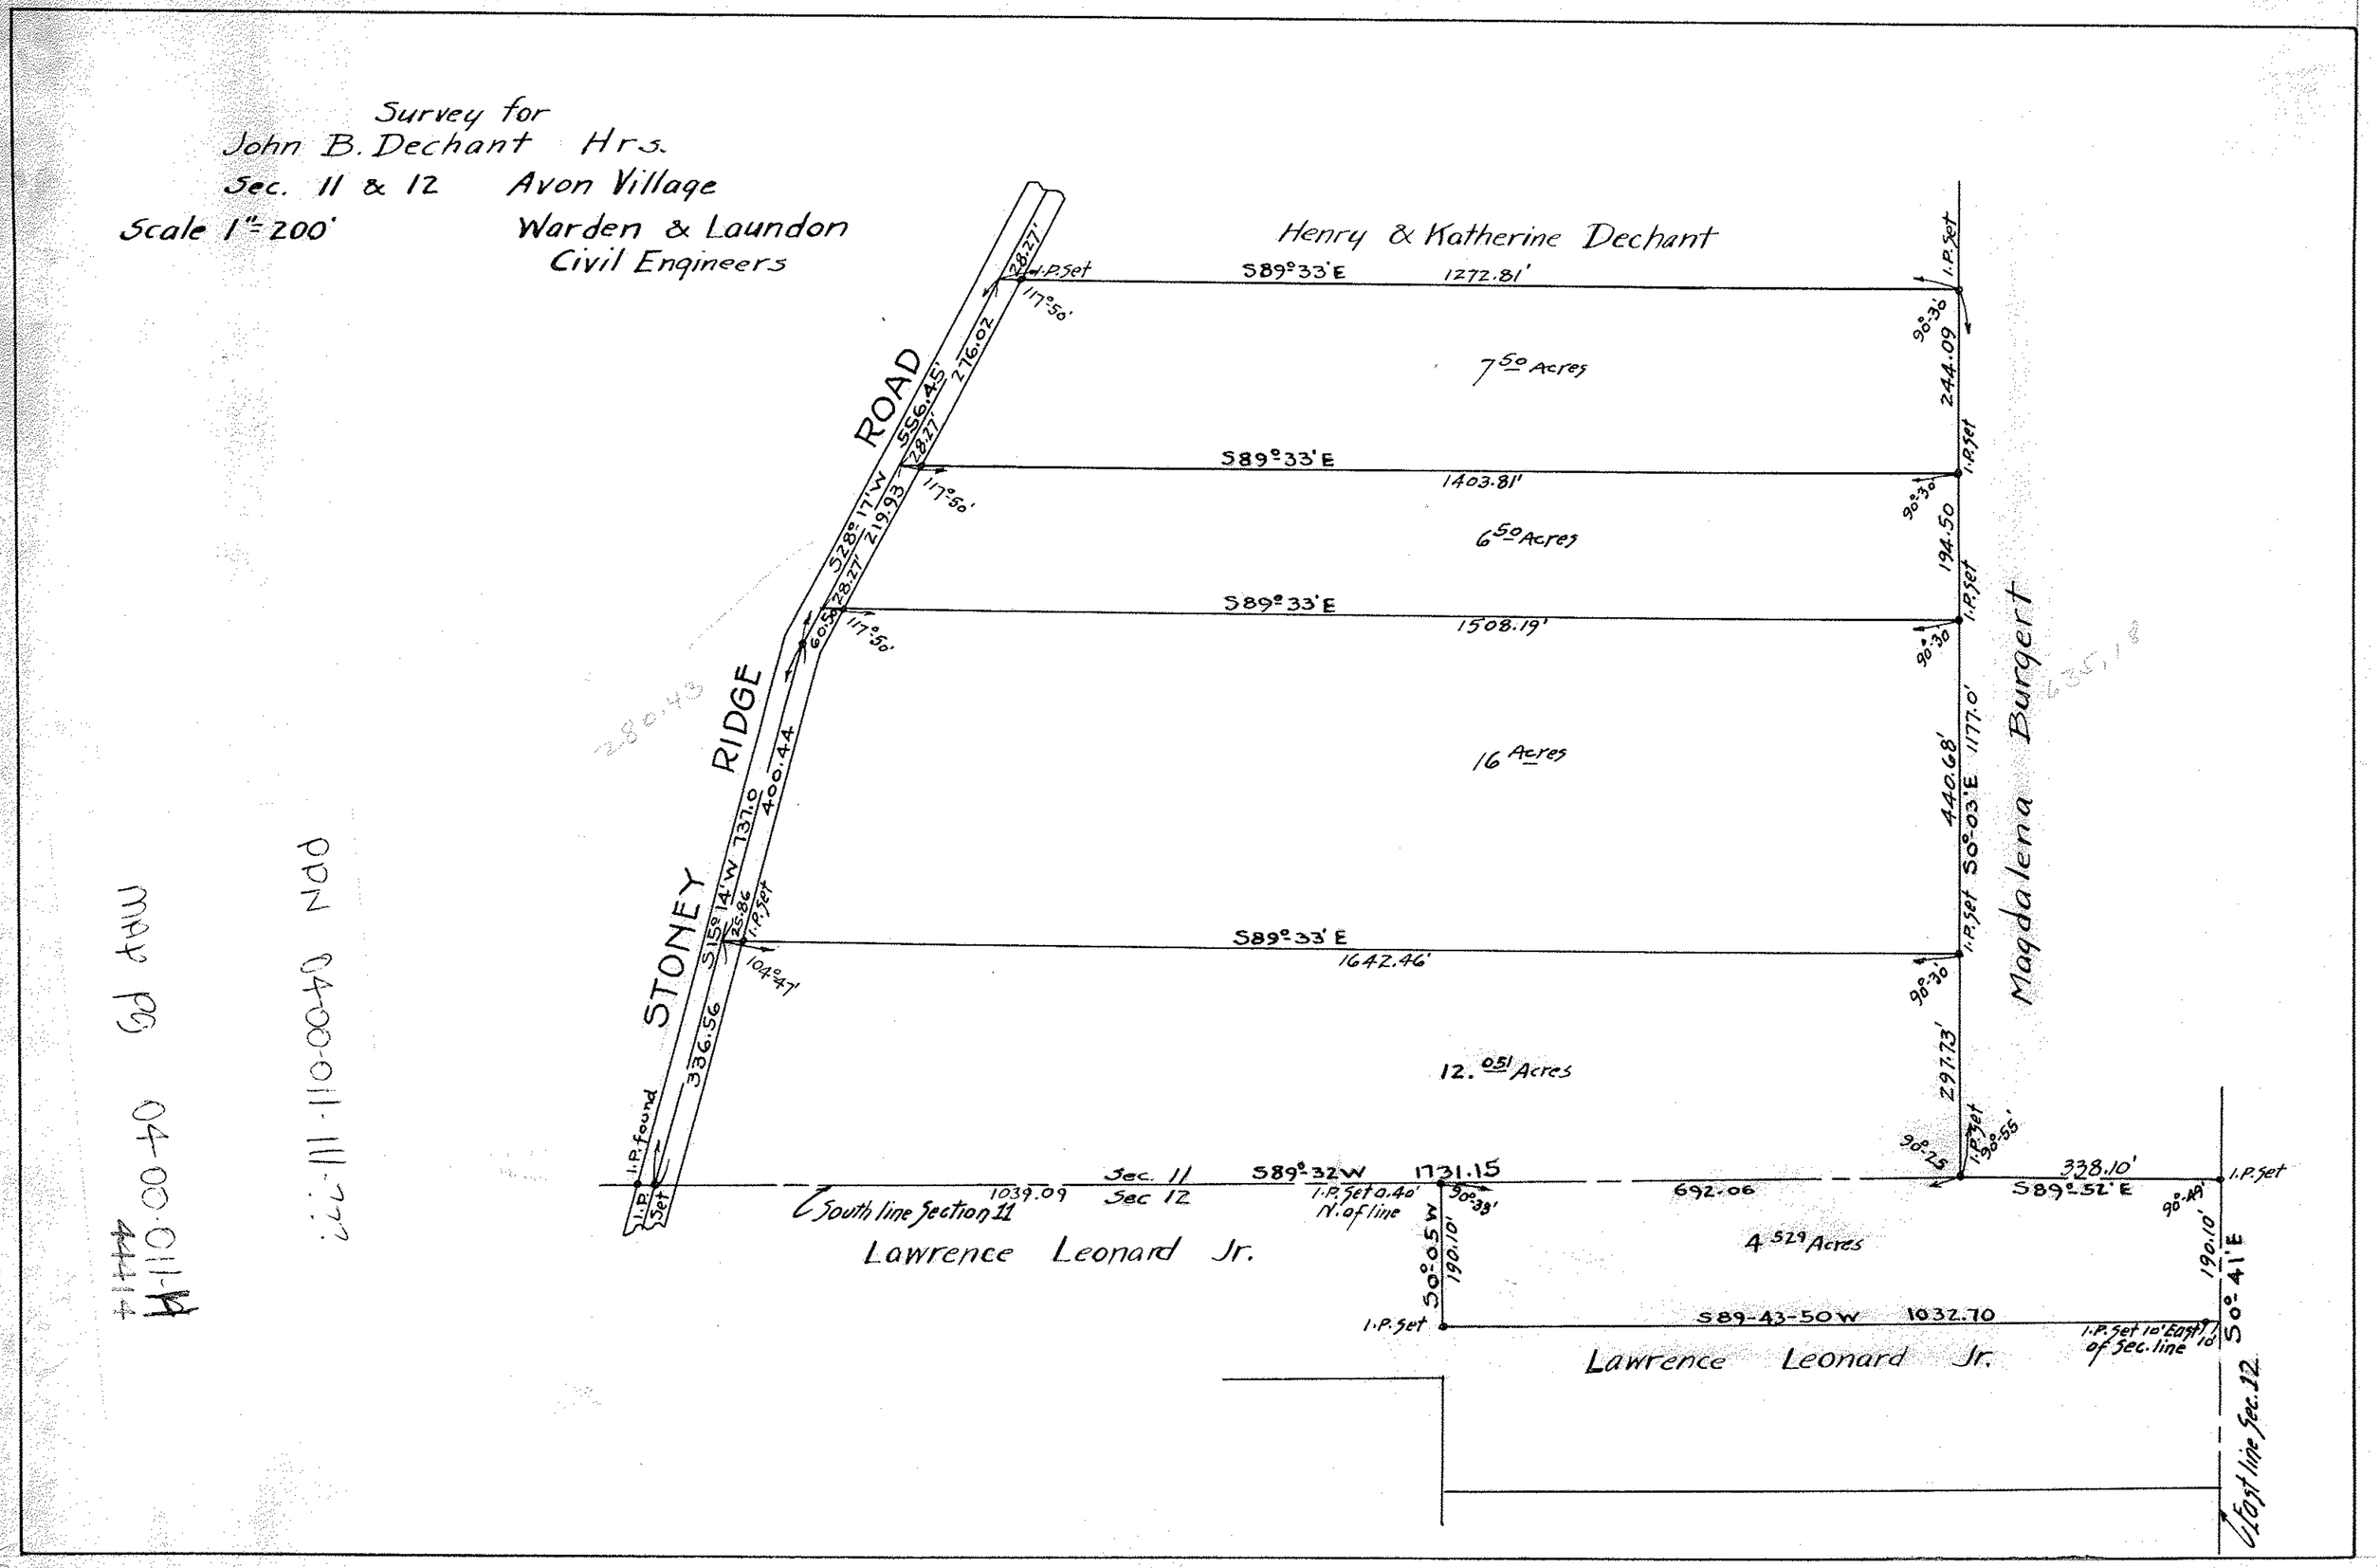
Survey for
John B. Dechant Hrs.
Sec. 11 & 12 Avon Village
Scale 1" = 200'
Warden & Laundon
Civil Engineers
Henry & Katherine Dechant
STONEY RIDGE ROAD
S89°33'E 1272.81'
7.50 Acres
S89°33'E 1403.81'
6.50 Acres
S89°33'E 1508.19'
16 Acres
S89°33'E 1642.46'
12.051 Acres
Magdalena Burgert
S89°32W 1731.15
Sec. 11
Sec 12
South line Section 11
Lawrence Leonard Jr.
4.529 Acres
S89-43-50W 1032.70
Lawrence Leonard Jr.
S89°52'E 338.10'
S0°41'E
East line Sec. 12
I.P. Set
I.P. found
S28°17'W 219.93
S15°14'W 737.0
S0°03'E 1177.0'
S0°05'W 190.10'
S0°41'E 190.10'
244.09
194.50
440.68'
297.73'
692.06
1039.09
1.P. Set 0.40' N. of line
I.P. Set 10' East of Sec. line
280.43
635.18
PPN 0400-011-111-???
MAP PG 0400-011-H
44414