Survey for
ARTEMUS WARD RHODEHAMEL and
ARTHUR OTTO RHODEHAMEL
D-Vol. 416 Page 545 July 5. 1947.
Lots 42-43 Bronsons Addition
Map. Vol. 2 Page 15
OL 85 West of Black River Elyria Twp.
Elyria City Lorain County Ohio.
Scale 1" = 30' Oct. 29. 1951.
J. W. Warden, and Associates Surveyor's.

PPN 06-24-085-102 ???

MAP PG 6-98 44422

17-878

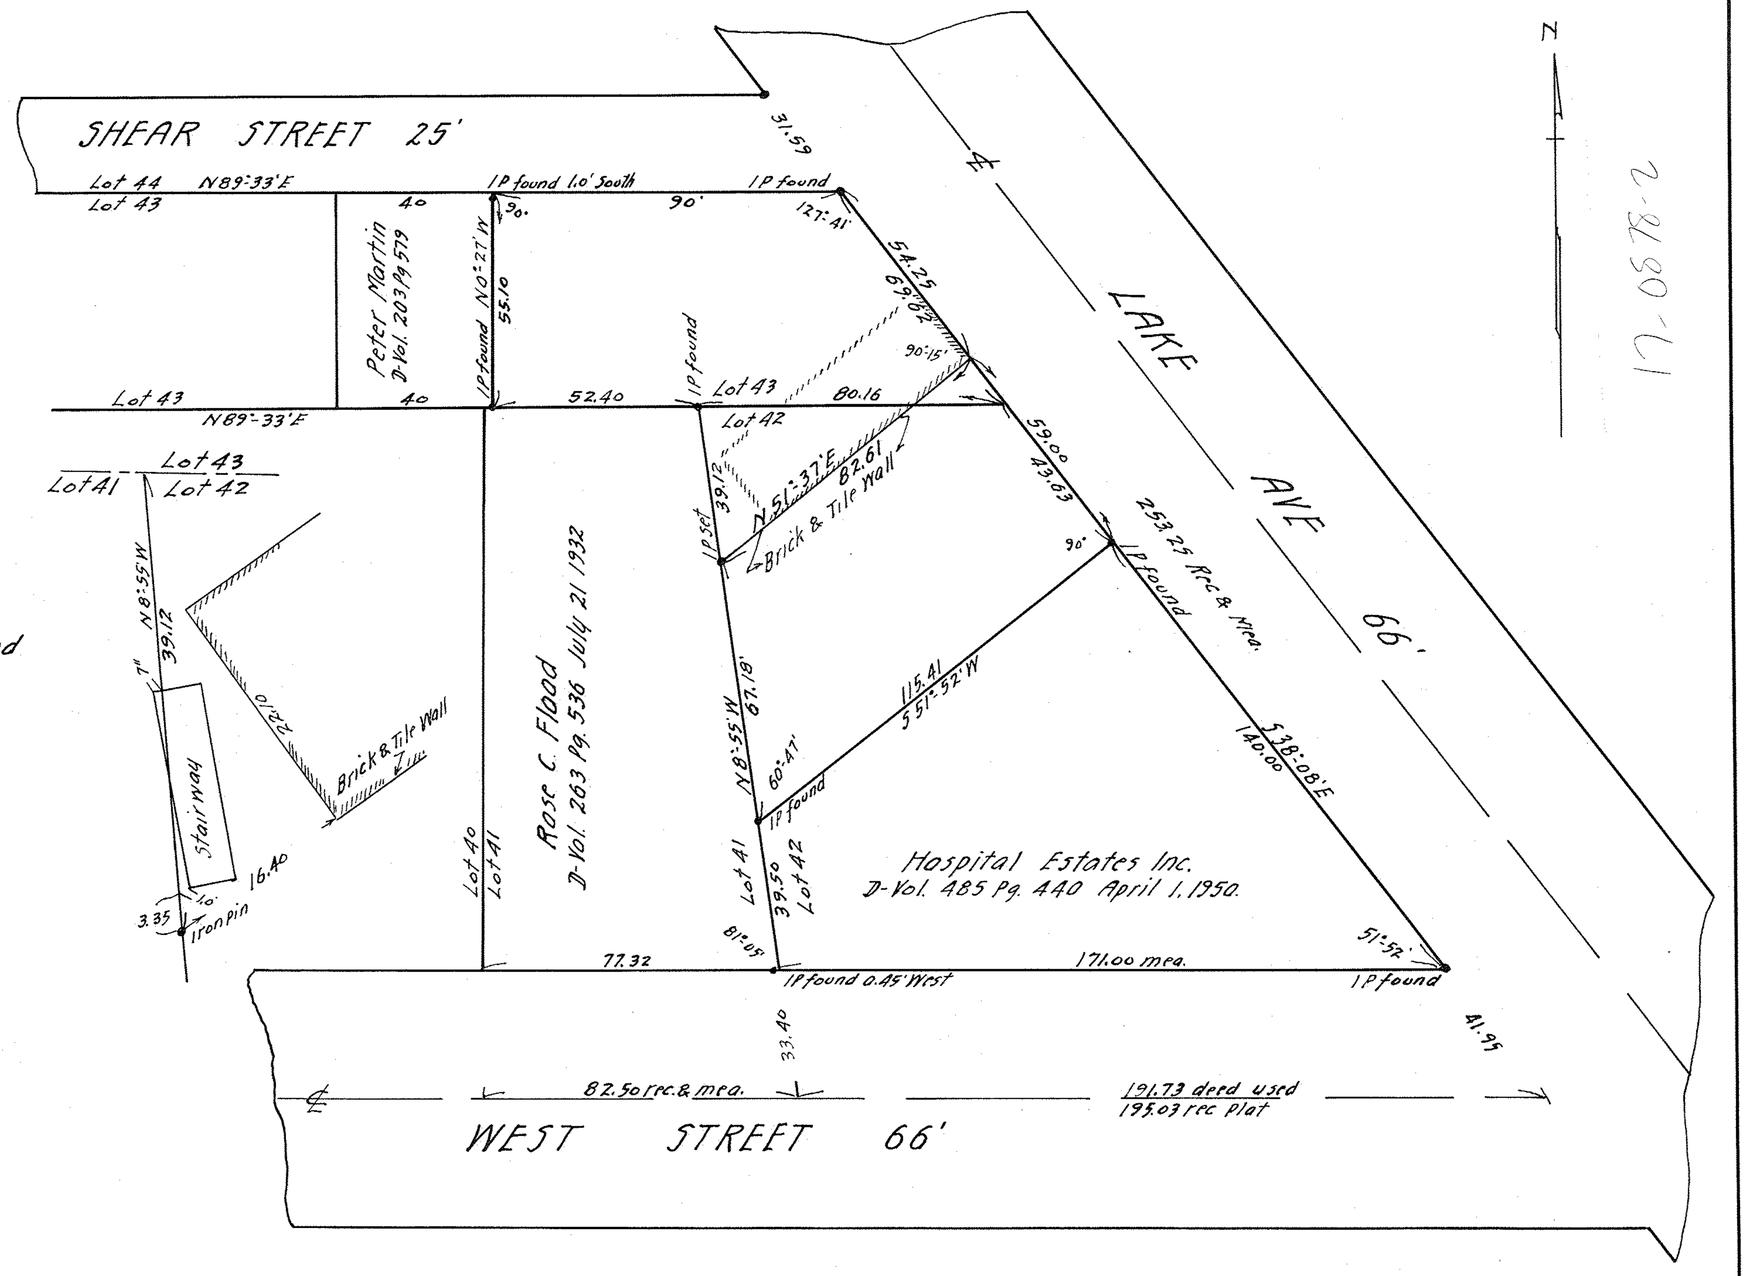

17-878

D.A.