MUNICIPAL ENGINEERING | SUBDIVISIONS | CITY AND FARM SURVEYS

(1)

JOHN W. WARDEN

CIVIL ENGINEER AND SURVEYOR

405 ELYRIA BLOCK

ELYRIA, OHIO

STATE OF OHIO

REGISTERED { PROFESSIONAL ENG. / SURVEYOR

PHONES

BUSINESS 3211

RESIDENCE 38633

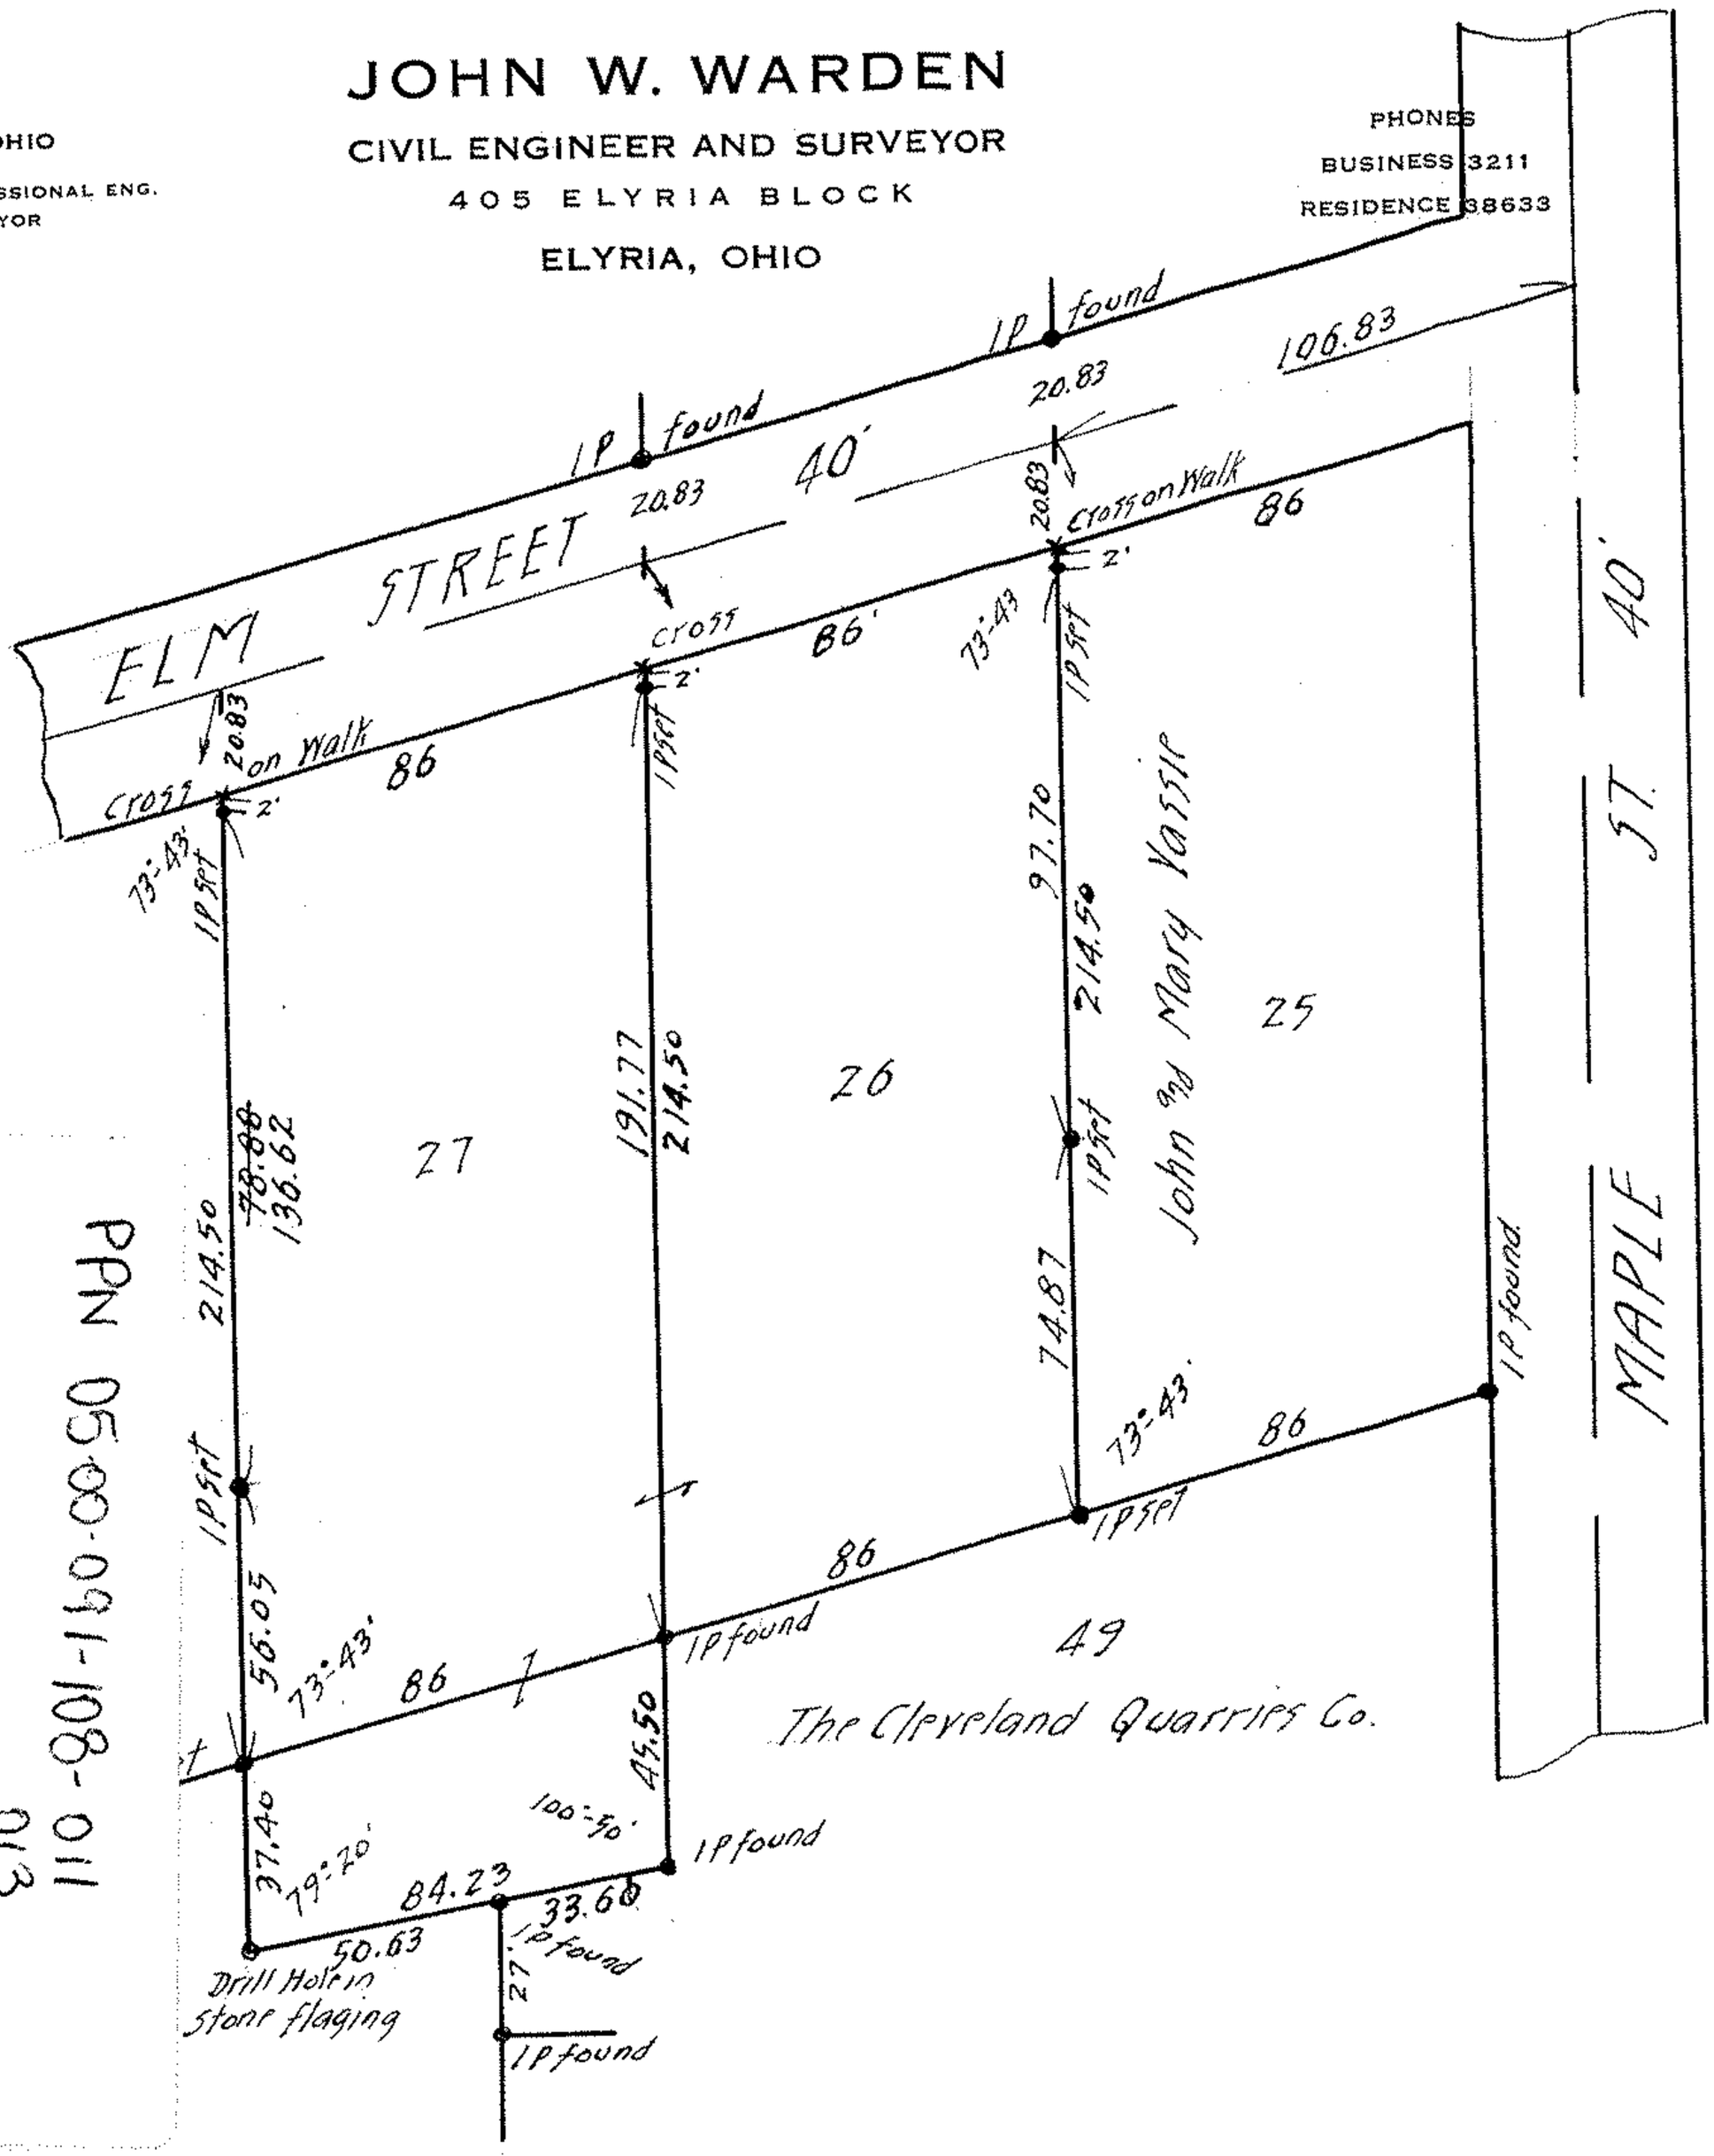

Survey for

ROMULAS and HELEN WILLIS

Lots 26-27 Redferns 2nd Addn. South Amherst Vill.

Original Lot 91 Amherst Township Lorain County O.

Scale 1" = 50' June 29, 1948.