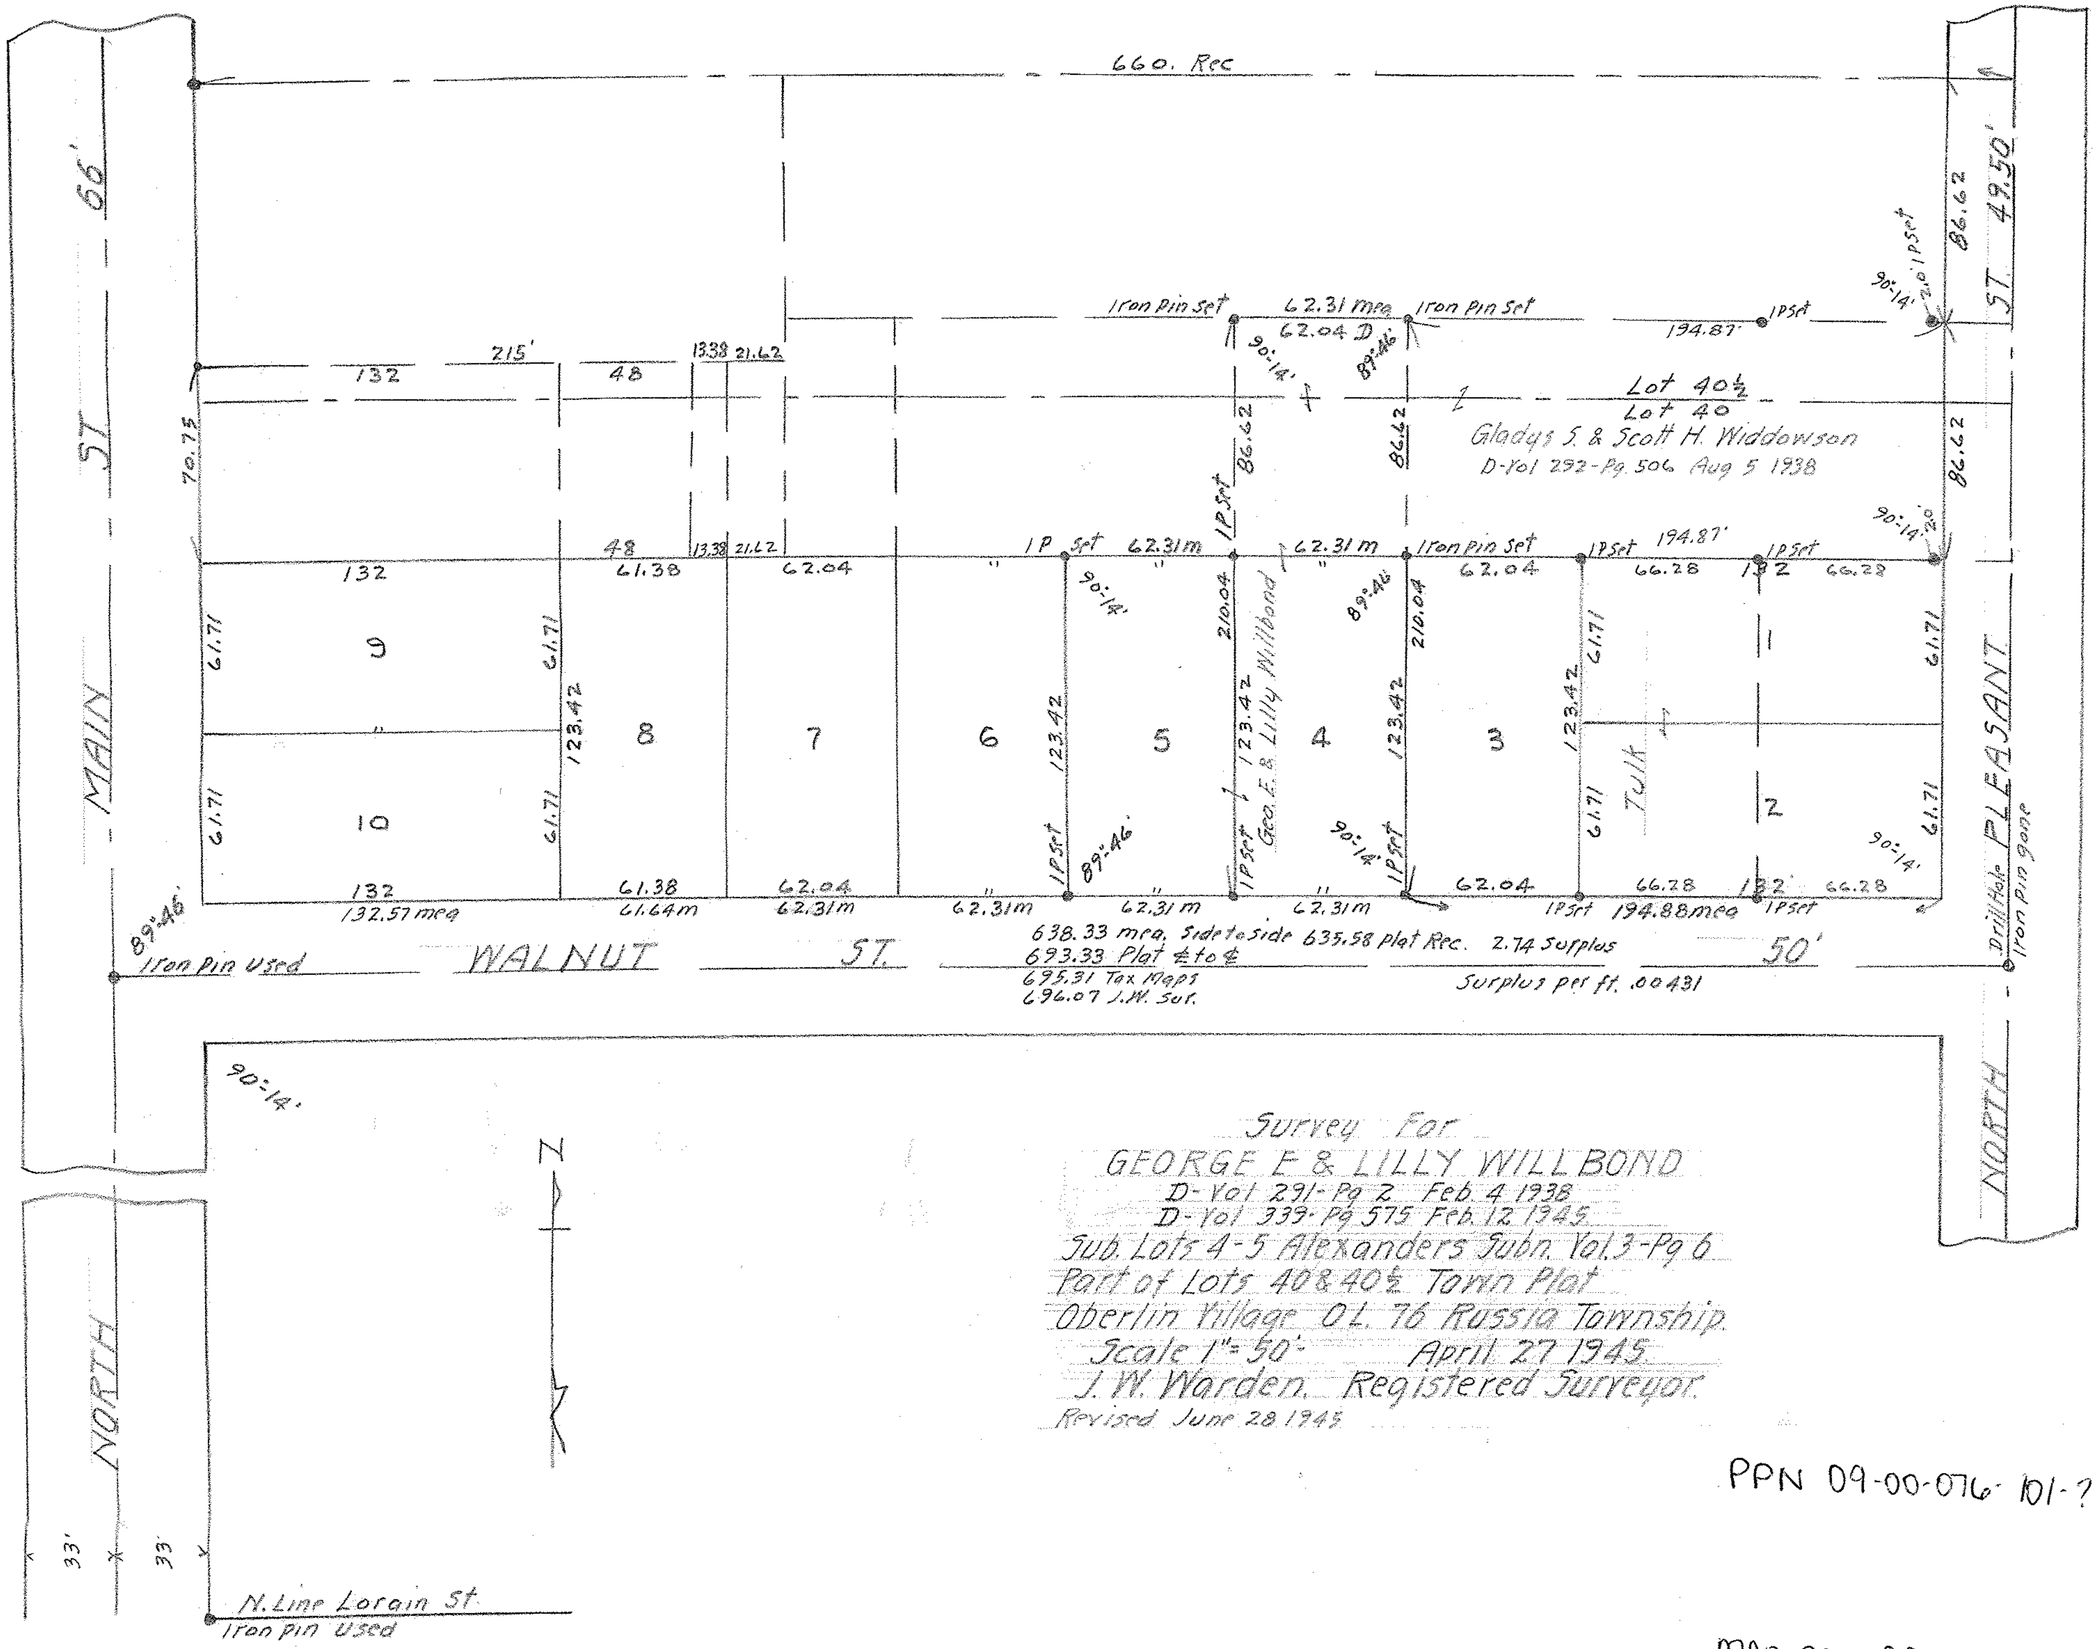

Survey For
GEORGE E & LILLY WILLBOND
D-Vol 291-Pg 2 Feb. 4 1938
D-Vol 339-Pg 575 Feb. 12 1945
Sub. Lots 4-5 Alexanders Subn. Vol. 3-Pg 6
Part of Lots 40 & 40½ Town Plat
Oberlin Village O.L. 76 Russia Township
Scale 1" = 50' April 27 1945
J. W. Warden. Registered Surveyor.
Revised June 28 1945

PPN 09-00-076-101-???

MAP PG 09-00-076-A 44443