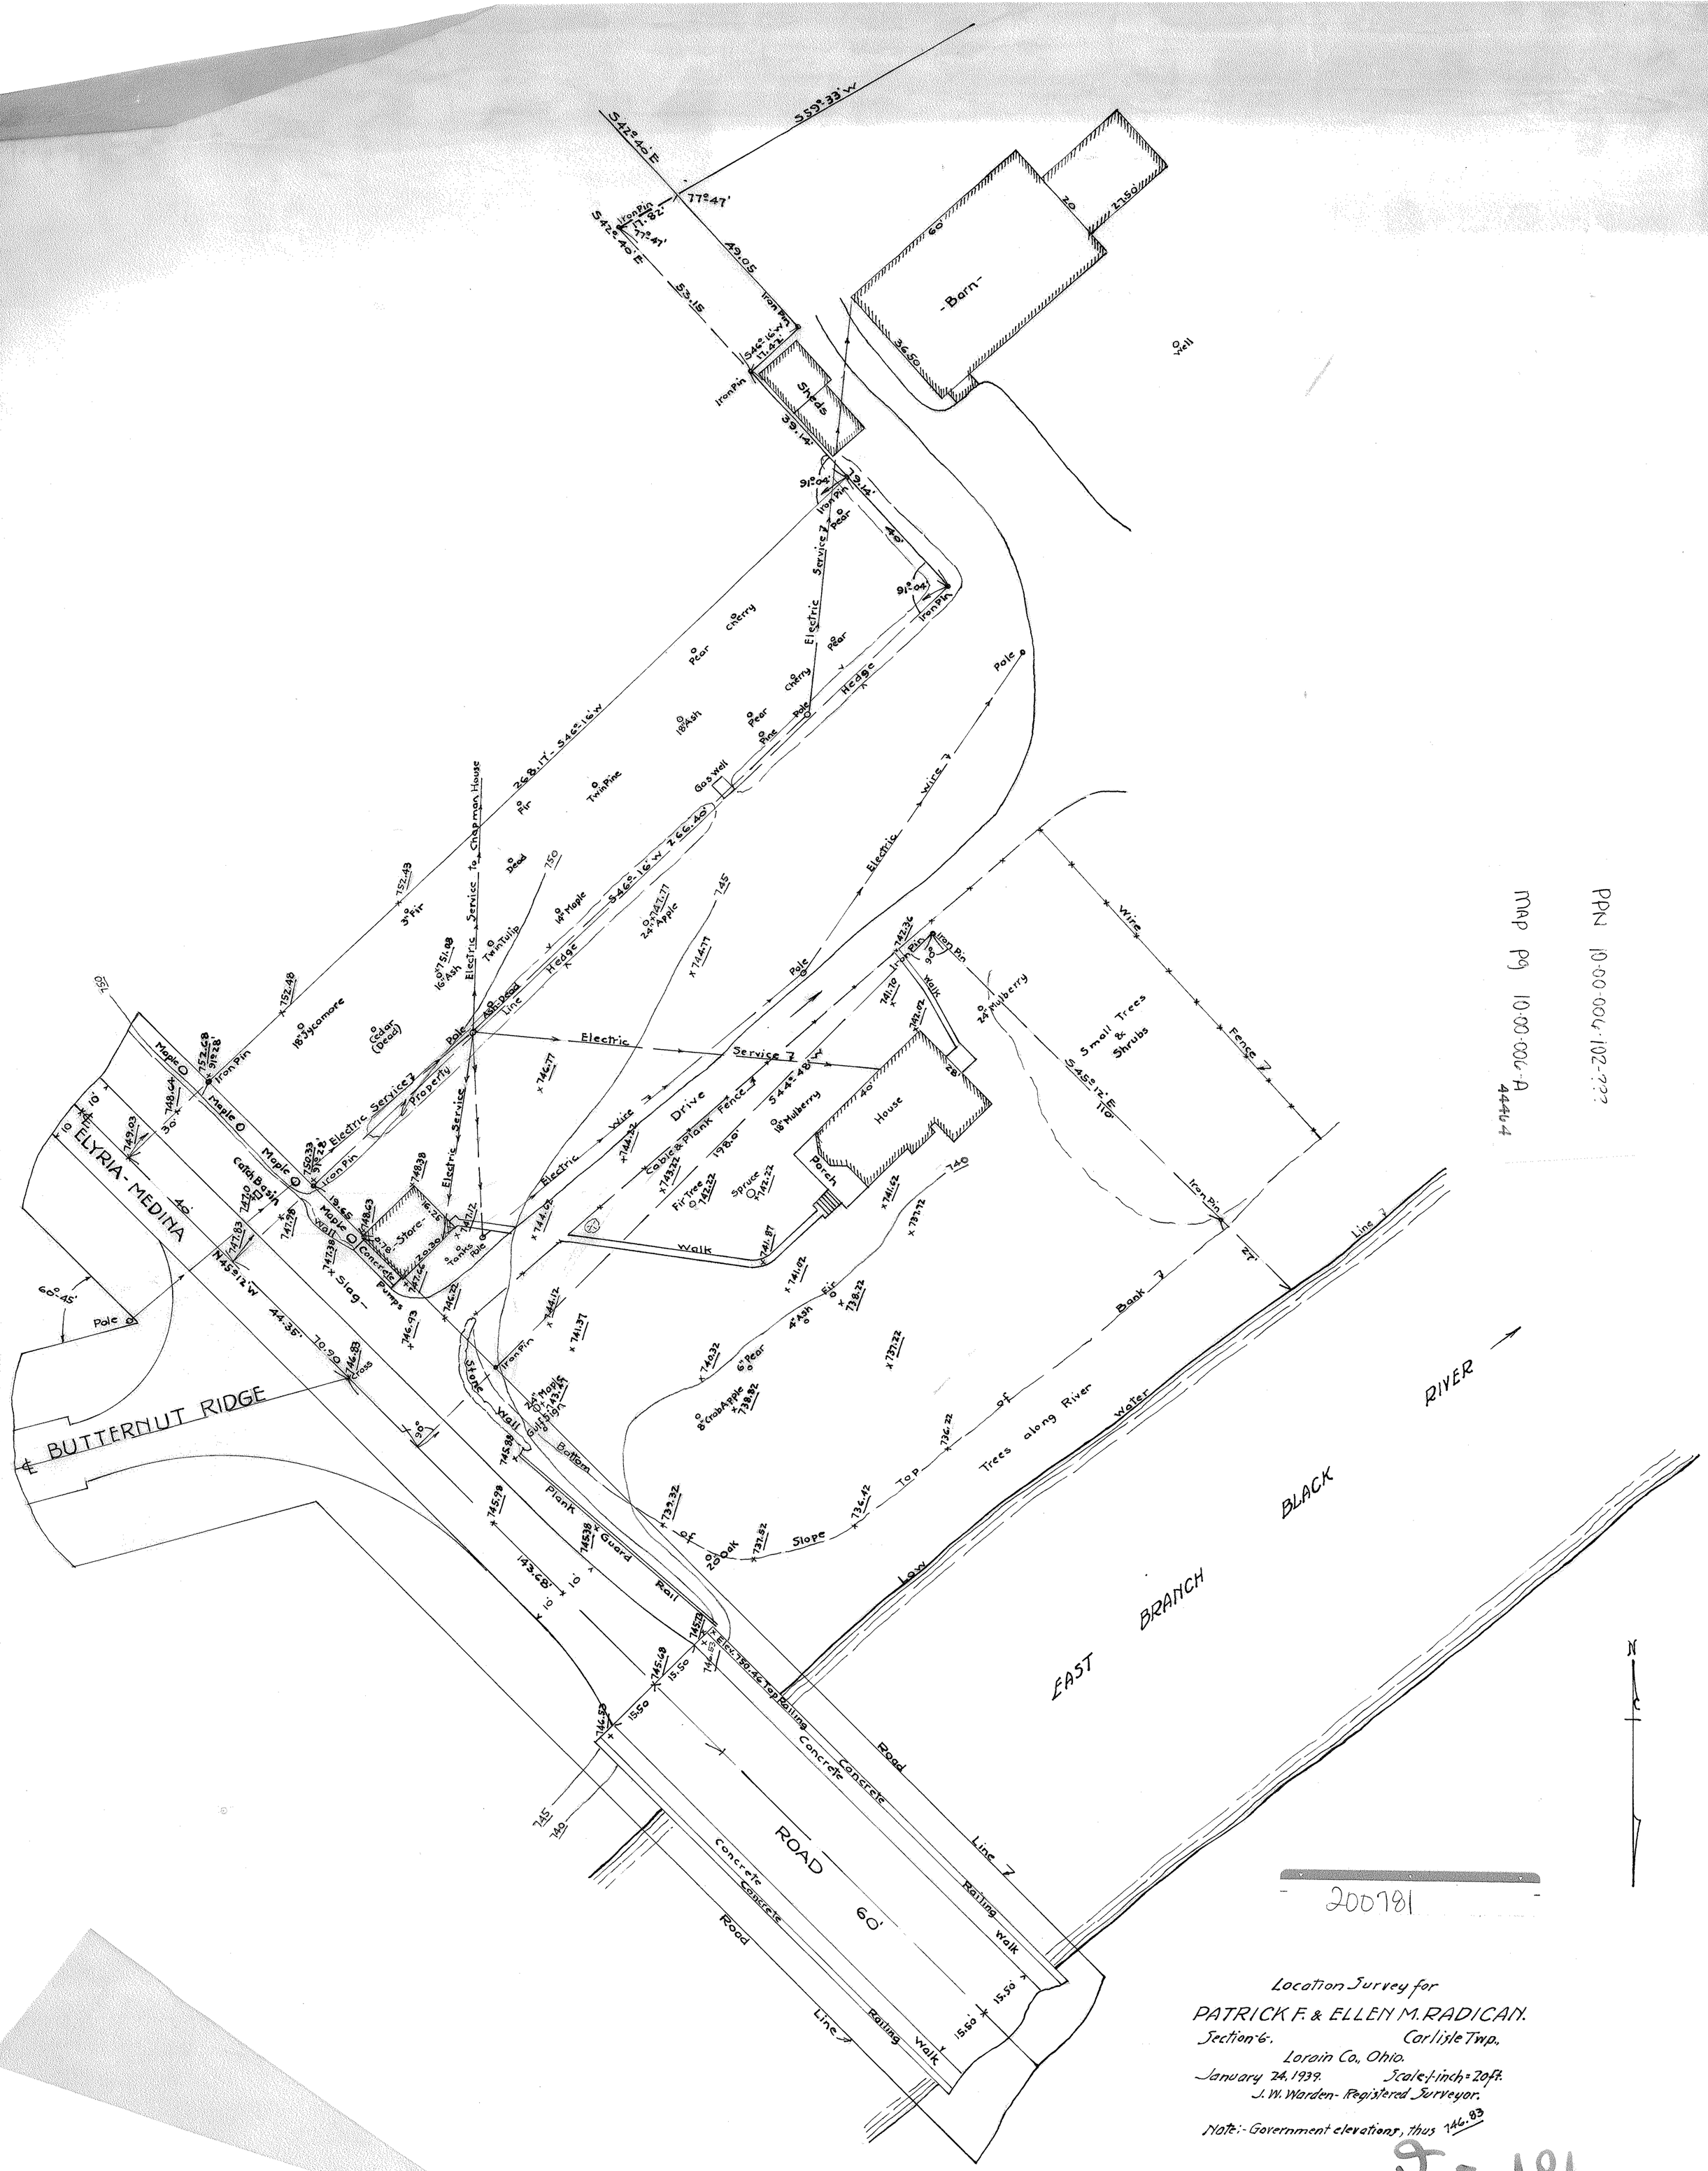
S 42° 40' E
S 53° 33' W
77° 47'
Iron Pin
S 42° 40' E
53.15
49.05
Iron Pin
S 46° 16' W
Iron Pin
Sheds
39.14'
Barn
60'
36.50
20
27.50'
Well
Iron Pin
Service
Electric
Cherry
Pear
Pole
Hedge
Iron Pin
40'
Pine
Gas well
Twin Pine
Fir
Dead
Chapman House
Electric Service to
268.17' - S 46° 16' W
S 46° 16' W 266.40'
Wire
Fence
Small Trees & Shrubs
Mulberry
House
Porch
Drive
Cable & Plank Fence
198.0'
Fir Tree
Spruce
Walk
Property
Line
Maple
Iron Pin
Catch Basin
Store
Concrete
Tanks
Pumps
Slag
ELYRIA - MEDINA
BUTTERNUT RIDGE
N 45° 12' W
44.35'
70.90
Cross
Stone Wall
Bottom
Top
Slope
Trees along River
Water
Bank
Line
RIVER
BLACK
EAST BRANCH
Low
Plank Guard Rail
Elev. 750.46 Top Railing
Concrete
Road
ROAD
60'
15.50'
Railing
Walk
Line
Map Pg 10-00-006-A
44464
PPN 10-00-006-102-22
200781
Location Survey for
PATRICK F. & ELLEN M. RADICAN.
Section 6. Carlisle Twp.,
Lorain Co., Ohio.
January 24, 1939. Scale: 1 inch = 20 ft.
J. W. Warden - Registered Surveyor.
Note:- Government elevations, thus 746.83
9-181