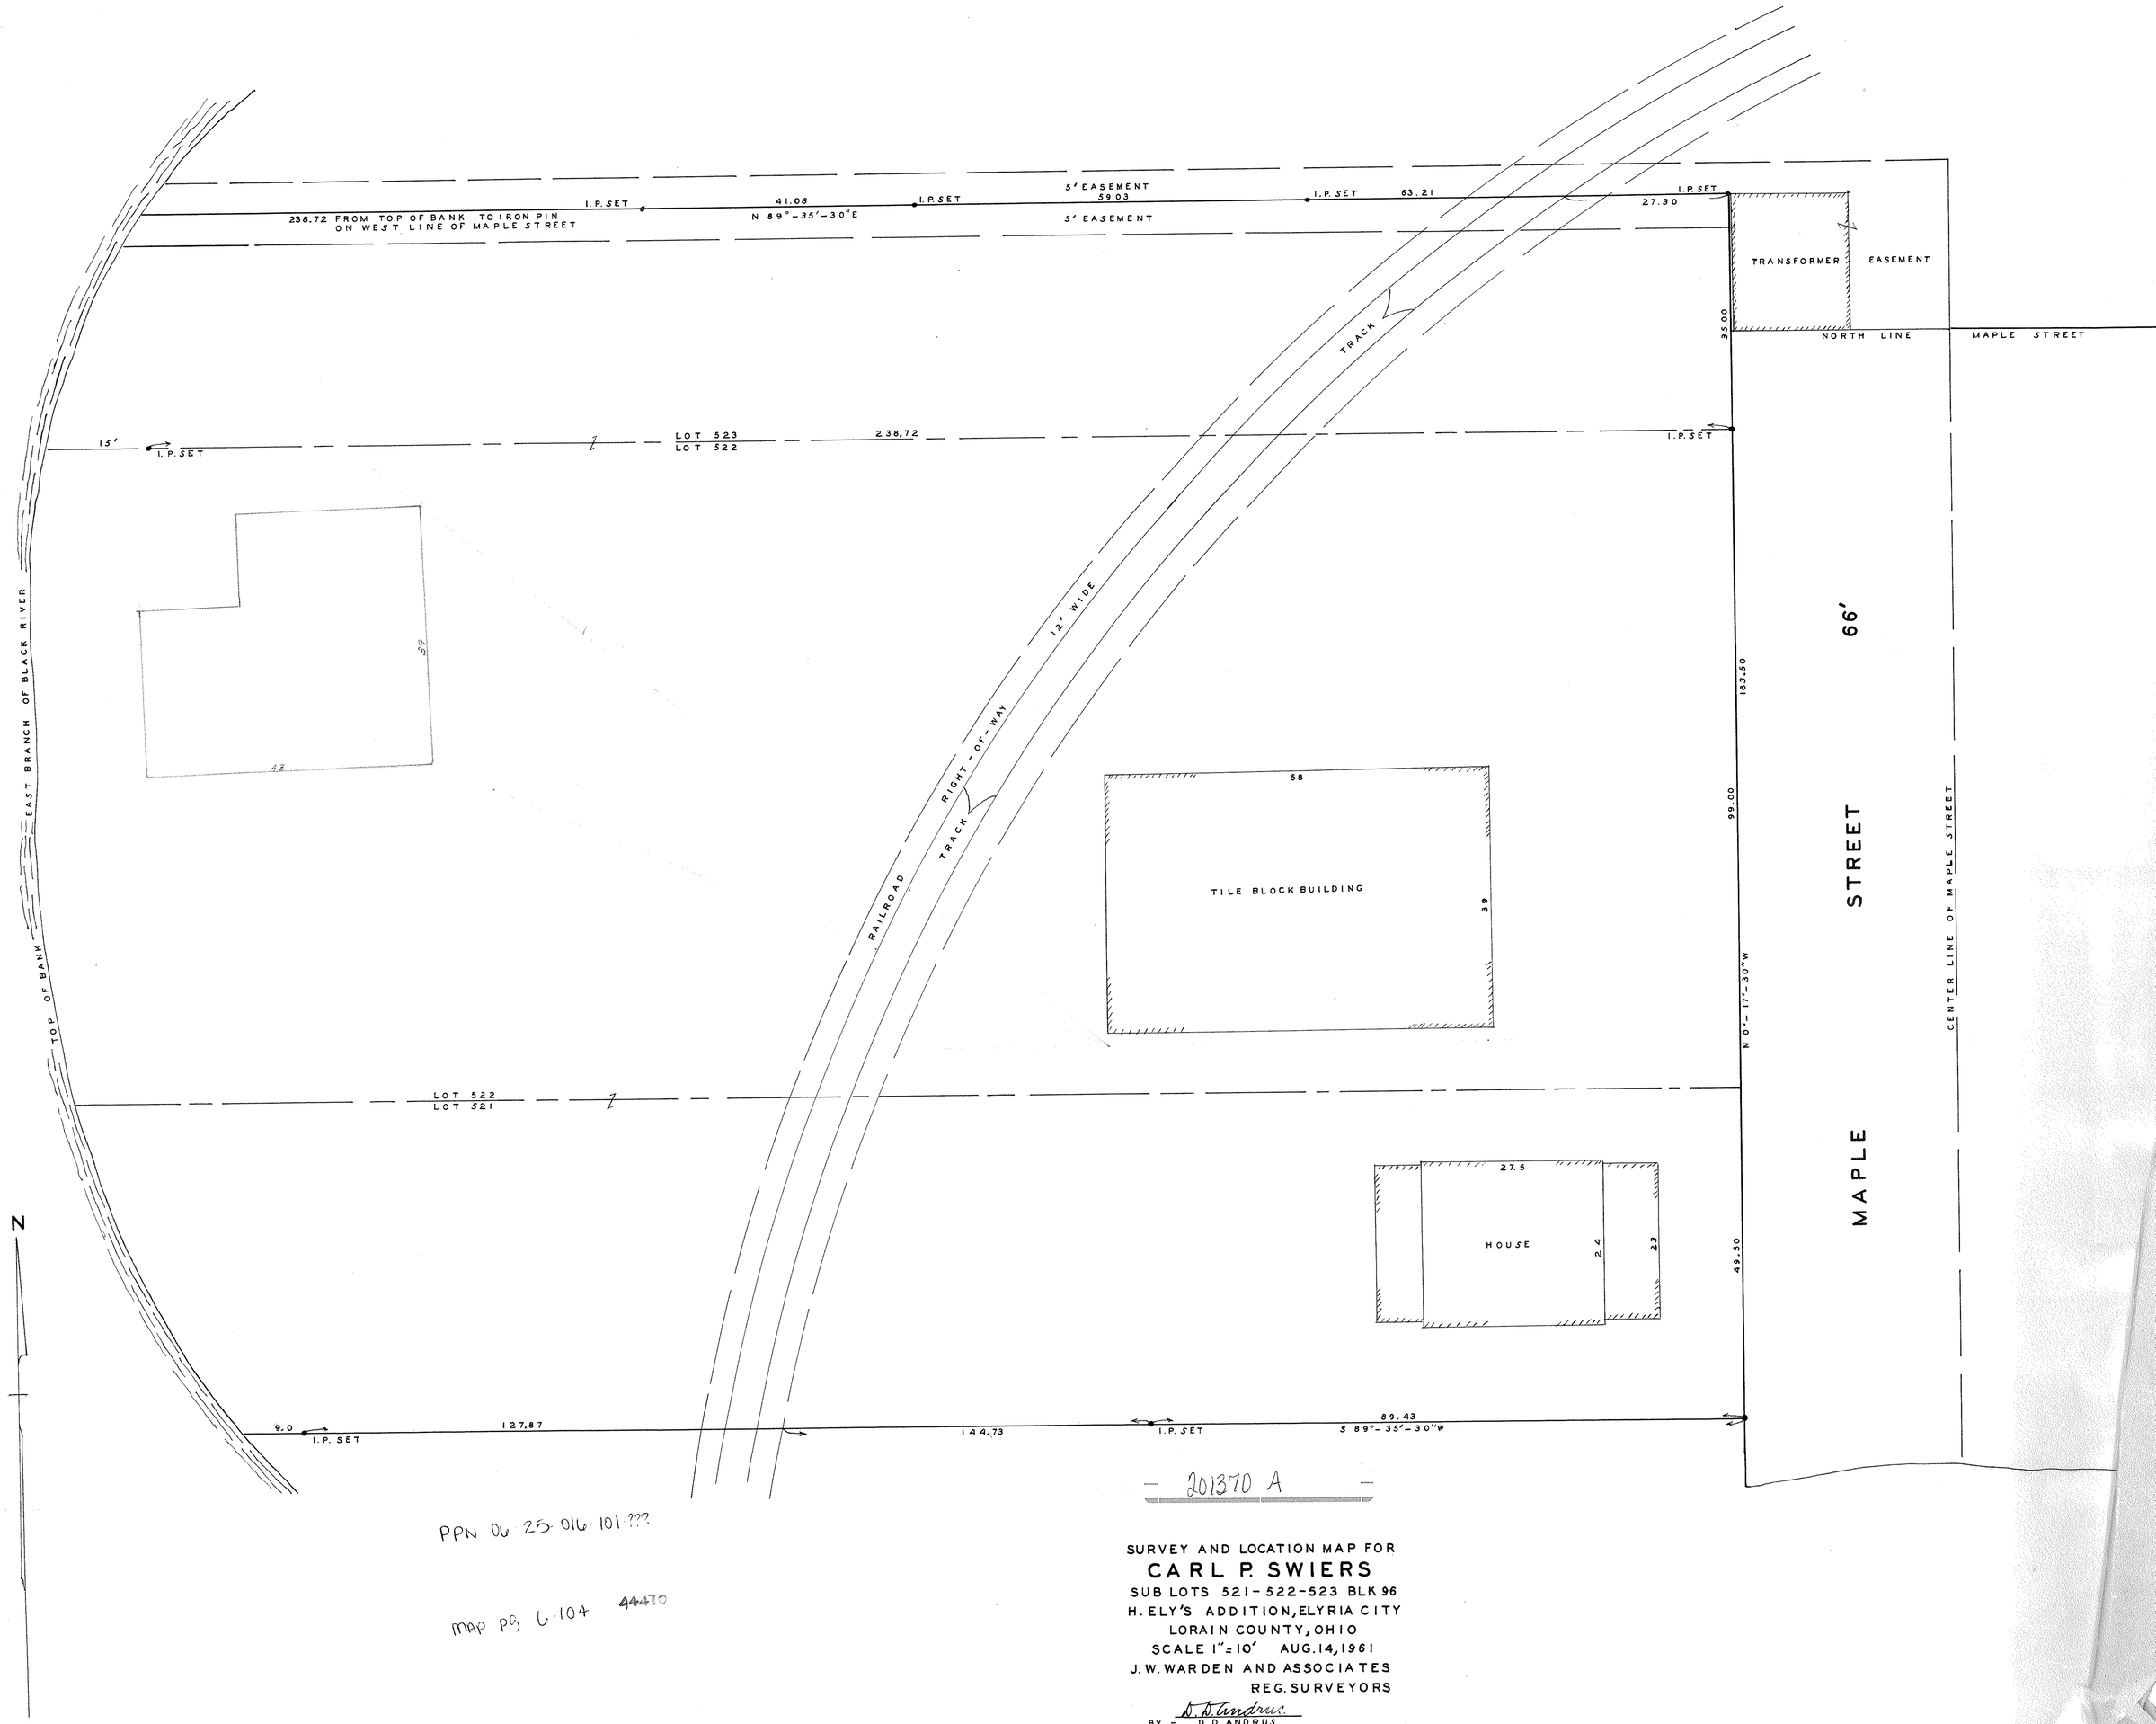

201370 A

PPN 06-25-016-101.???

MAP PG 6-104 44470

SURVEY AND LOCATION MAP FOR

CARL P. SWIERS

SUB LOTS 521-522-523 BLK 96
H. ELY'S ADDITION, ELYRIA CITY
LORAIN COUNTY, OHIO
SCALE 1" = 10' AUG. 14, 1961
J. W. WARDEN AND ASSOCIATES
REG. SURVEYORS

BY - D. D. Andrus
D. D. ANDRUS