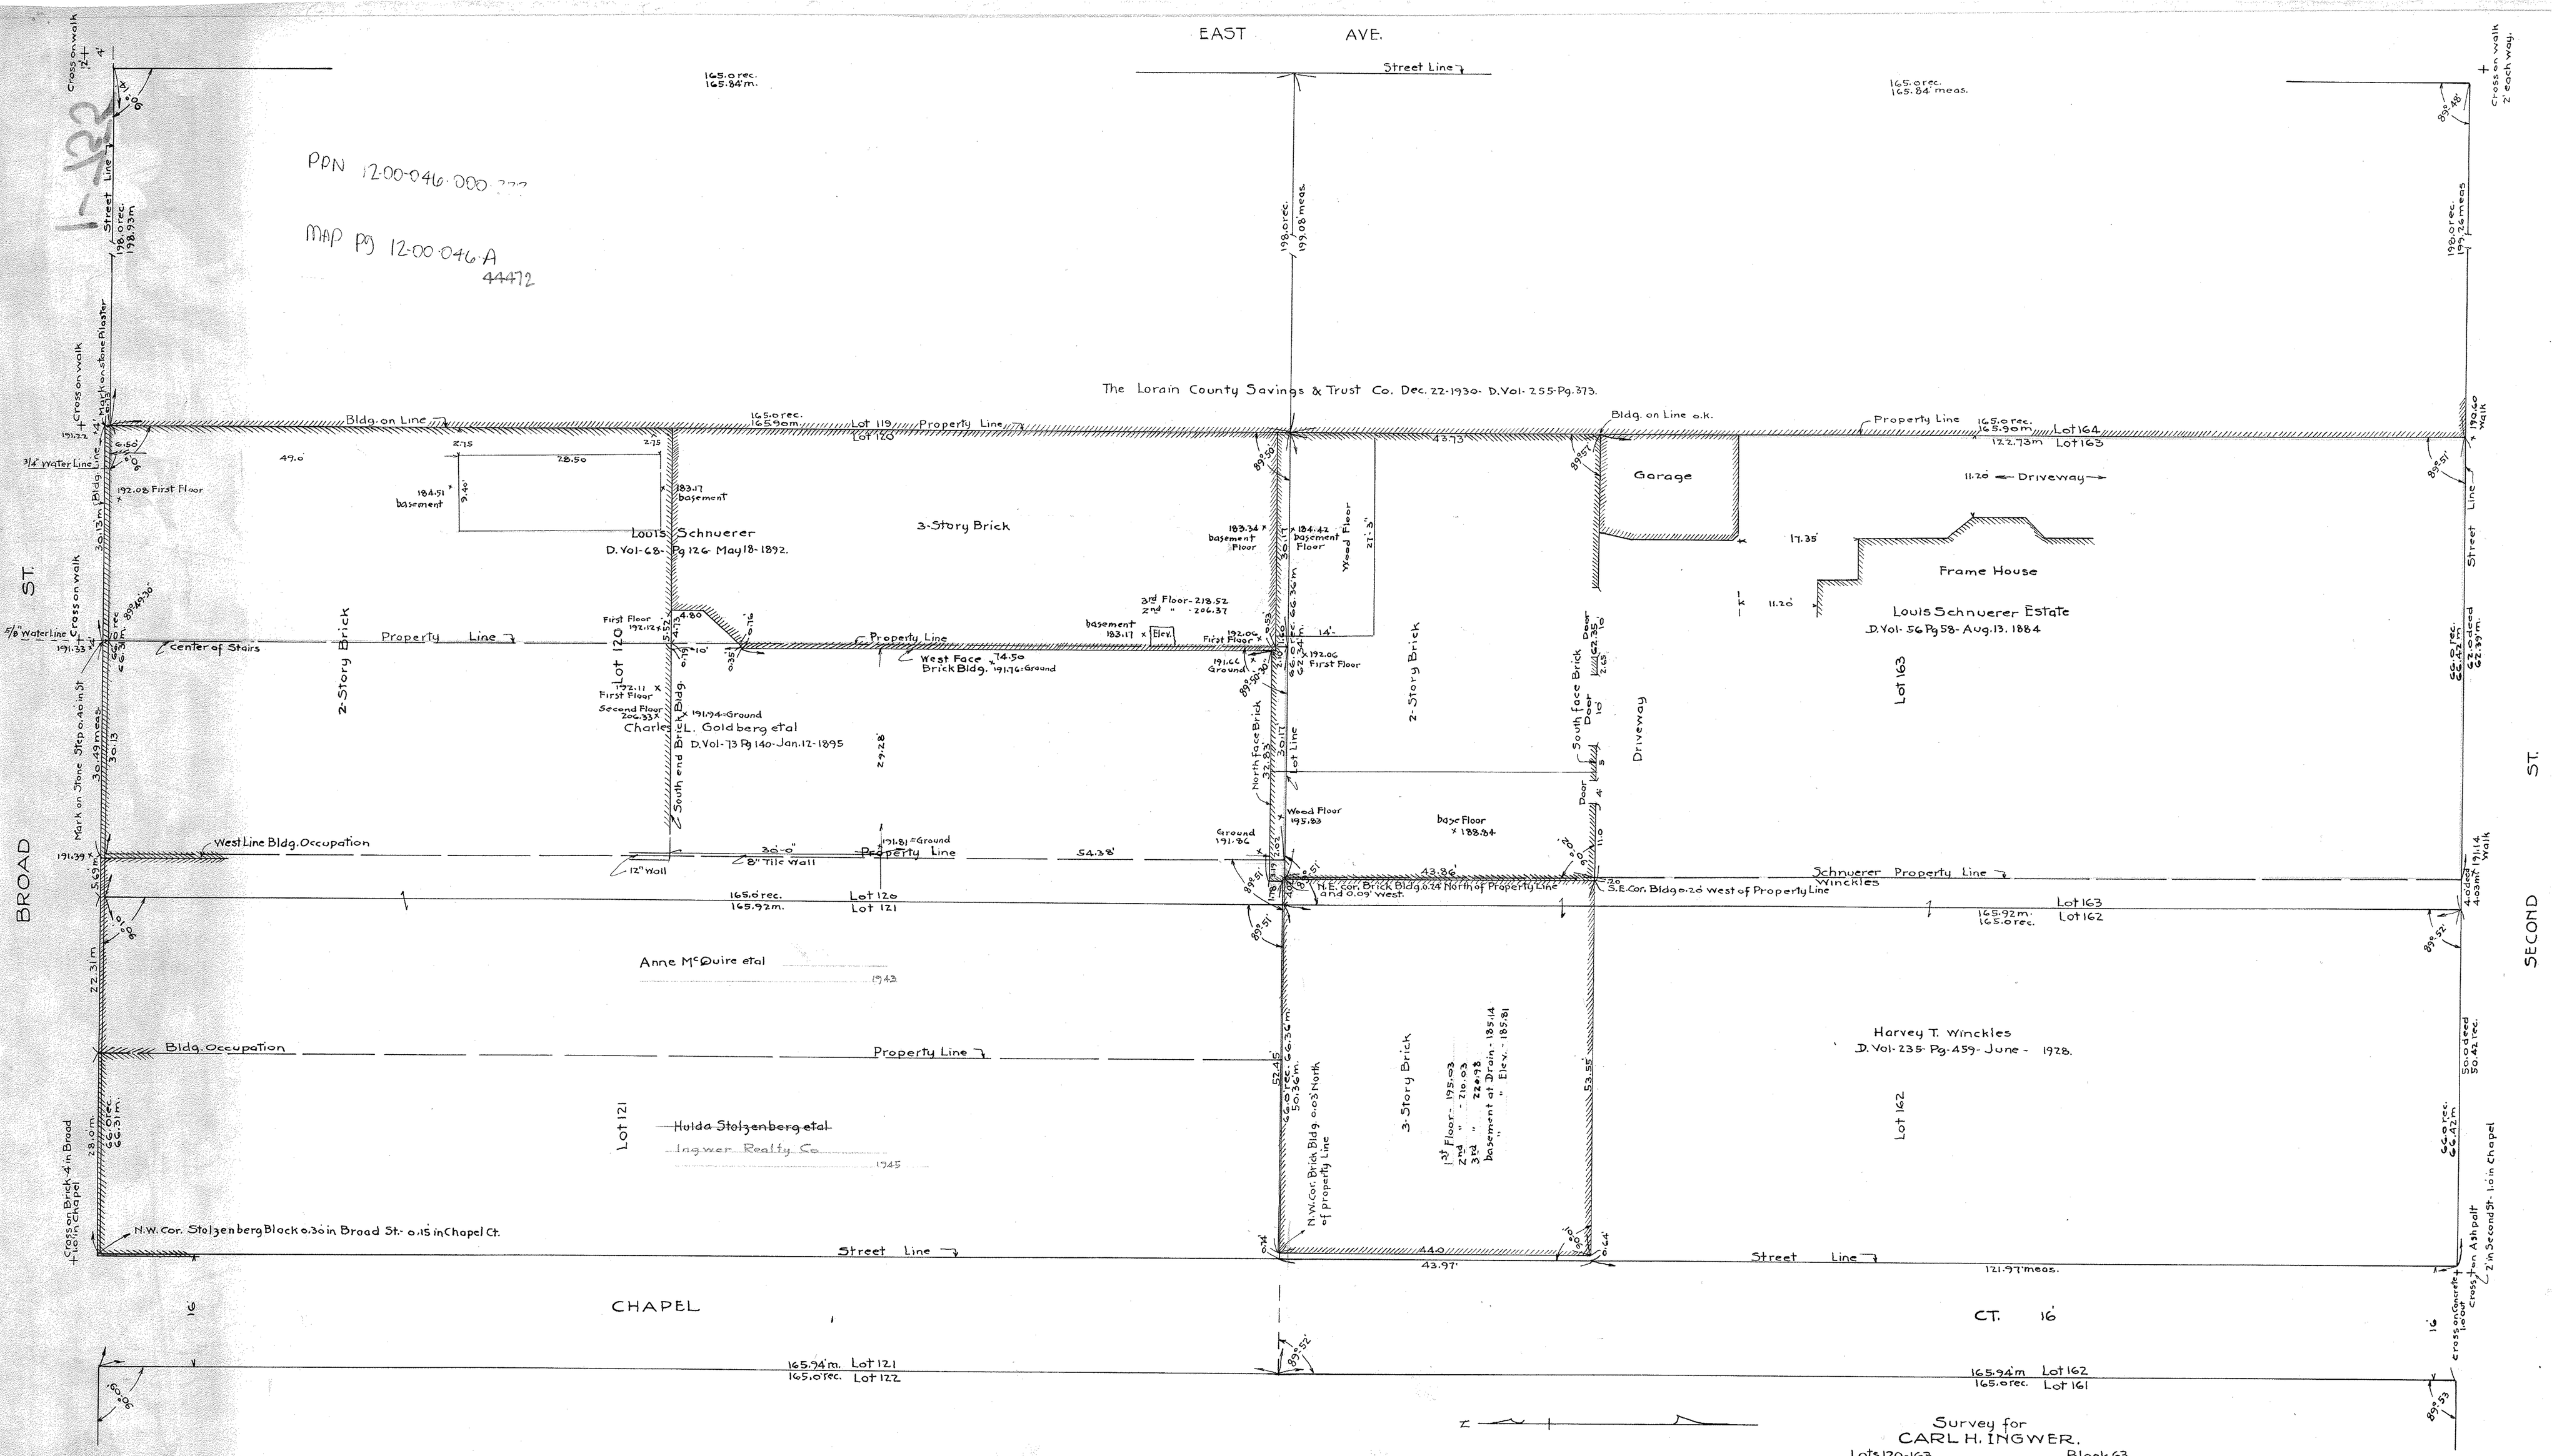
EAST AVE.
BROAD ST.
SECOND ST.
CHAPEL CT.
PPN 12-00-046-000-???
MAP Pg 12-00-046-A
44472
The Lorain County Savings & Trust Co. Dec. 22-1930- D.Vol-255-Pg.373.
Louis Schnuerer
D.Vol-68-Pg 126 May 18-1892.
3-Story Brick
2-Story Brick
Charles L. Goldberg etal
D.Vol-73 Pg 140-Jan.12-1895
Garage
Frame House
Louis Schnuerer Estate
D.Vol-56 Pg 58-Aug.13.1884
Driveway
Lot 163
Schnuerer Property Line
Winckles
Harvey T. Winckles
D.Vol-235-Pg-459-June - 1928.
Lot 162
Anne McQuire etal
1943
Bldg. Occupation
Property Line
Lot 121
~~Hulda Stolzenberg etal~~
Ingwer Realty Co
1945
N.W. Cor. Stolzenberg Block 0.30 in Broad St. - 0.15 in Chapel Ct.
Street Line
Survey for
CARL H. INGWER.
Lots 120-163, Block 63,
Original Village Plat of Elyria,
Map Vol.- 3- Page 14,
Elyria, Lorain Co., Ohio.
Jan. 6-1938. Scale 1" = 10 feet.
J.W. Warden. Registered Surveyor.

100755 D